



5-9-07

PROFILE & DECK PLAN.
STEEL SCREW TRAWLER.

No 423.

SCALE $\frac{1}{4}$ " = ONE FOOT.

DIM: 125'-0" x 22'-0" x 12'-6" MLD

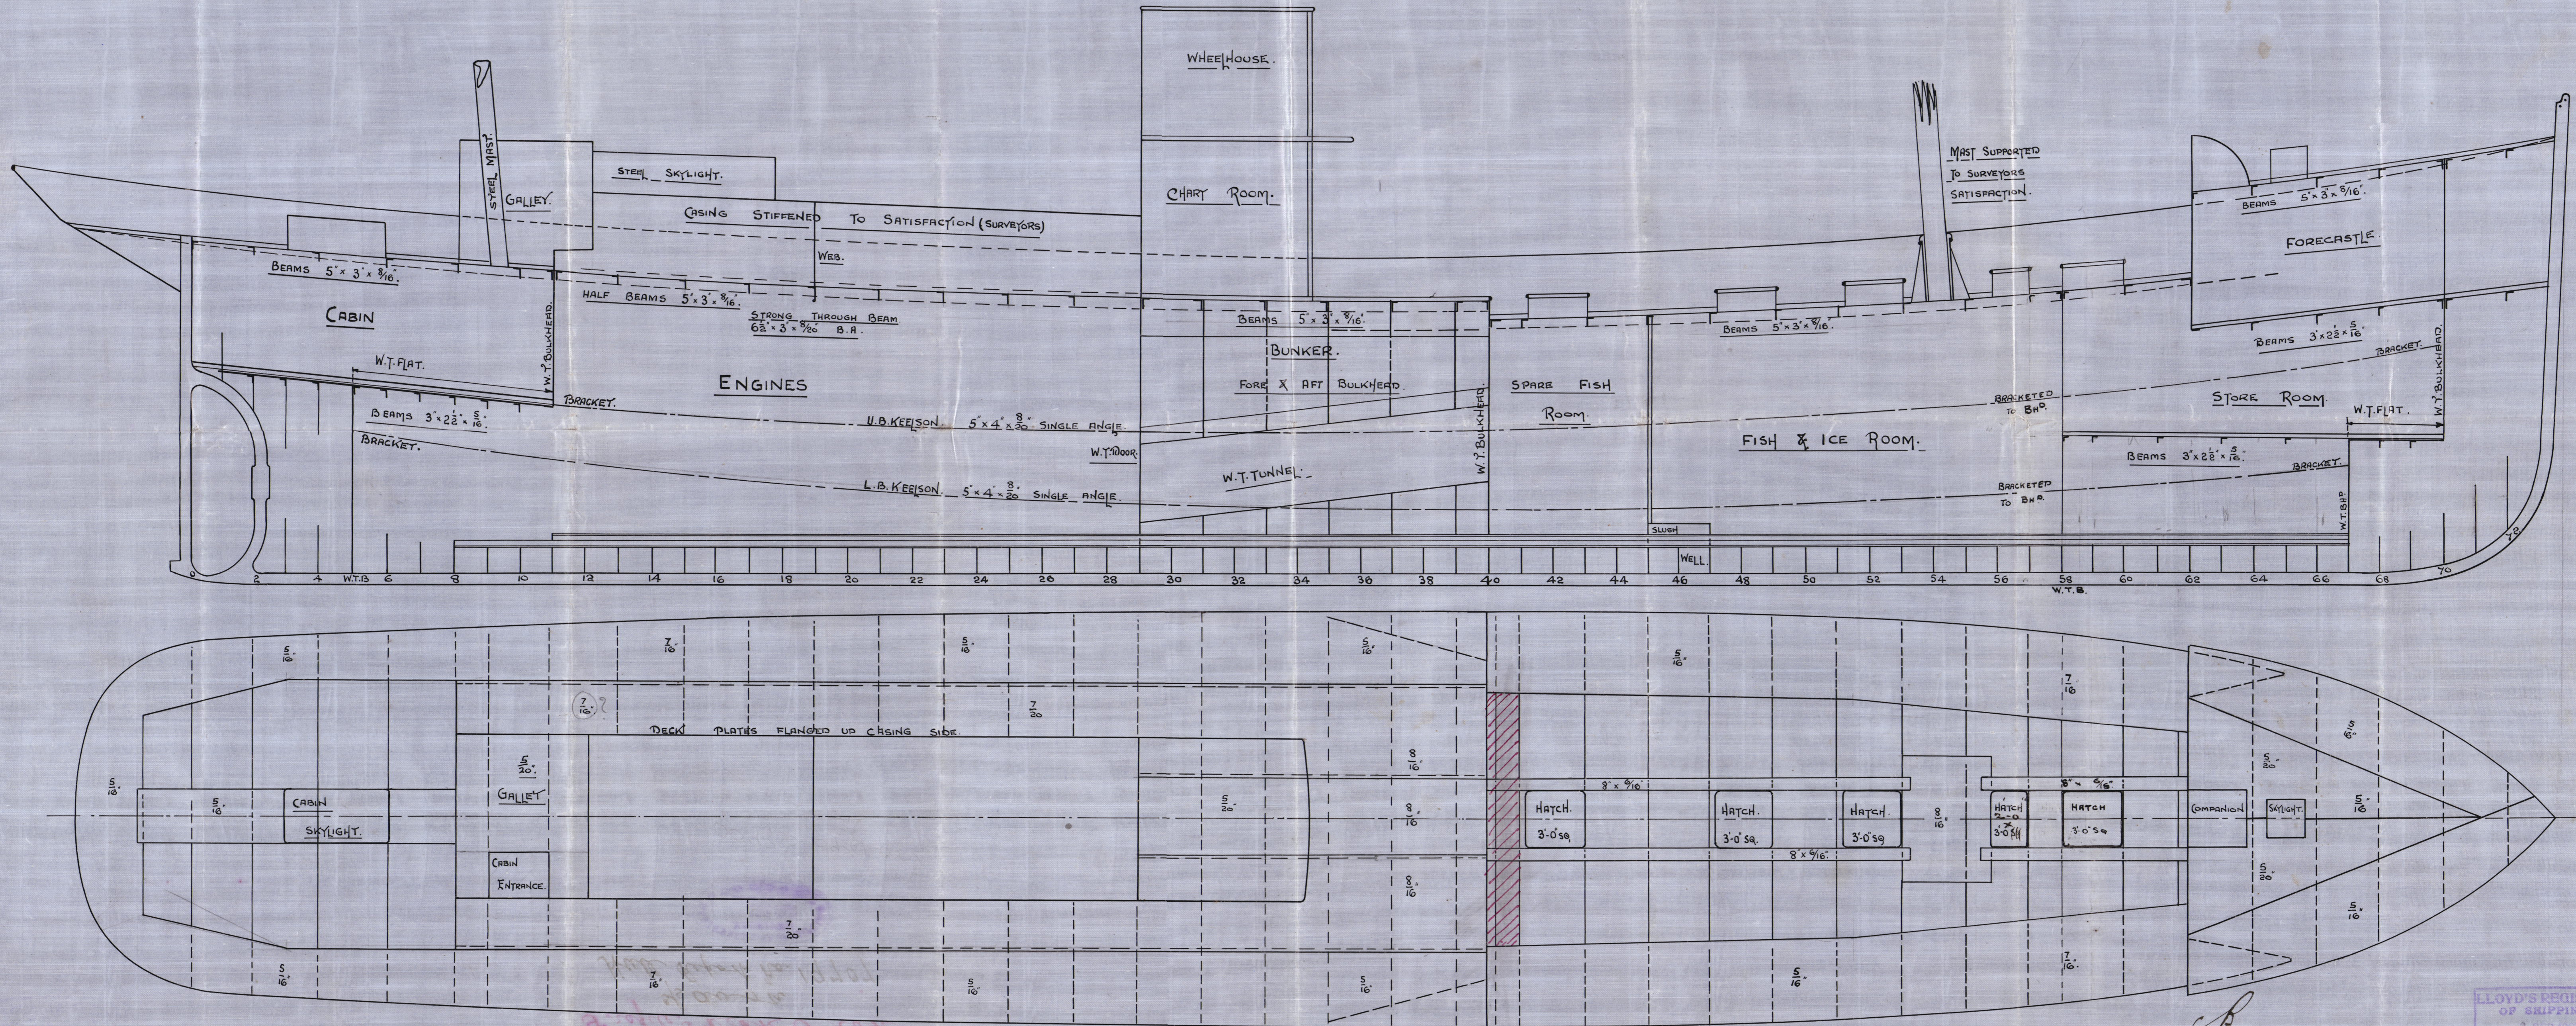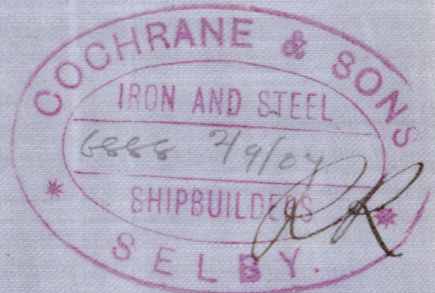

PILLARS THROUGHOUT TO SURVEYORS SATISFACTION.

C.P.
4.9.07

LLOYD'S REGISTER
OF SHIPPING
3 SEP 1907
* HULL *


Cochrane & Son

No 423


Profile & Deck Plan

3/4 av on

Hull Report No. 19707

 

009350-009361-0000

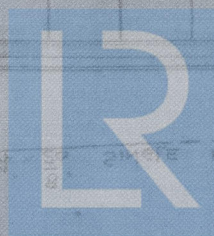

© 2021

Lloyd's Register
Foundation