

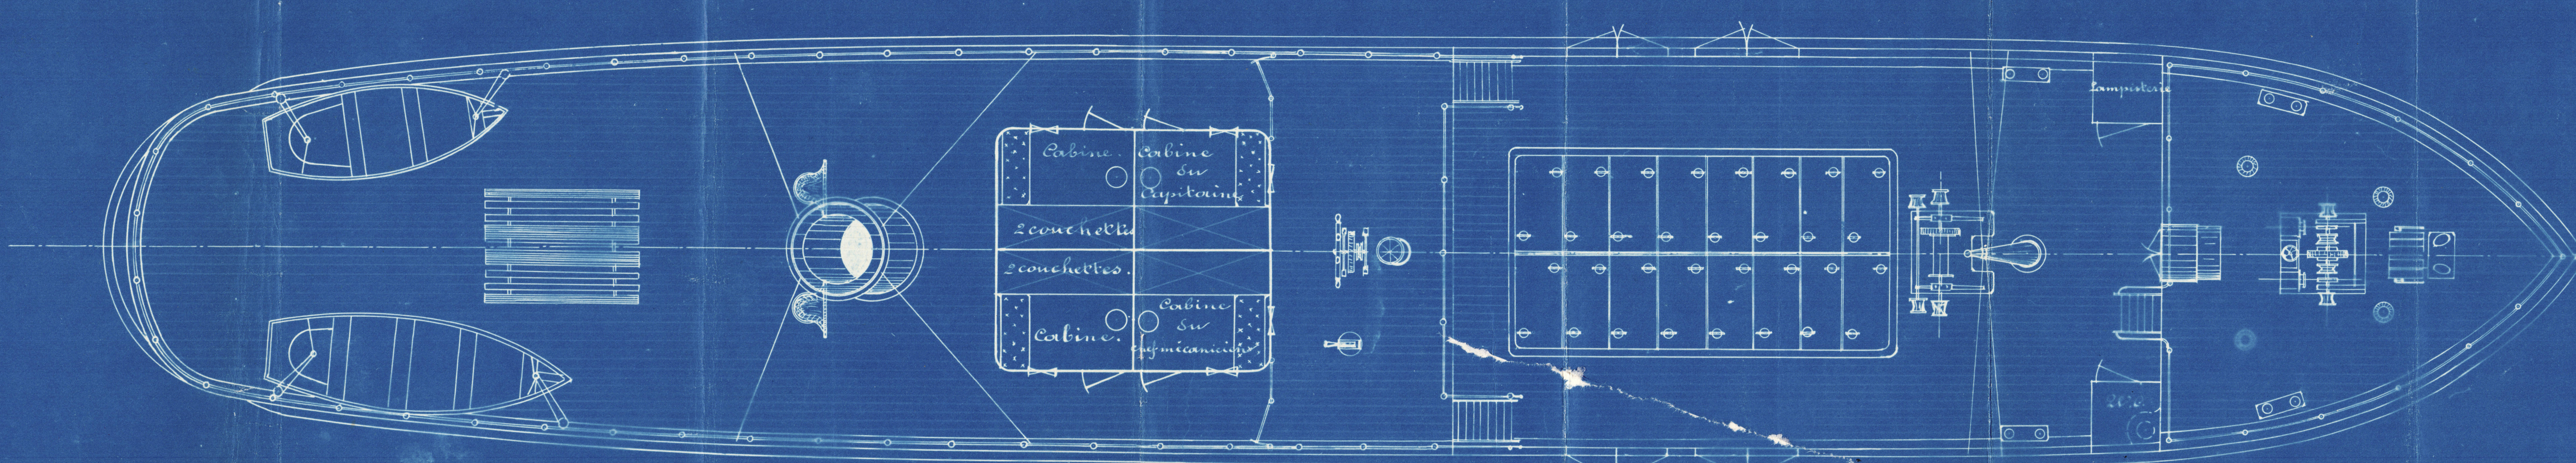
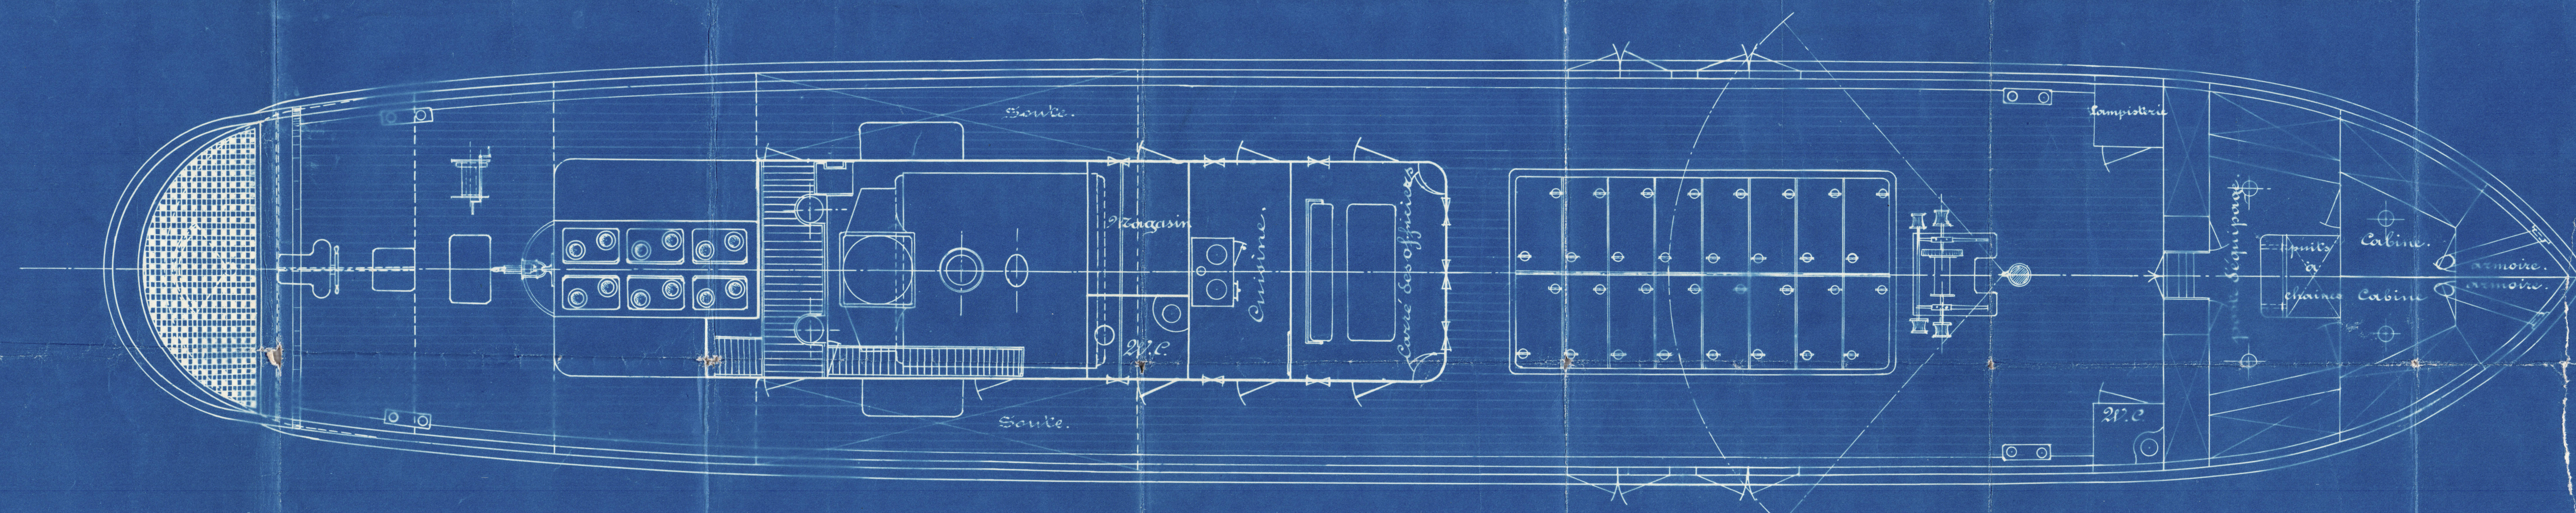


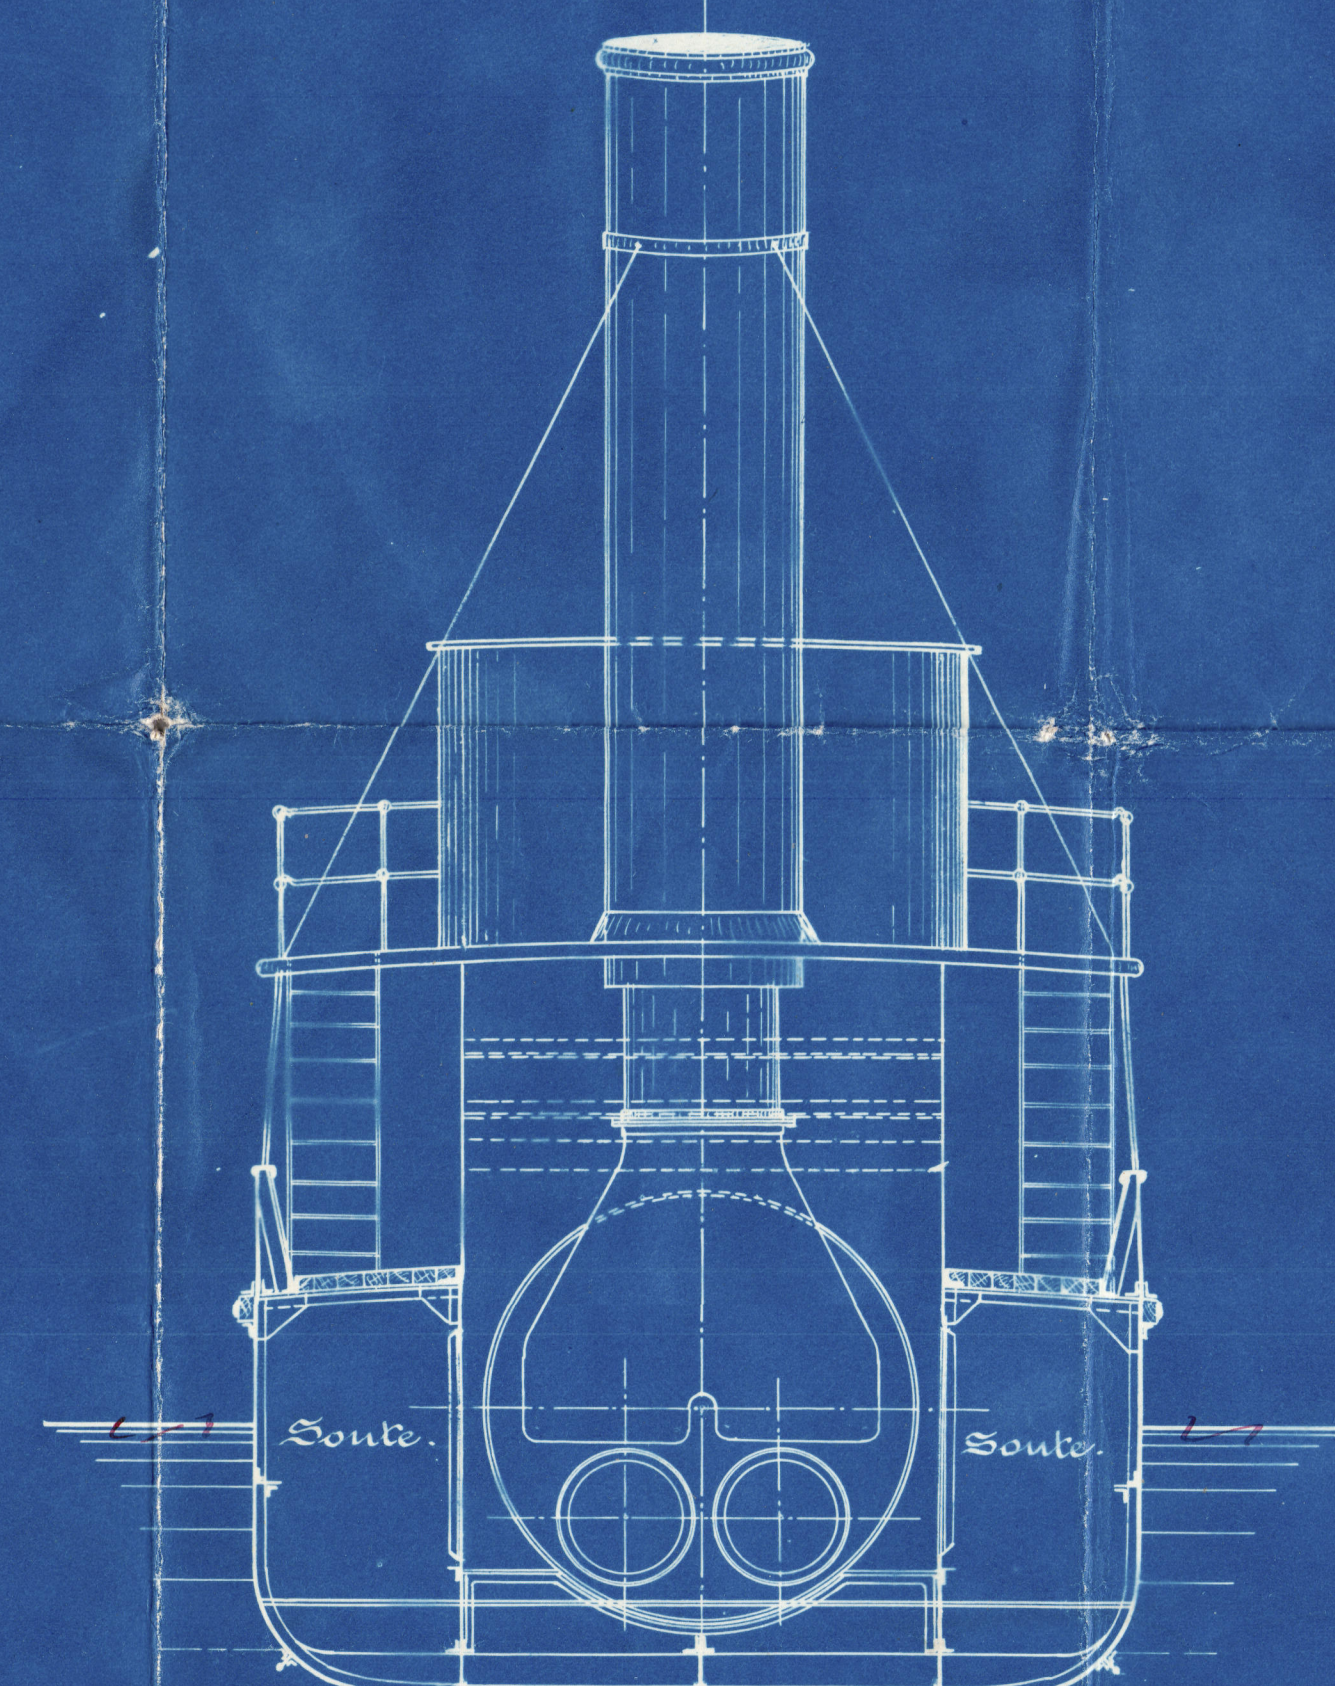

30.3.11
11.4.11

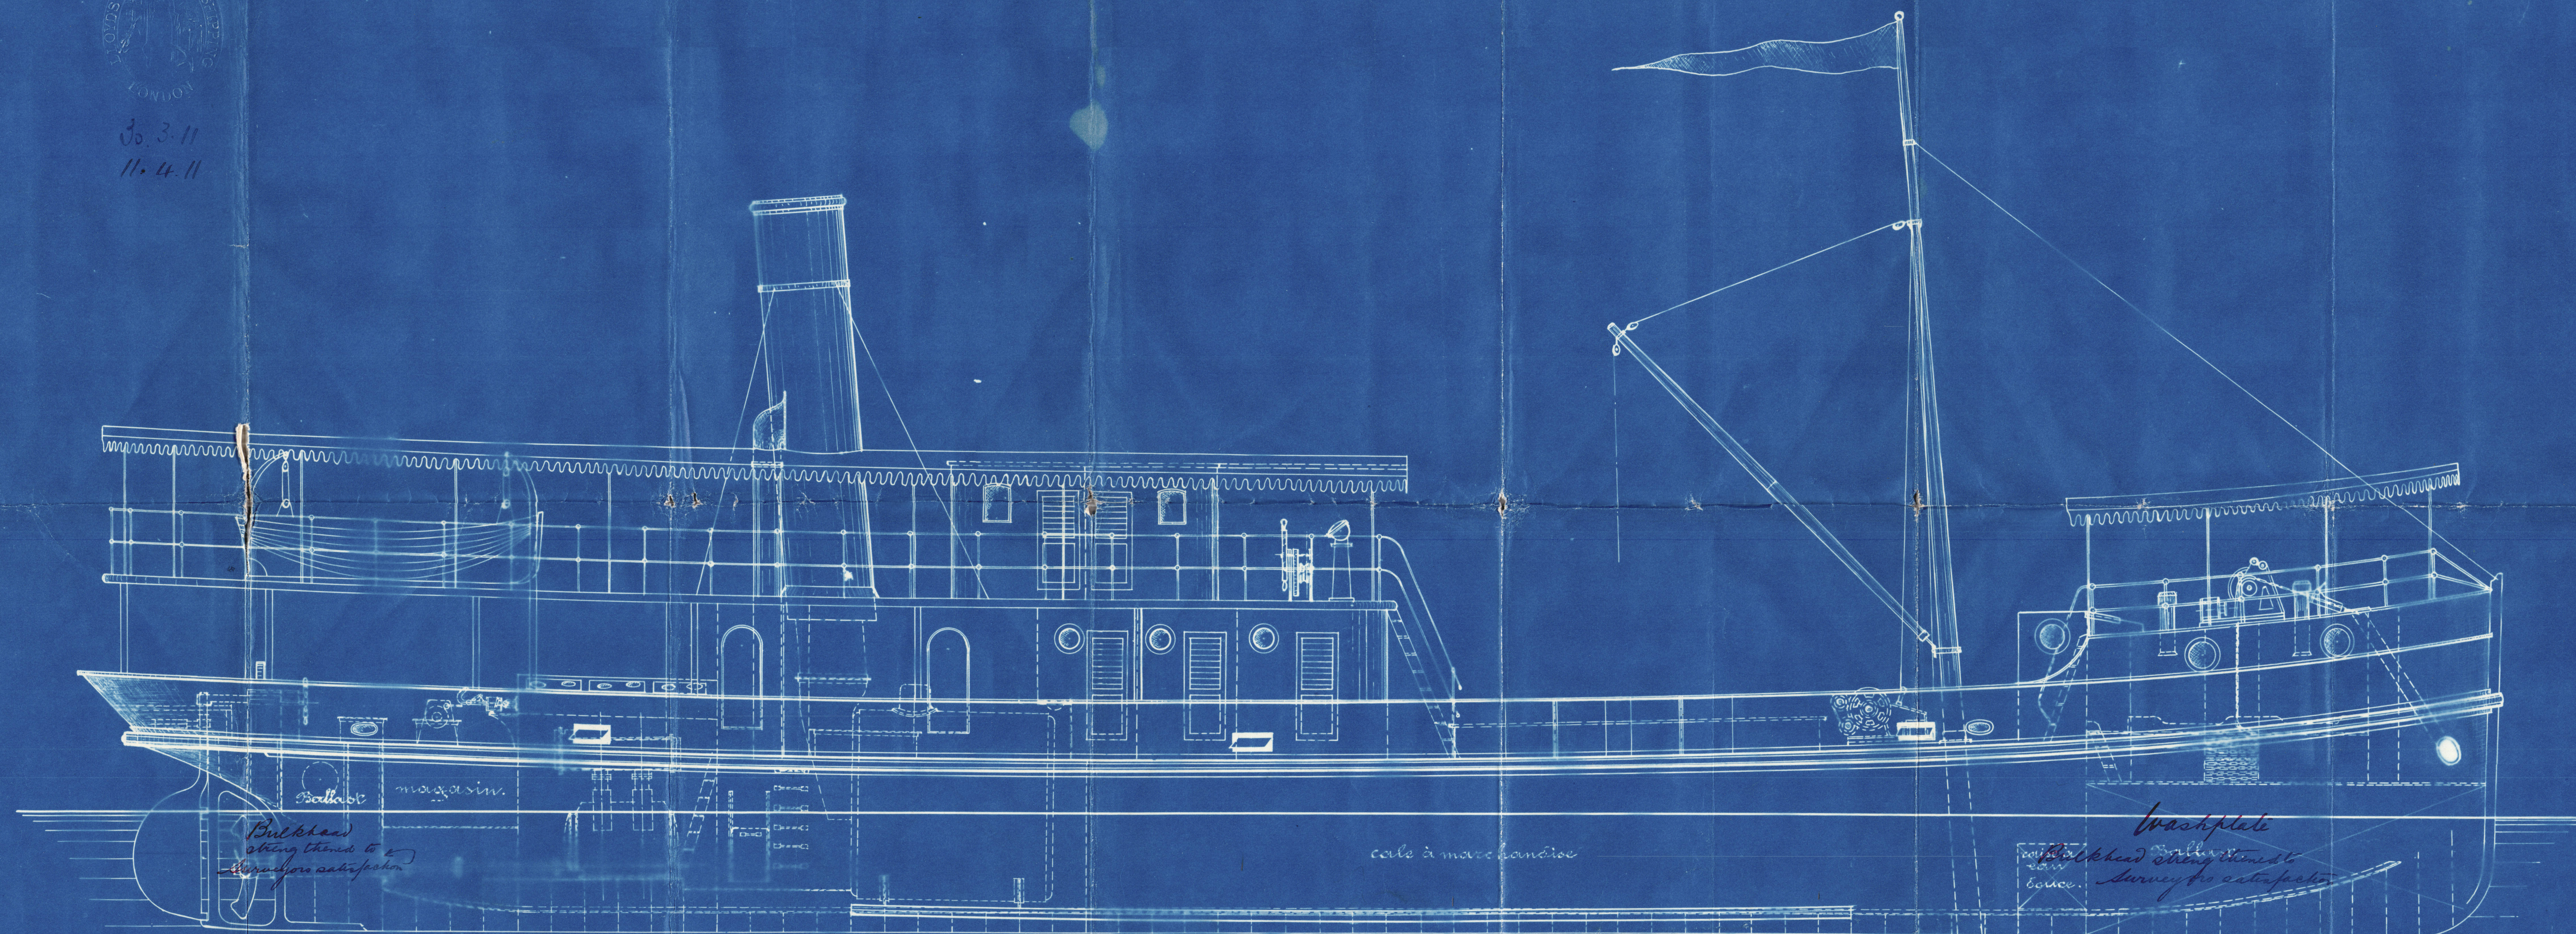

Caboteur.

Longueur entre p.p 34 Mtr.

Largeur 5.20

Creux 2.62

Echelle 1:50.

River & Coasting Boat to class
at Lloyd's 100 A.T. for small coasting trade.
34.00 m x 5.90 m x 2.62 m
111'-6" x 19'-4" x 8'-7"
B+D --- 27.91
L x (B+D) --- 3111.1
D --- 12.90
Jonker Jans.
Hendrik de Ambocht.
Holland.


30/3/11

78



Janke Stans.


Laugs doornede.

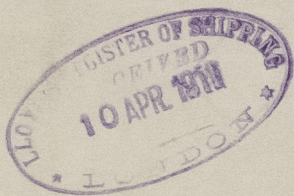

General Plan.

S.S. Teudaba.

Adam report no - 7432

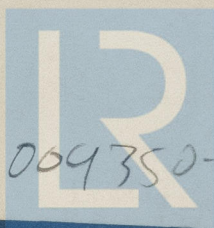

© 2021

009350-009361-0039 Lloyd's Register
Foundation