


*Height measurements shown in red ink.*  
**TUG & GRAIN ELEVATOR.**  
 S.S. N° 134. *Approved 11<sup>th</sup> June 1919.*  
**PROFILE & DECK.**  
 DIMENSIONS 160'-0" x 26'-6" x 17'-0" MLD.  
 SCALE - 1/4" = 1 FT.  
 TO CLASS A.I. LLOYDS FOR TOWING PURPOSES.

*Allowing throughout to Surveyor's satisfaction.*

*Keel supported to Surveyor's satisfaction.*

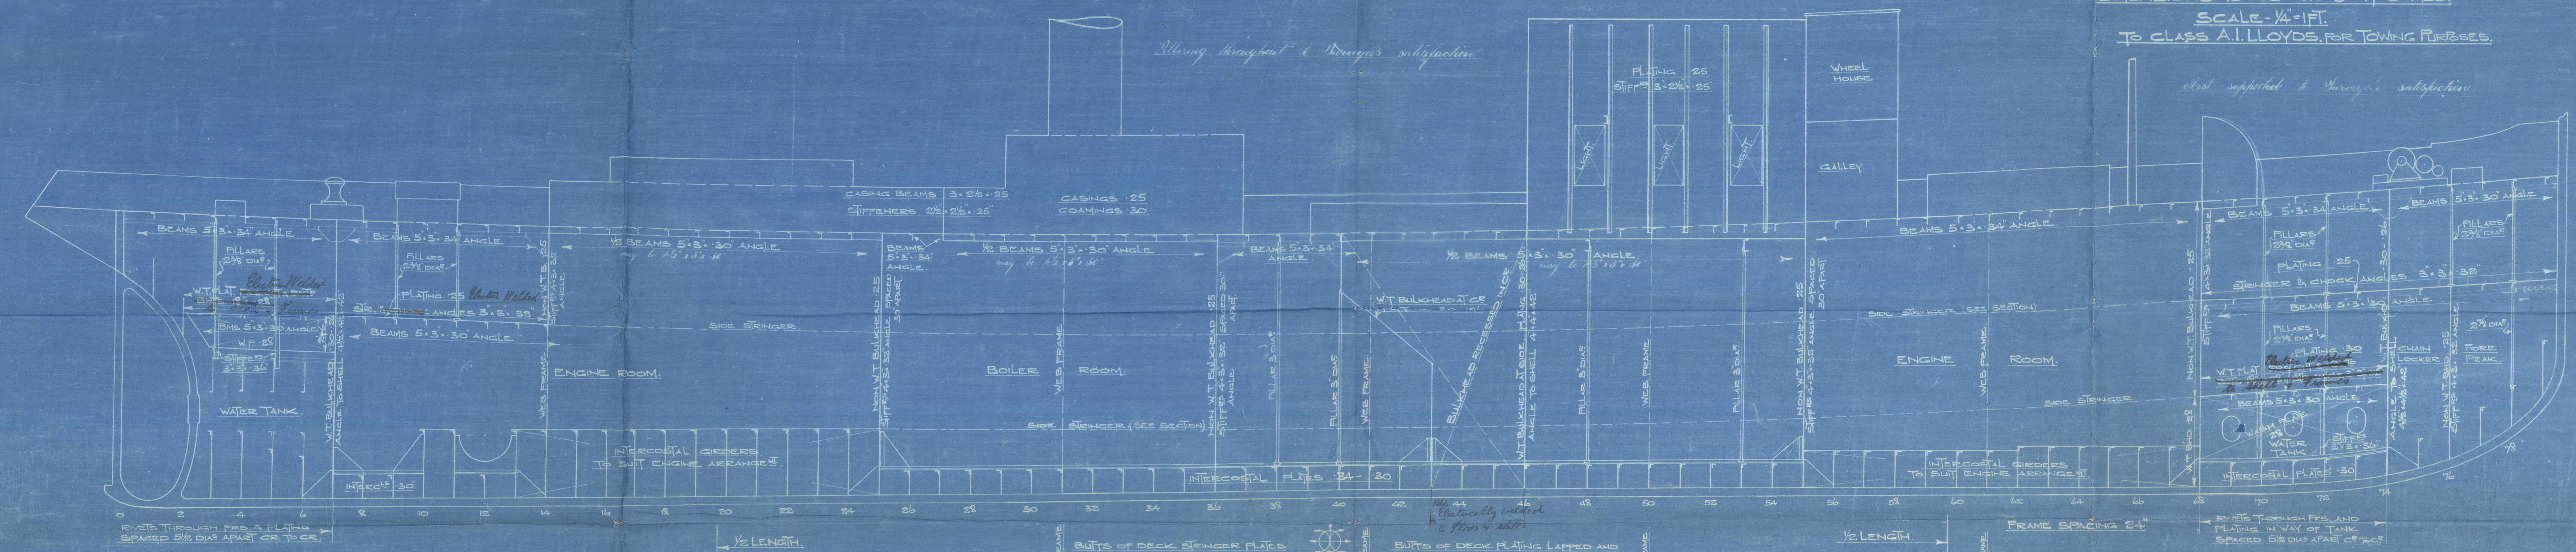



Messrs George Brown & Co.  
No 134.

Profile & Deck Plan  
showing parts of  
structure to be Electric  
Welded.

---

"  
S/ S. Garrymen II

GREENOCK Rpt No 17841.



© 2021

Lloyd's Register  
Foundation

009362-009375-0152