

## MIDSHIP SECTION

Nº 594

DIMS. 175'-0" B.P. x 29'-0" MLD x 15'-0" MLD.


SCALE  $\frac{1}{2}$  INCH

TO CLASS 100 A.1 STEAM TRAWLER.

DECK PLATED OVER IN WAY OF MACHINERY

E & B CASING AS PREVIOUSLY APPROVED

PLAN No. 3211  
FOR ENCLOSURE TO  
*Masero Lloyd Surveyor*  
*Hull* FROM  
COCHRANE & SONS, LTD.  
SHIPBUILDERS, GLENDALE.  
DATE: *1/8/13*

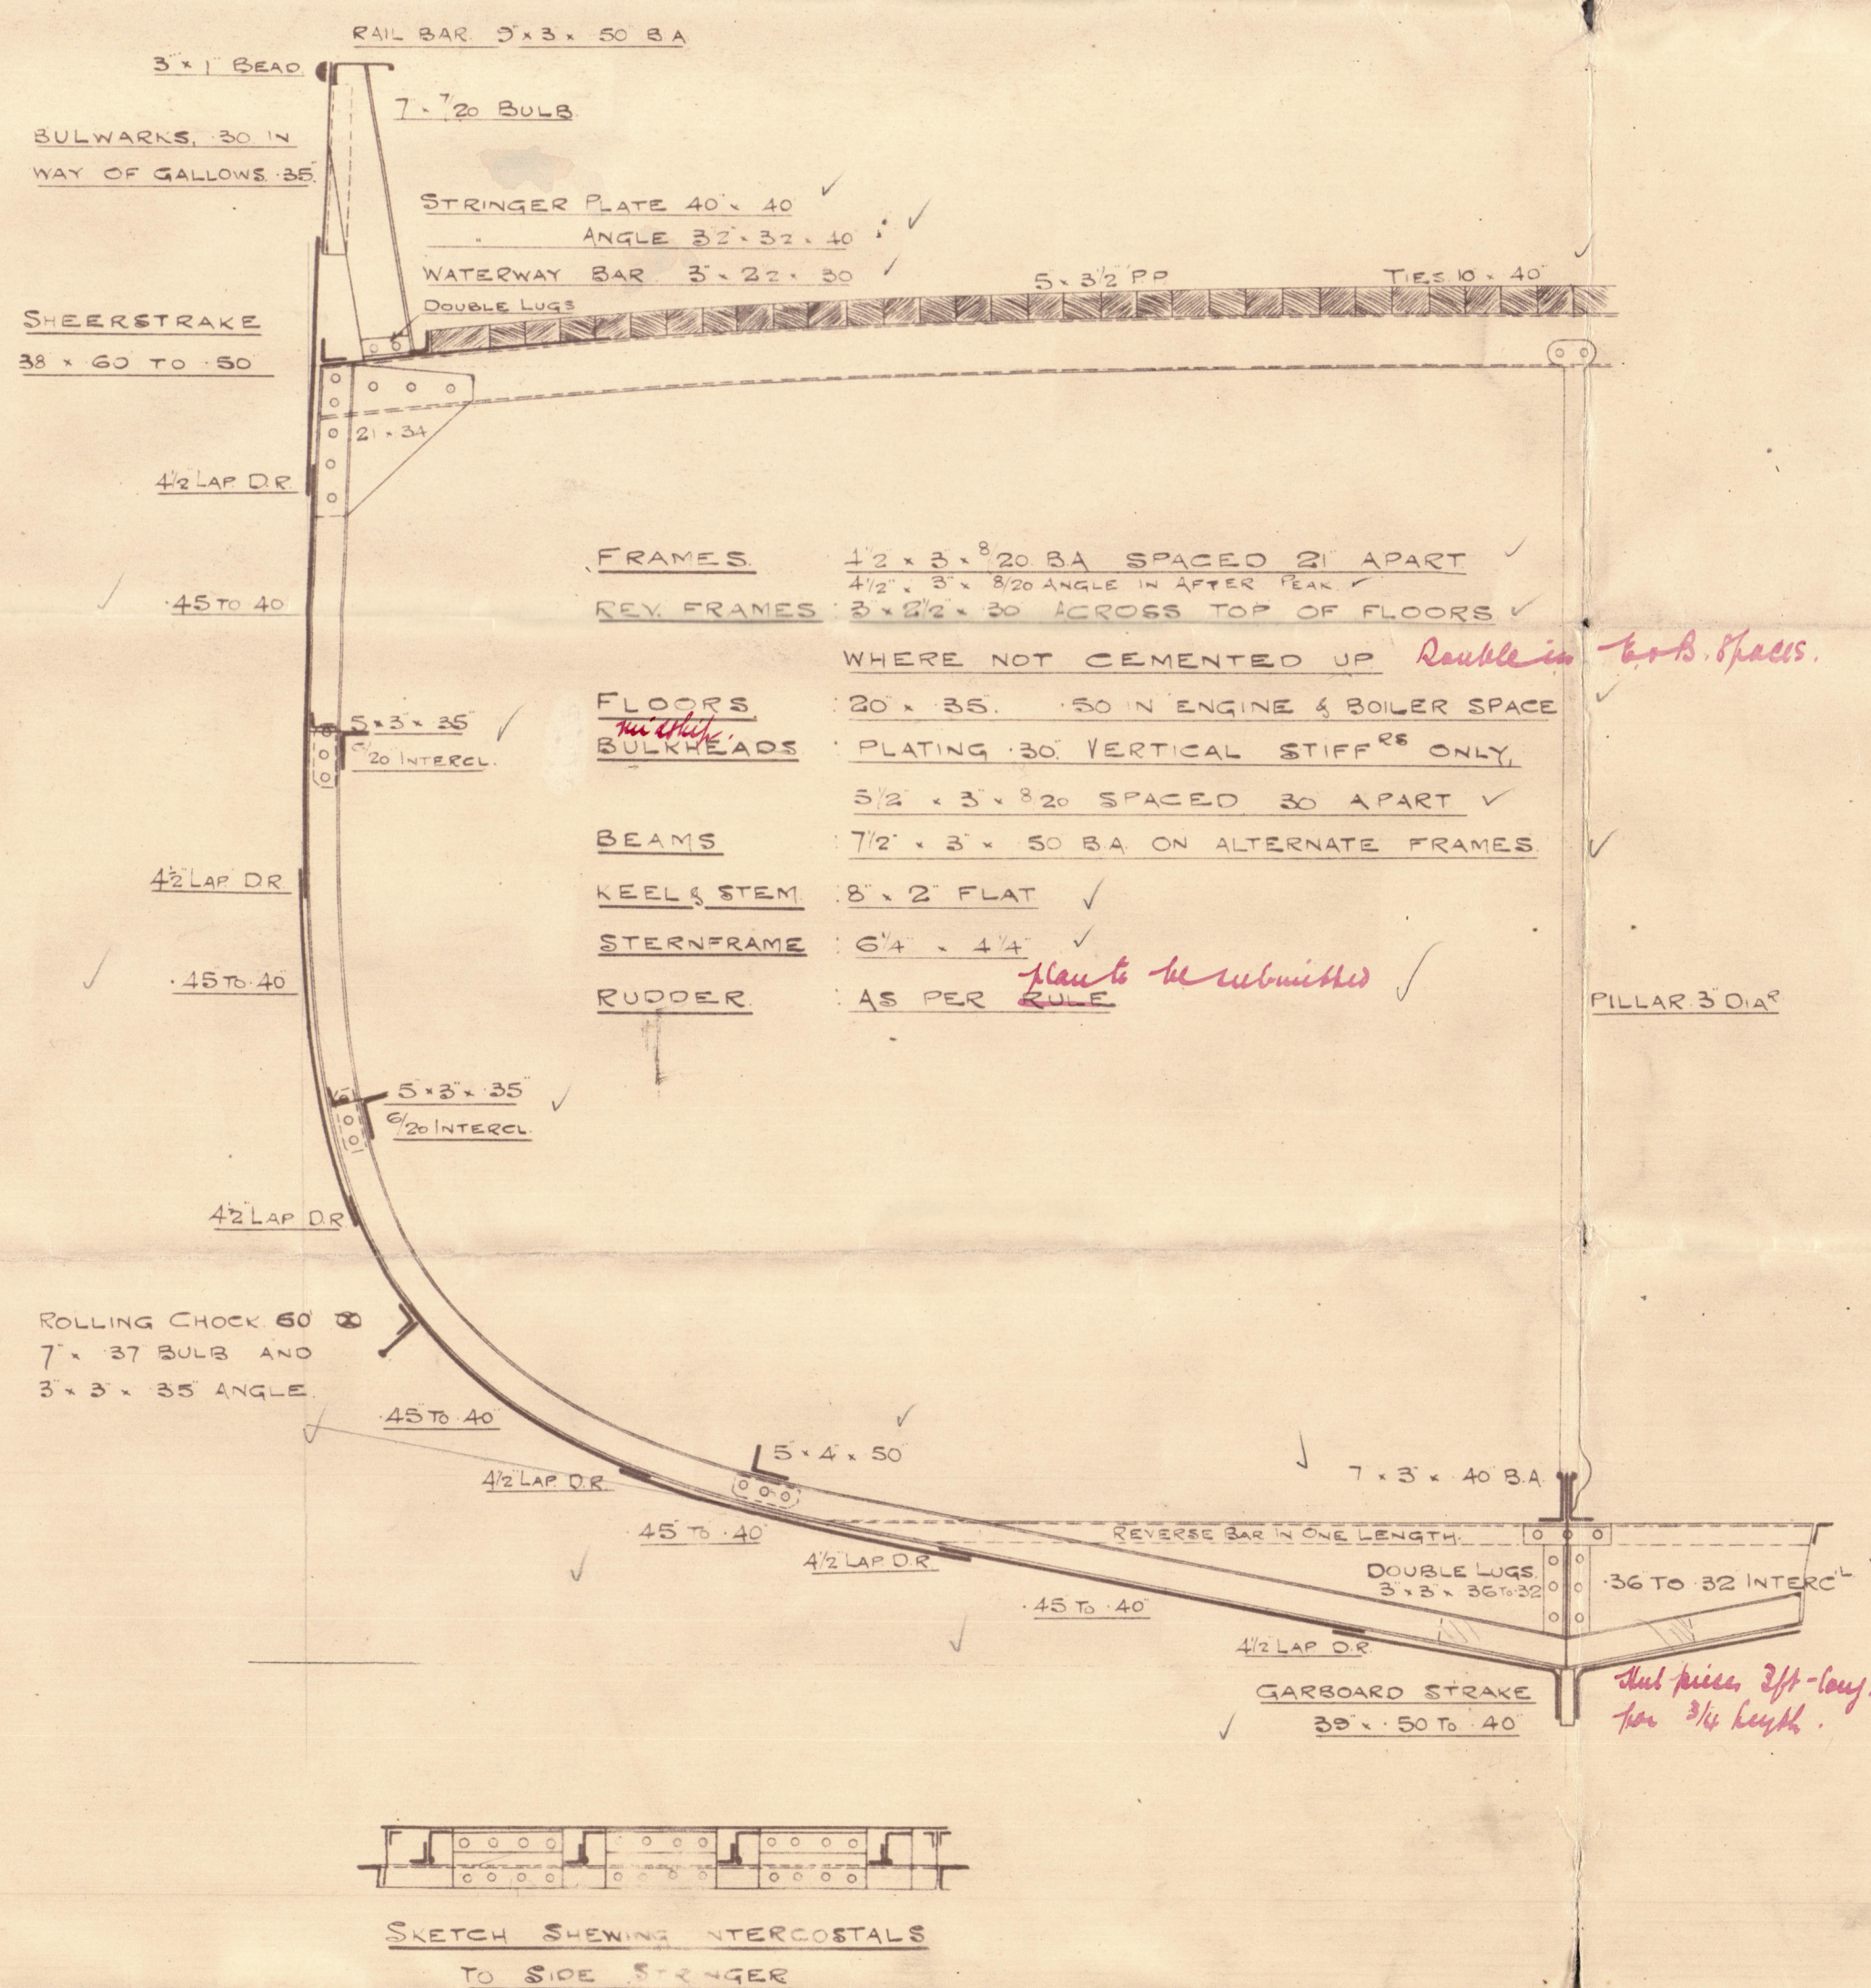

## NUMERALS

$$\begin{array}{r} B + D = 44 \checkmark \\ L \times (B + D) = 7700 \checkmark \\ d = 1333 \checkmark \end{array}$$

## EQUIPMENT.

2	ANCHORS	12 CWT STOCKLESS
1		4 1/2 Ex STOCK
150	FATHOMS	1 1/2 STUDLINK CABLE
75	"	8 WARP ✓
75	"	5 WARP ✓

## RIVETING.

BUTTS OF GARBARD & SHEERSTAKE, ALSO O.E. & F. STRAKES  
BETWEEN DOUBLINGS TO BE STRAPPED, REMAINDER OF BUTTS  
OVERLAPPED  
BUTTS TREBLE RIVETED FOR 1/2 L. DOUBLE AT ENDS.  
LANDINGS DOUBLE RIVETED BULWARKS SINGLE RIVETED  
OVERLAPPED & TREBLE RIV'D FOR 1/2 L.  
BUTTS OF STRINGER PLATE & TIES OVERLAPPED & DOUBLE RIVETED.  
ALL RIVETS THRO' SHELL TO BE 3/4 DIA.  
RIVETS THRO' KEEL, STEM & STERNFRAME TO BE 1" DIA.


C.B.  
8. 8. 13






Nº 594

MIDSHIP SECTION

MESSRS COCHRANE & SONS.

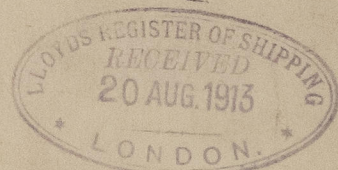


*s/s Maroc*  
*Hull Rpt No. 27354*

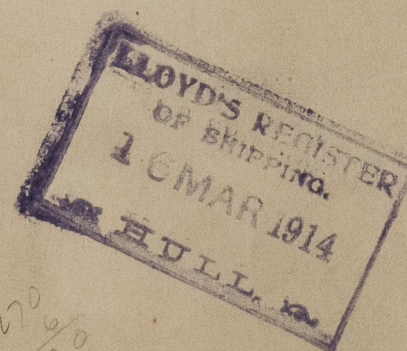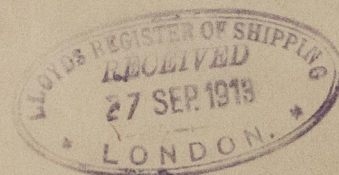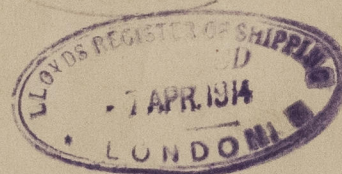

270  
1620

009376-009386-0088

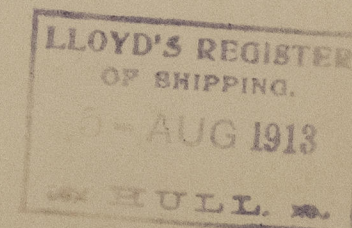

009376-009386-0088



© 2021

Lloyd's Register  
Foundation