

E. F. 13
20. 8. 13
29. 9. 13

PLAN No. 3212
FOR ENCLOSURE TO
Messrs Lloyd's Surveyors
Hull FROM
COCHRANE & SONS, LTD.
SHIPBUILDERS, SELBY.
DATE 1/8/13 890


PROFILE & DECK PLAN
N°594

DIMS. 175'-0" B.P. x 29'-0" MLO x 15'-0" MLO.

SCALE 1/8 INCH

TO CLASS 100 A. 1. STEAM TRAWLER.

PILLARING THROUGHOUT TO SURVEYORS SATISFACTION

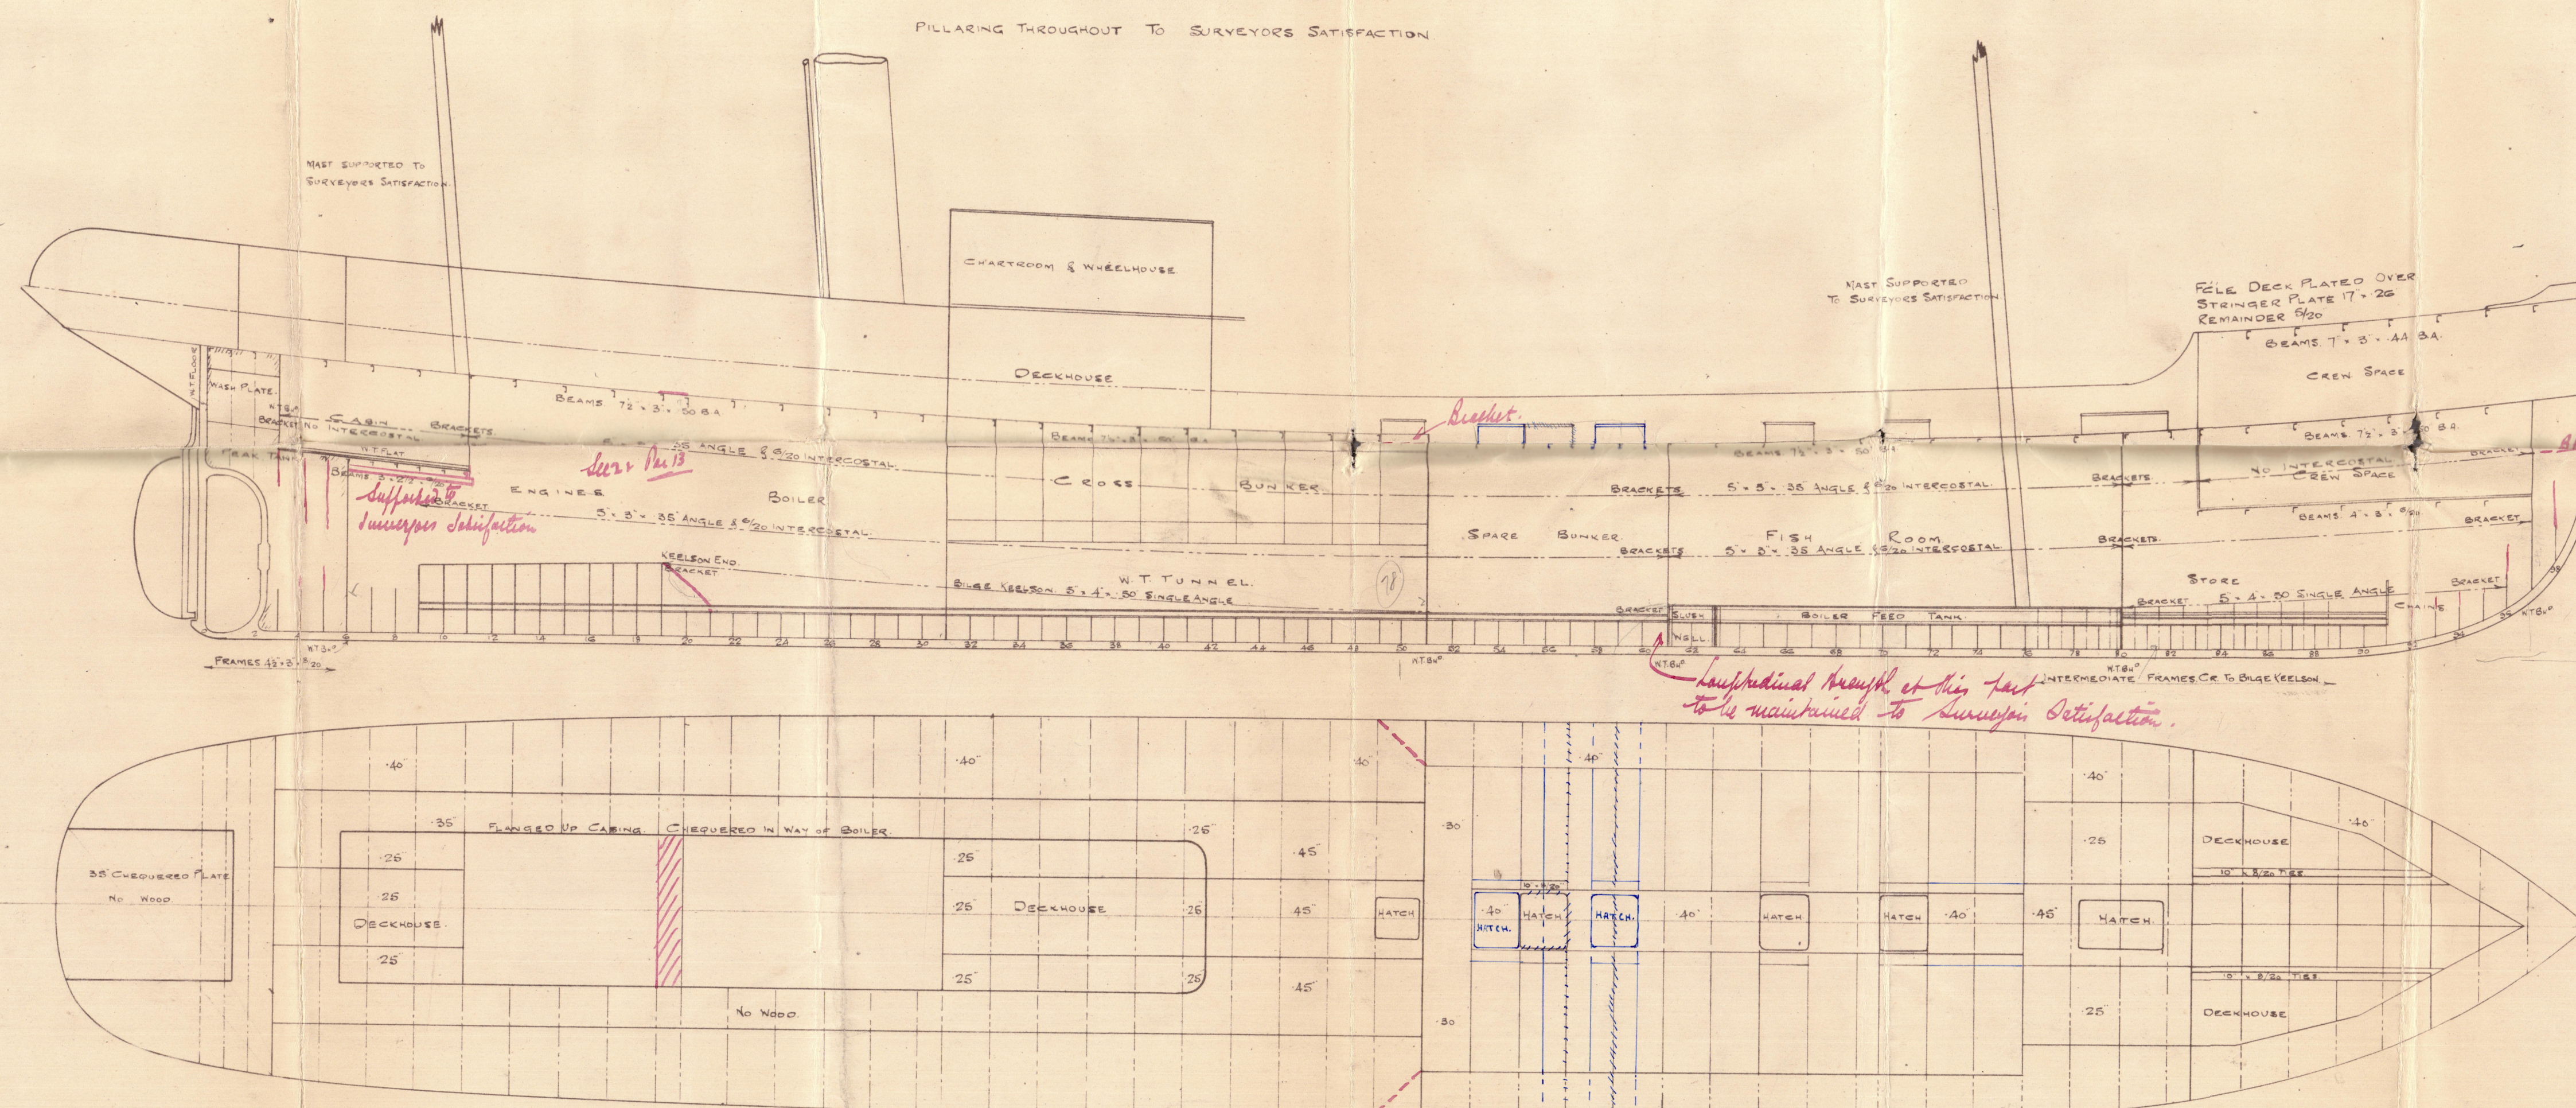

C. B.
9. 8. 13

N^o 594.




PROFILE + DECK PLAN

MESSRS COCHRANE + SONS.



s/s Maroc.


Hull Rph No - 27354

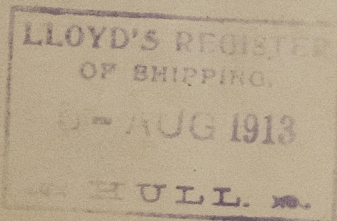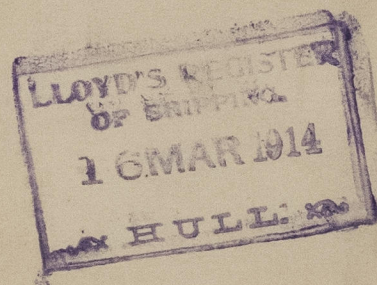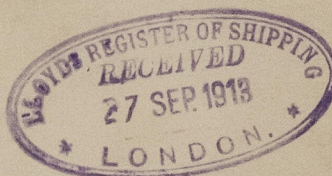

009376-009386-0089

009376-009386-0089

009376-009386-0089

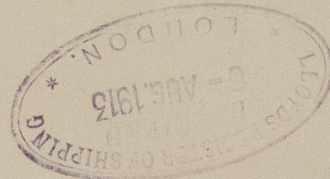

© 2021

Lloyd's Register
Foundation