

2	Lower anthers	2nd 38 3/4	also	strokeless
1	"	32 1/2	"	"
1	Stems	10	"	gr stroke
1	Kedge	5	"	"
240	fallow	13 1/6	Had	chain cable
75	"	1 2/6	chain	in this shell was stems
90	"	4	shell	was lime
260	"	7	staves	
200	"	6	warps	

Letter in Machine case to be submitted

details of sealings to be submitted


WOODEN STEAMSHIP FOR GREAT NORTHERN PAPER CO.
DESIGNED BY J. J. WARDWELL - FRANCIS COBB SHIP BUILDING CO. ROCKLAND, ME

French

(13) Wood & Coine Screw S/S.
RIPOGENUS.

FRANCIS COBB CO #71

PROFILE.

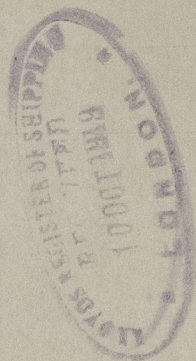

Boston Report, 1189.

009387-009400-0060

© 2020



Lloyd's Register
Foundation