

Lloyd's Stamp
14. 4. 05

MIDSHIP SECTION

STEEL SCREW TRAWLER

N^o 347-8

DIM: 117'-0" x 21'-6" x 12'-6" MOULDED 11'-9" HOLD
TO CLASS 100.A.I. AT LLOYD'S FOR FISHING PURPOSES.
RAISED Q^r D^k 62' x 15" RAISED FORECASTLE DECK. 19' x 15".




ENGINE & BOILER CASING AS PREVIOUSLY APPROVED.
DECK PLATED IN WAY OF E & B CASING

NUMERALS AS PER RULES
1st GIRTH 19.16
2nd BREADTH 10.70
DEPTH 12.92
42.78. 1st N^o
LENGTH AS PER RULE 115.75
4952.17 2nd N^o

PROPORTIONS
DEPTH TO L 9.4
BREADTH " " 5.4

EQUIPMENT
1st BOWER 5 CWTs EX STOCK
2nd " 4 1/2 " " " "
3rd " 2 1/2 " " " "
90 FATH^s 1" CABLE
60 5 1/2 HAWSER
60 4 WARP.

COCHRANE & SONS
SHIPBUILDERS
SELBY

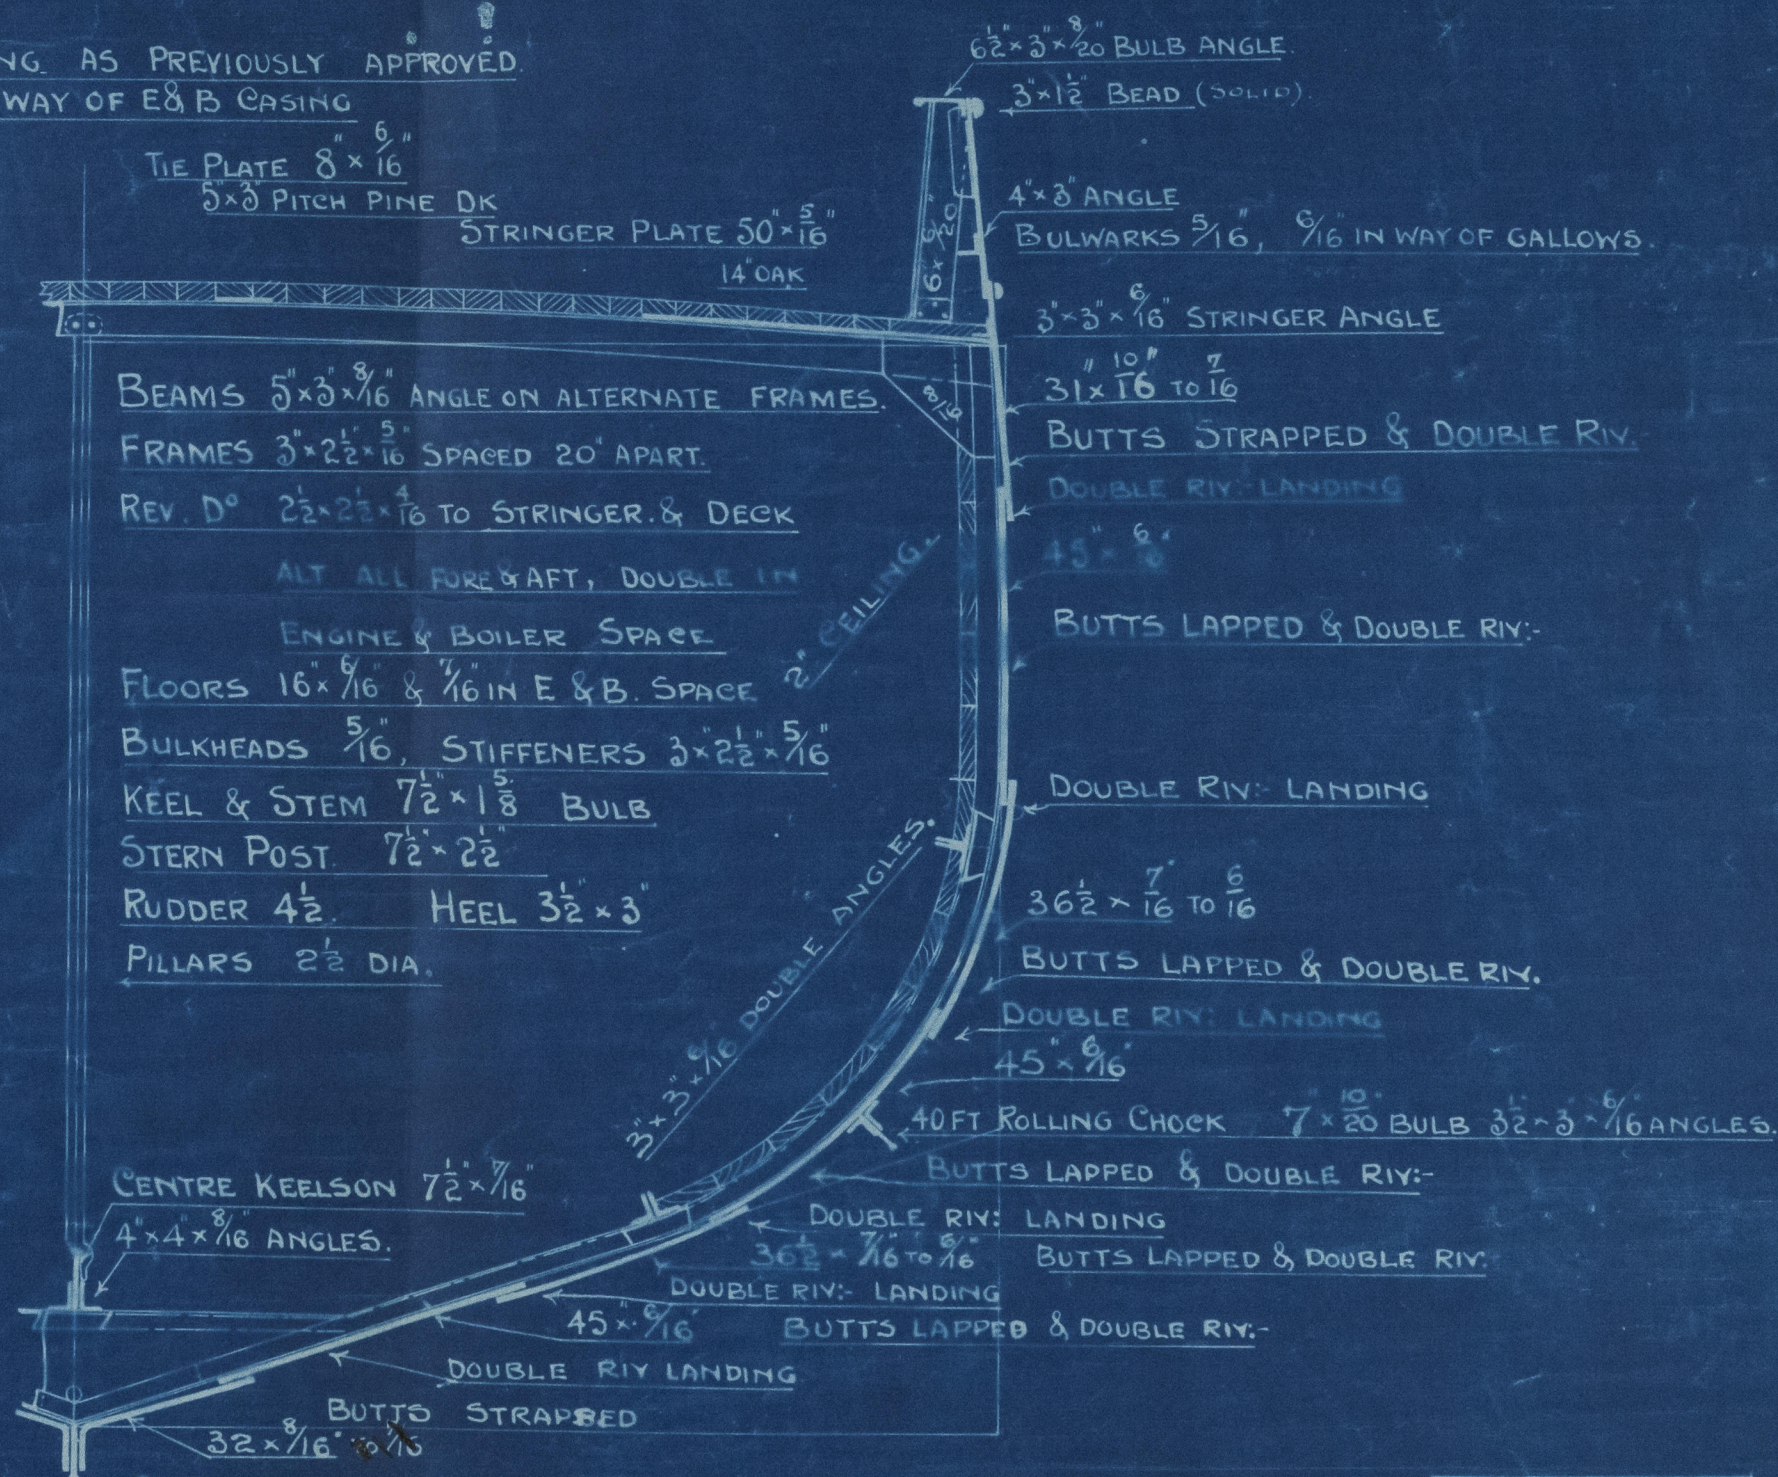

14. 4. 05

LLOYD'S REGISTER
OF SHIPPING
12/4/05
HULL




Lloyd's Register
Foundation

Lochrane & Sons
Selby

£s Romilly

Hull Report No.-

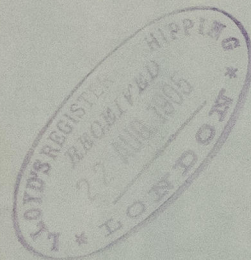

© 2020

Lloyd's Register
Foundation

009387-009400-0077