

14.5.13.

DETAILS OF TOWING ARRANGEMENT LATER.

DETAILS OF STERN FRAME & RUDDER SUPPLIED LATER.

DETAILS OF ENGINE AND BOILER BEARERS SUPPLIED LATER.

STRENGTH MAINTAINED TO SHARPEN'S SKEWER

DEMARICATION PLAN AS BETWEEN SHIPBUILDERS & ENGINEERS WILL BE SUPPLIED LATER.



STEEL SCREW TUG

80'0" O.B.P. x 20'6" x 10'6" M.S.

SCALE 3/16" = 1' FOOT

80'0 B.P. x 20'6" x 10'6" M.L.

Lloyd 100 A.I. For Towing Purposes.

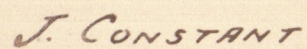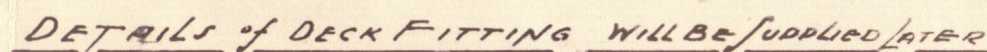

11 BILLITER So

LONDON E. C.

Cochrane & Sons. Ltd.
No 591

Profile & Deck

Dimensions

80-0' x 20-5' x 10-5'

Lady Fredegar

Hull Report No: 26714



© 2020

Lloyd's Register
Foundation

009387-009400-0188