
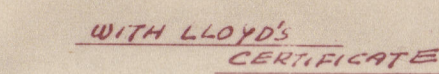


SEA SPEED. 9 KNOT.

TOTAL RUDDER AREA ABOARD THE CENTER	
LINE OF THE DINTLES	2.715 m ²
TOTAL RUDDER AREA.	3.595 m ²

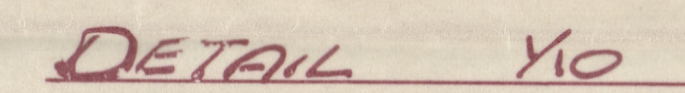

ITEMS	MARK	MATERIALS	NO. FOR ONE SHIP	2000 場	1000 場
STEEL ARM	①	CART STEEL	1	1	✕
COUPLING SHOE	②	"	1	1	"
BOTTOM BEARING	③	FORGED STEEL	1	✓	"
FLEDER STECK COUPLING BOLTS WITH NUT & SPLIT PIN	④	"	1	✓	"
TOP PINTLE WITH NUT & SPLIT PIN	⑤	"	6	✓	"
BOTTOM PINTLE WITH NUT & SPLIT PIN	⑥	"	1	✓	"
BOTTOM PINTLE WITH NUT & SPLIT PIN	⑦	"	1	✓	"
RUBBER STOKER	⑧	"	1	✓	"
STUD	⑨	"	2	✕	"
TOP BEARING BUSHED SLAVE	⑩	LIGNUMVITE	1	✕	"
TOP PINTLE BOTTOM BEARING BUSHED SLAVE	⑪	GUNNETAL	1	1	"
BOTTOM PINTLE	⑫	LIGNUMVITE	1	✕	"
BOTTOM PINTLE	⑬	GUNNETAL	1	1	"
GALVANIZED WOODEN RUBBER BODY	⑭	STEEL PLATE	2	✓	"
RUBBER BODY	⑮	"	1	✓	✓
REMOVABLE CUP HARDENED CARRYING DISC	⑯	"	1	✓	✓
GOODY PLATE	⑰	HARD STEEL	1	✓	✕
	⑱	STEEL PLATE	1	✓	✓

注意
一、飛、外殼、水垢ト
外殼、右、上ト取、片面鎔接
他面、分、鎔、使用ス、コト
一、縱横、ト、相互、取得、鎔接ス、

實用新案「第六三三號」
「特許第 九六五九二號」

APPROVED

LLOYD'S REGISTER OF SHIPPING

APR 14 1936

KOBE

№4067.

舵及舵尾骨木

一 着色部令
一 印部令寸法通り荒仕也ト要
一 外取付キ部令一寸花黒邊一ヤト下
一 尚各部寸法詳細規則主ヨリ記シ取ルベト

[illegible]

© 2020
Lloyd's Register
Foundation


"Kamchatkaya"
yha 6190.

ロイド協會行

Ship's Name or No. 406 & 7	
Name	<u>SELF PROPELLING HOPPER BARGE</u>
of	<u>RUDDER AND STERN FRAME</u>
Drawing	(ALTERED)
Drawing No.	Sending No.

777

(5)

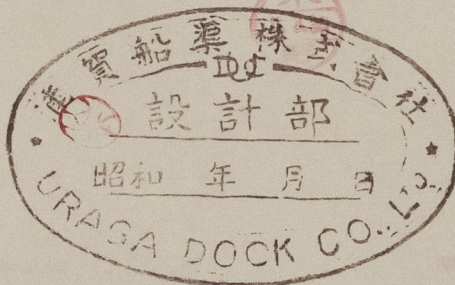

© 2020

Lloyd's Register
Foundation

009387-009400-0213