


NOS. 406 & 7



ALTERATION OF CONSTRUCTION
PROFILE AND DECK PLANS.

SCALE 1/50

THE ALTERED PLAN.

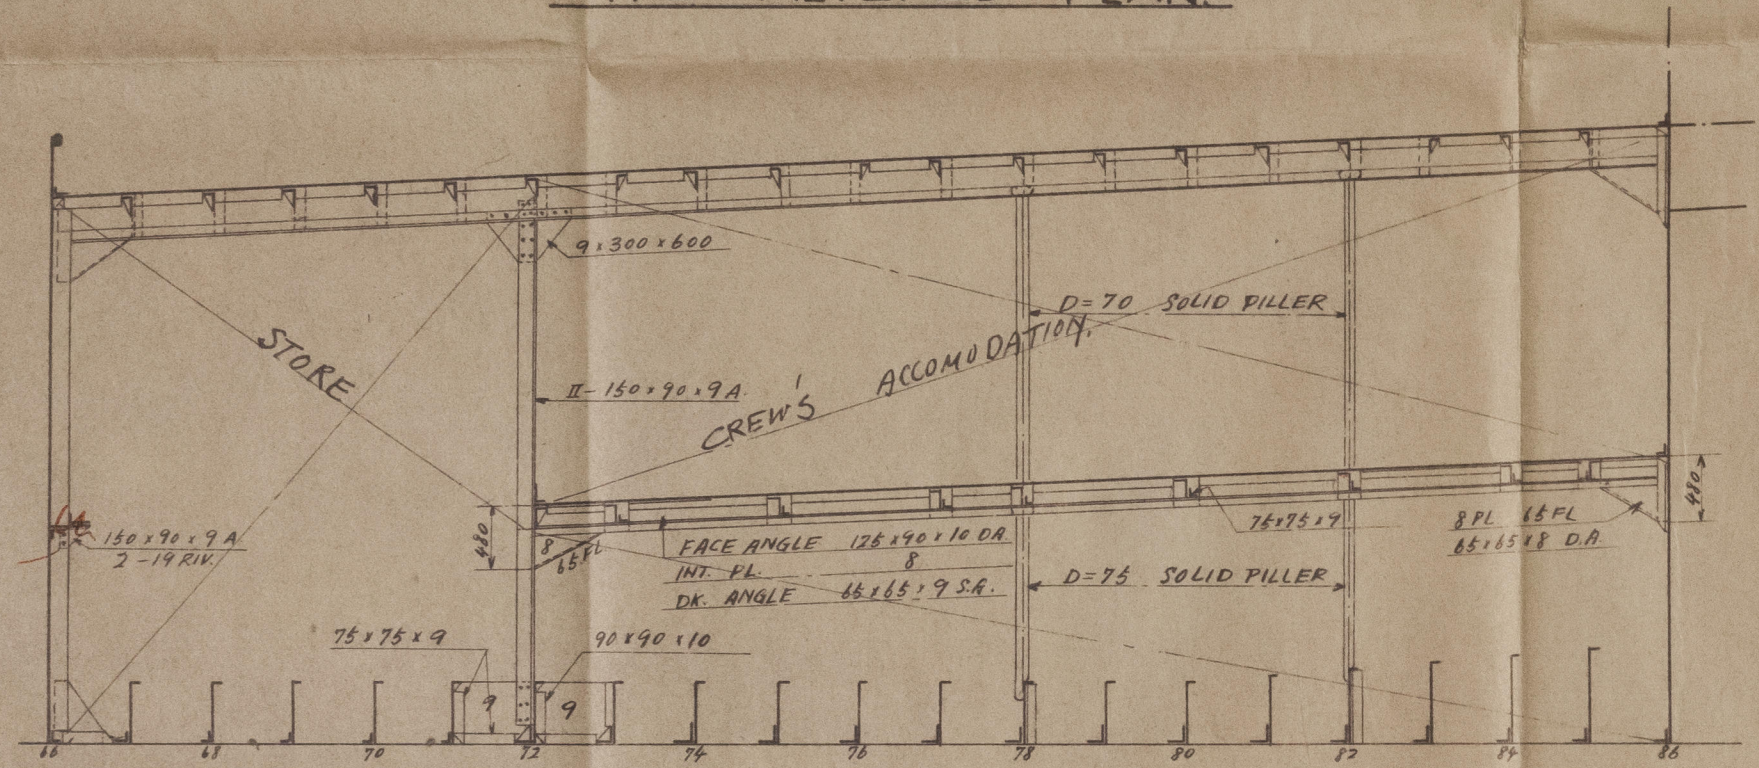

THE ORIGINAL PLAN.

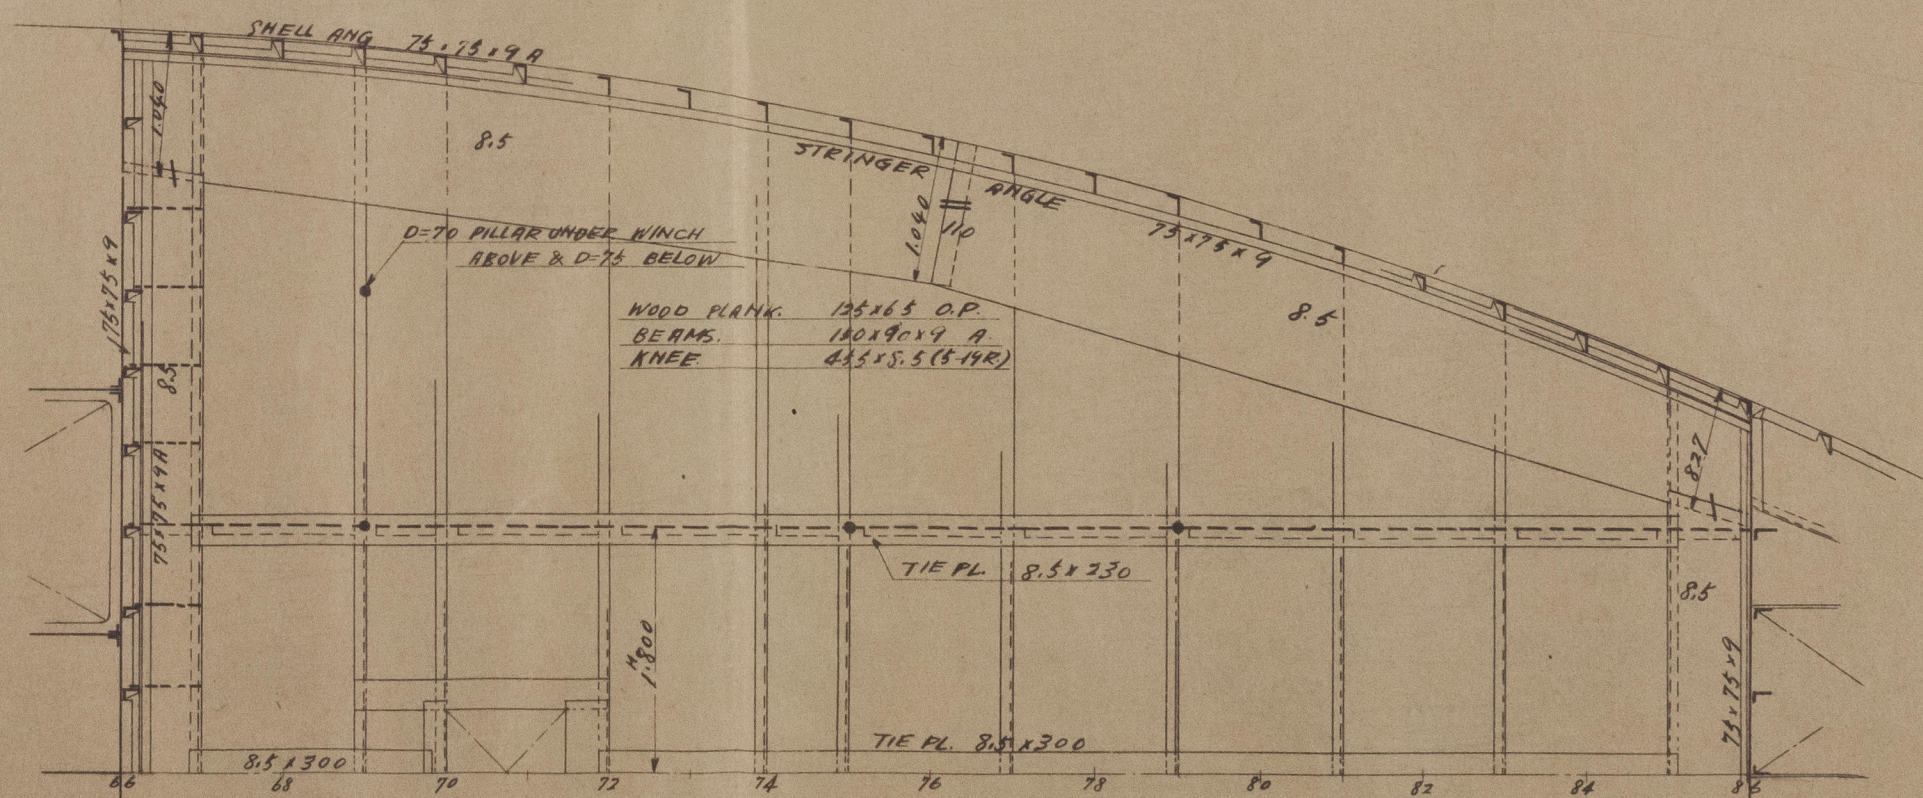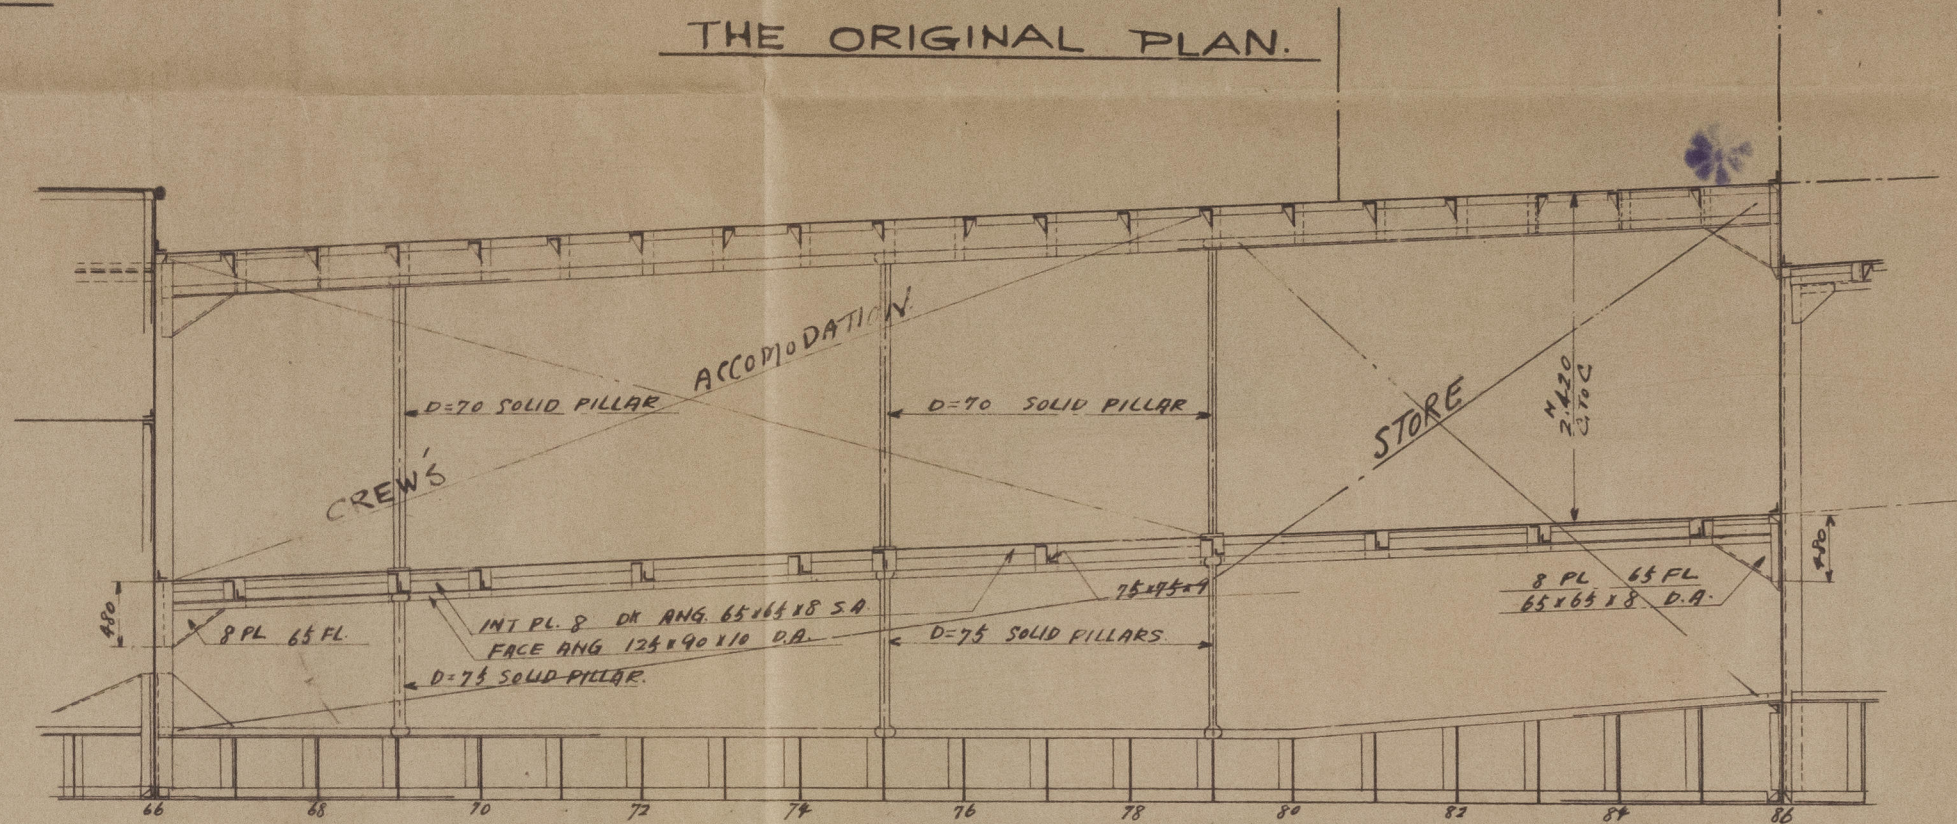


APPROVED
LLOYD'S REGISTER OF SHIPPING
AUG 29 1930
KORE

NOS. 406 & 7

鋼
材
構
造
一
部
改
正

縮尺 1/50

11 7 13

 Kamchatka Yka 6190
Sachalin Raza


ロイド協會行

Ship's Name or No. 406-7	
Name of Drawing	Alteration of Construction Profile and deck plan.
Drawing No.	Sending No.

9

GEN BOX NO

777

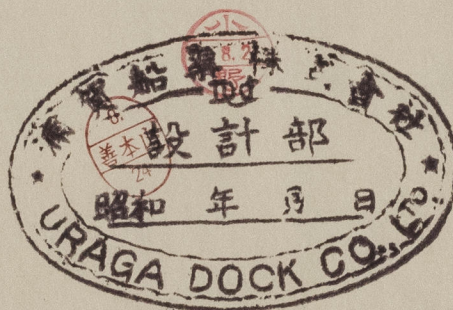

御承認用



© 2020

Lloyd's Register
Foundation

009387.009400-0215