


NO 406 AND 7.
CONSTRUCTION PLAN.
SCALE 1:50.

 


APPROVED
FEB 20 1935
KOB


ロイド協會行

Ship's Name or No. 406-7.	
Name	SELF PROPELLING HOPPER BARGE.
of	CONSTRUCTION PROFILE AND
Drawing	DECK PLANS.
Drawing No.	Sending No.


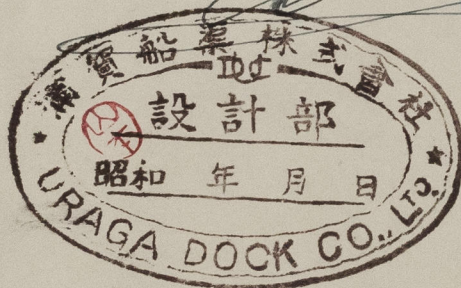

© 2020

Lloyd's Register
Foundation

009387-069400-0216