

(264)

20. 9. 11
10. 11. 11
27. 11. 11

PROFILE

J. P. Carter
No 263. 264

GLUCKAUF

22. RONDOL

22. RONDOL

Nº 263. 264

PROFILE & DECK PLANS.

SCALE 1" = 10 FEET

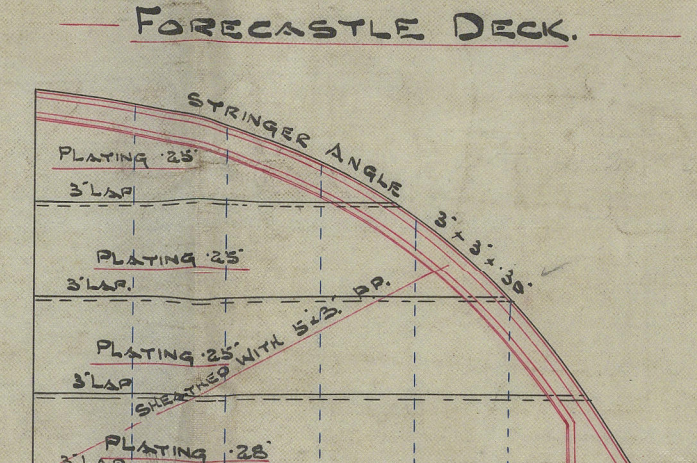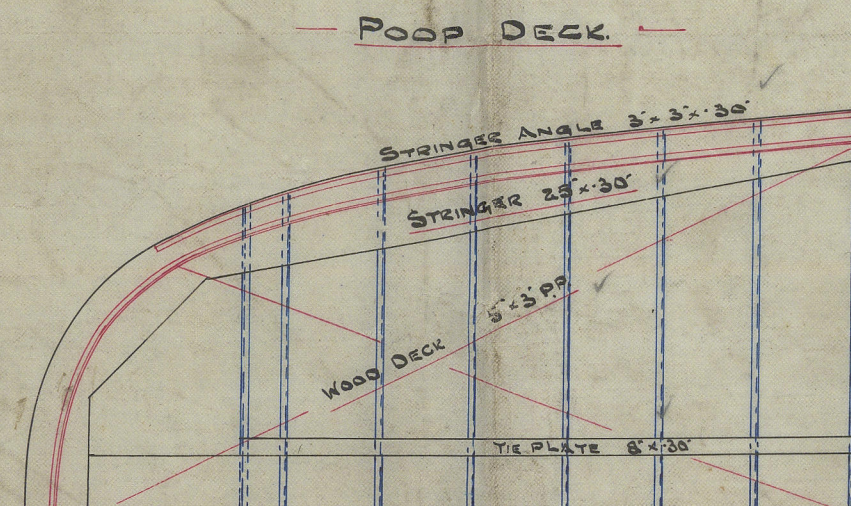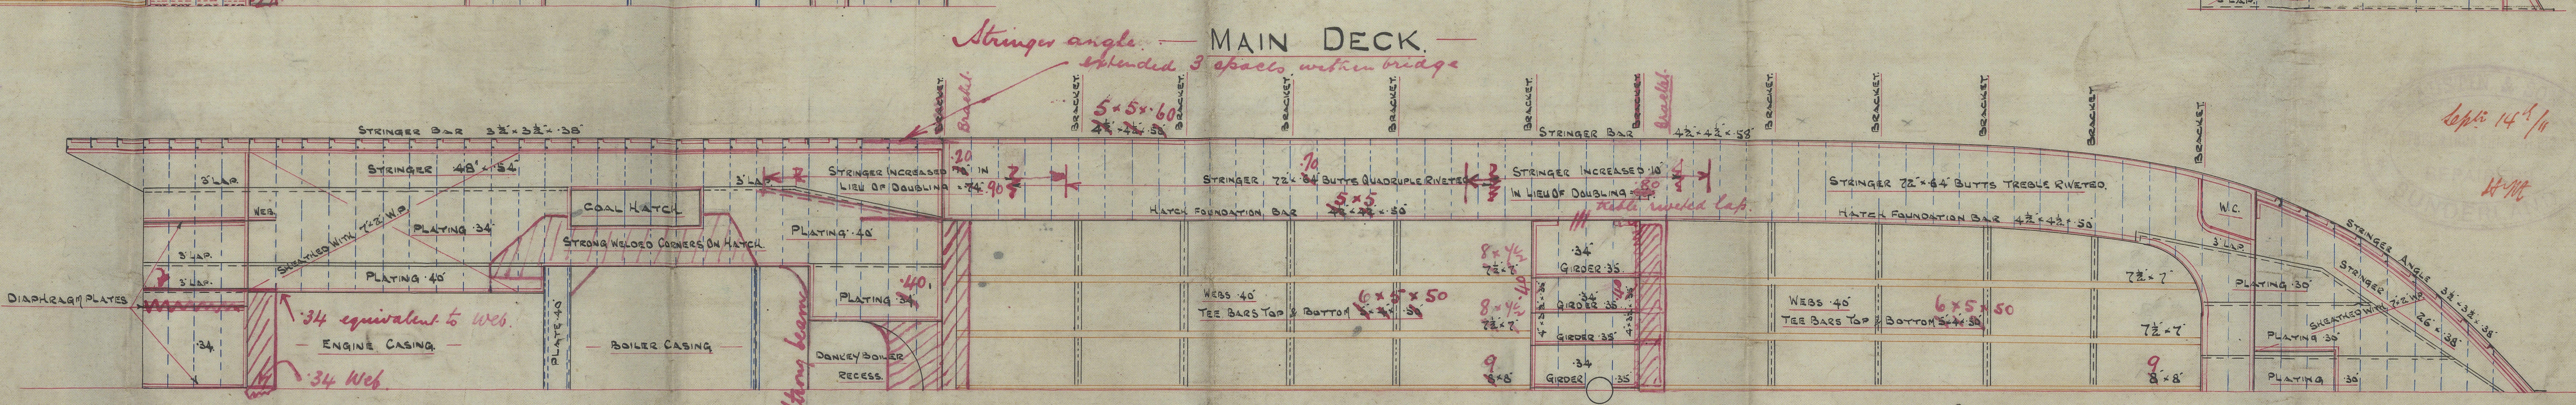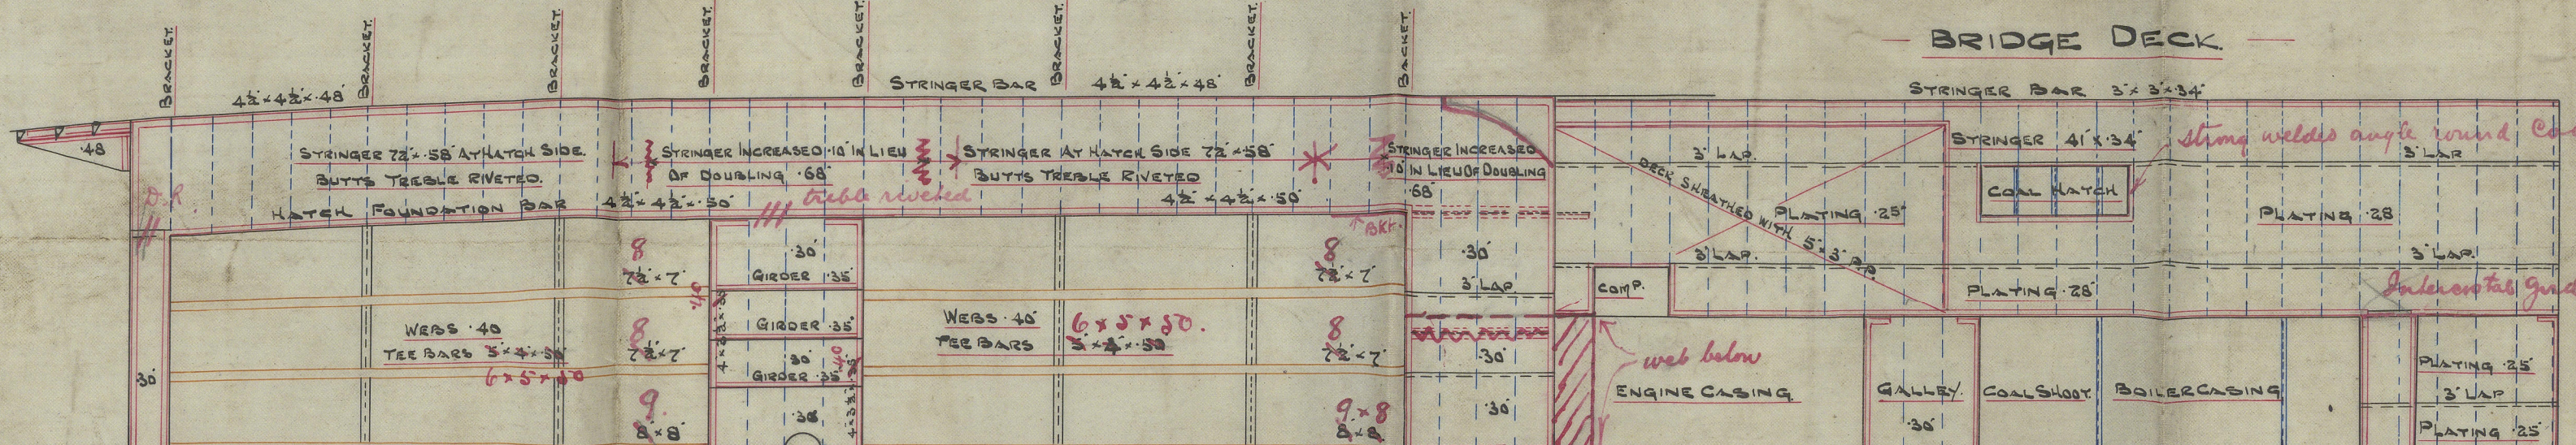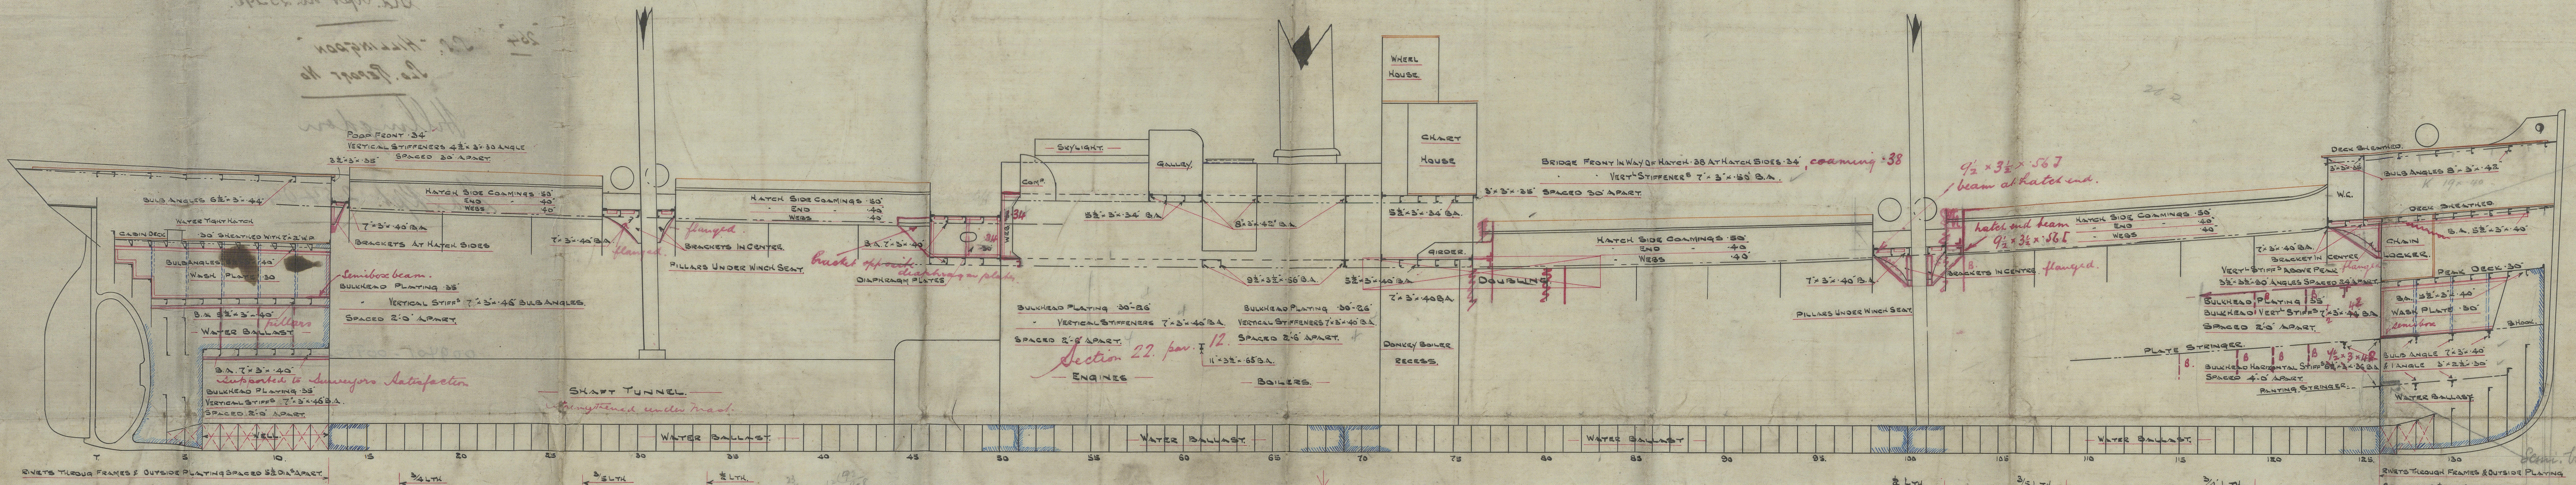

C.B.
20. 9. 11.

PROFILE.

S. P. Austin & Son

Nº 263. + 264

^a
GLUCKAUF

EX

SS. "RONDO" D. 64 B

Sld. Rpt. no. 25290.

264

S.P. "HILLINGTON"

Sld. Report No

Hillington

Sld. Rpt. 25404

009401-009908-0015

© 2020

Register
Foundation