


W. Starkess Hon No 175
Profile and deck Plans
(modified)

n/n "Coyhaigue"

esc

s/a Jamaica

Indb rpt No 5596

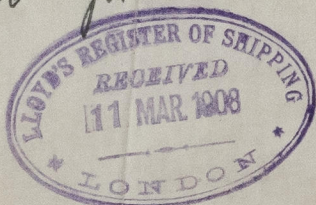

© 2021

Lloyd's Register
Foundation

009409-009417-0225