


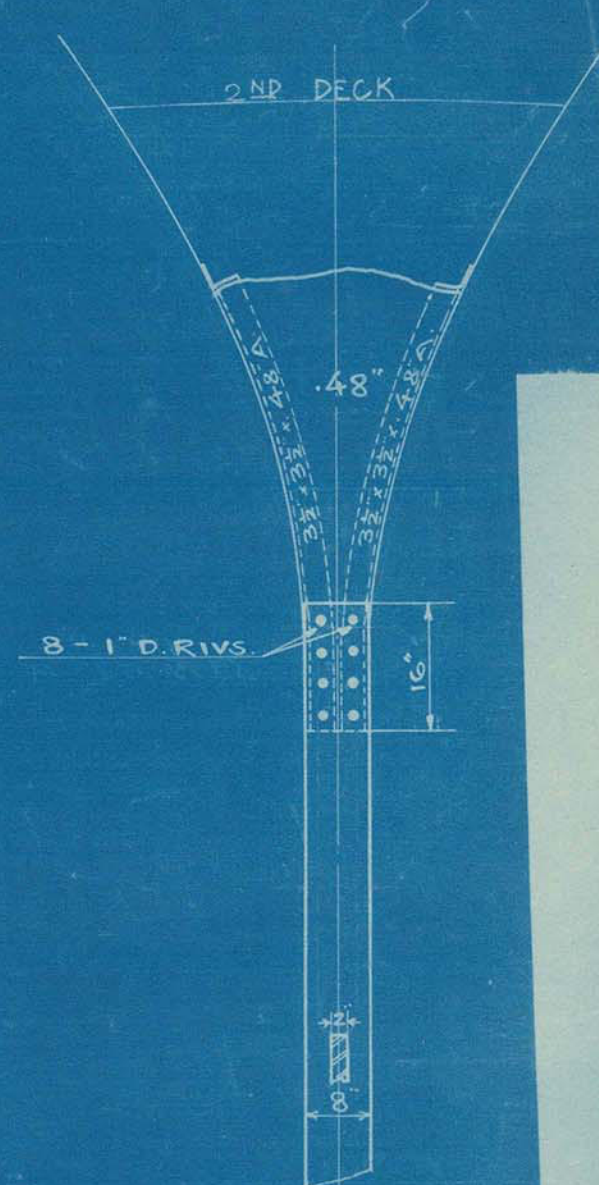

ZINC PROTECTOR 取付詳細圖

SCALE:  $1\frac{1}{2}$ " TO 1 FT.



S.N° 427  
COLUMBIA MARU.

## FINISHED PLAN





S.Nº 427

COLUMBIA MARU.

STERN FRAME PLAN.

SCALE 1/2 INCH TO 1 FOOT.

(DETAIL) 1 1/2 " " 1 " .

FINISHED PLAN



21.8.26

*[Signature]*  
Aug. 21. 1926.

S. S. "COLUMBIA MARU"  
NAG. 1600.

12  
1  
1  
4



© 2021

Lloyd's Register  
Foundation

009409-009417-0257

009409-009417-0257