


SCALE  $\frac{1}{2}$  INCH TO ONE FOOT



009418-009427-005

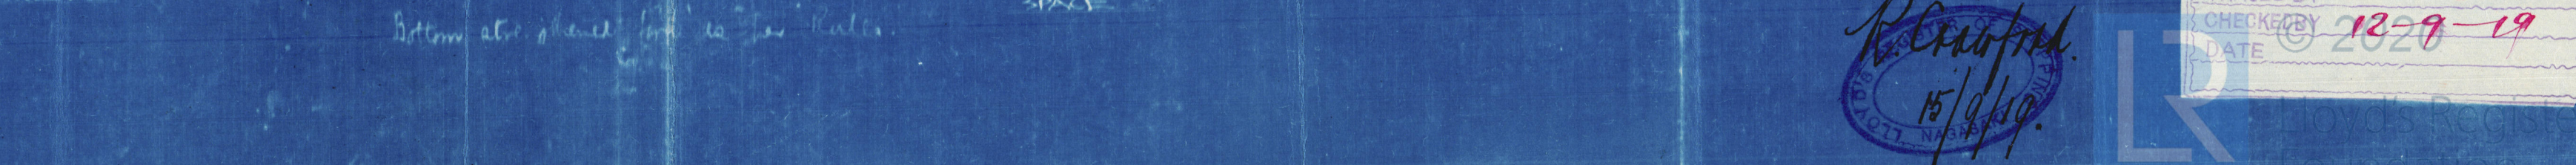


S. S. "Kohyo Maru"

Midship Section.

Report No. 1249.

Nagasaki

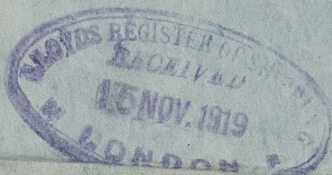

© 2020

Lloyd's Register  
Foundation

009418-009427-0055