


18.3.13
14.4.13
14.5.13

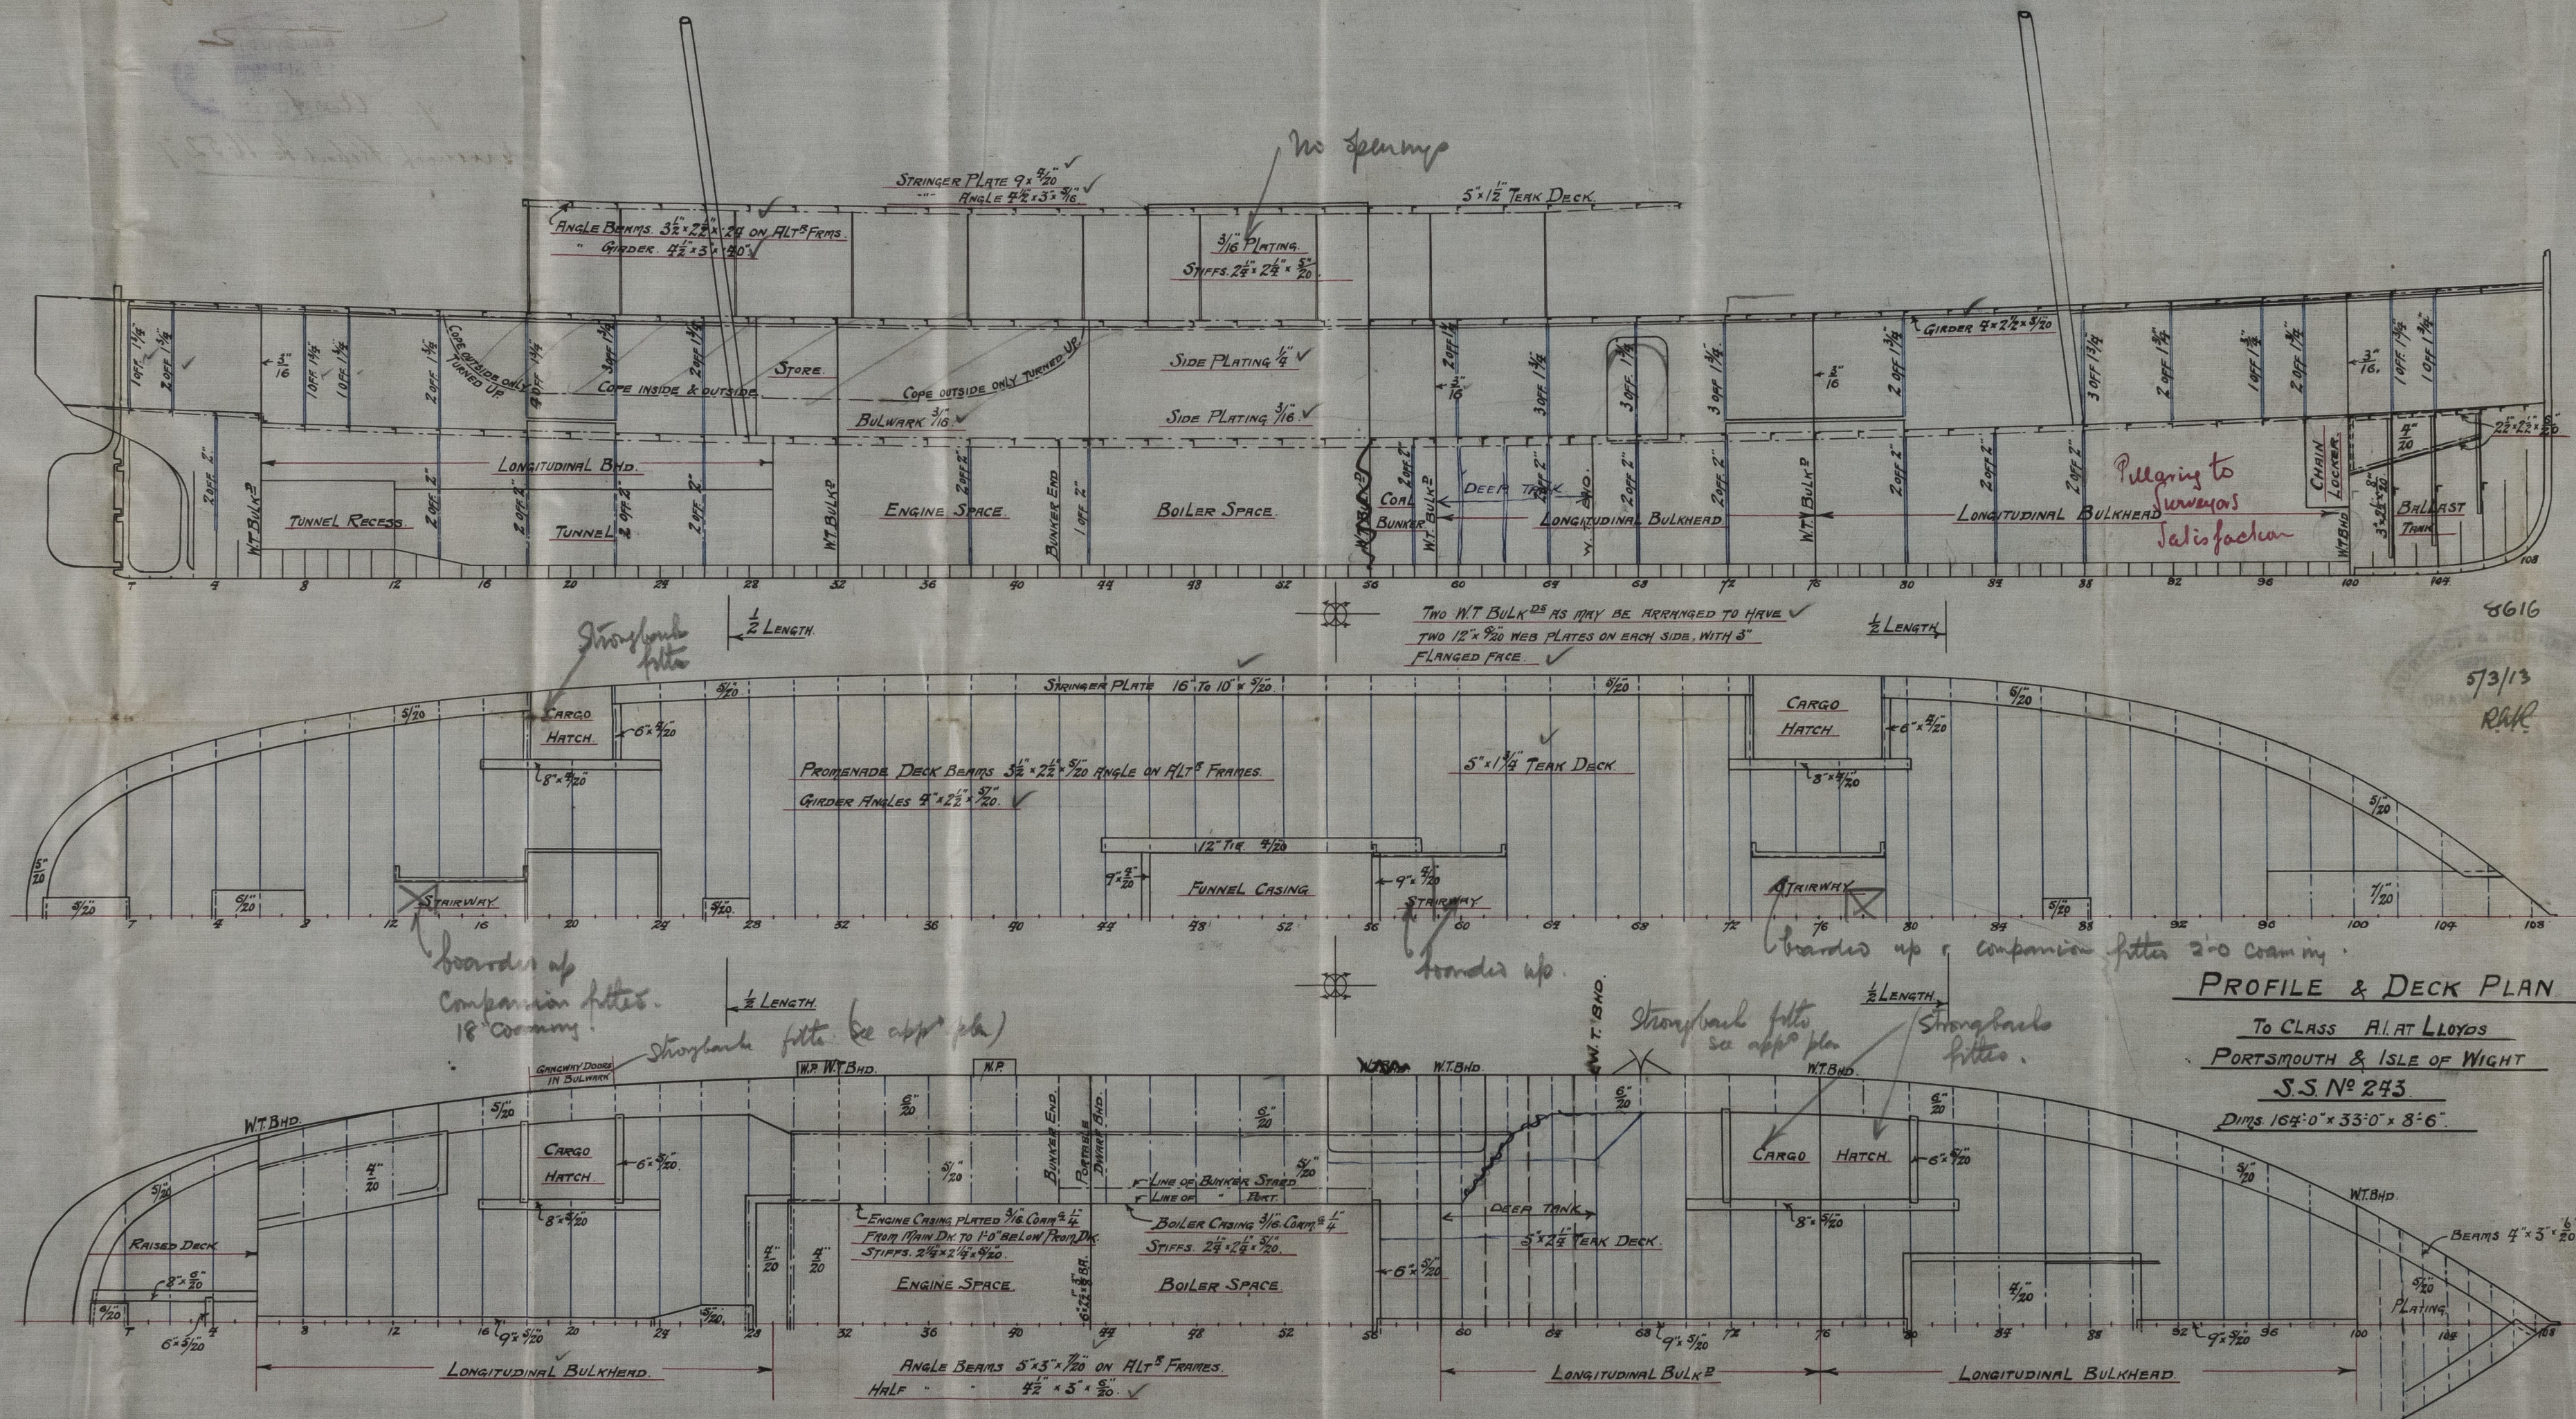

PROFILE & DECK PLAN

TO CLASS A.I. AT LLOYDS
PORTSMOUTH & ISLE OF WIGHT
J.S. No 243
DIMS 164'0" x 33'0" x 8'6"

Scale 1/8" = 1 Foot
Drawing No


10.3.13

S/s. N^o 243.

Profile & Deck

Messrs.

Murdoch & Murray.

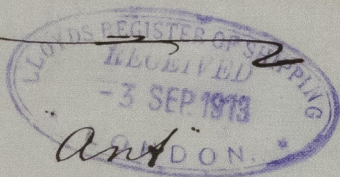

S/s.

Ant

Greenock Repert. No. 16527

© 2020

Lloyd's Register
Foundation

004418-004427-0272