


LOOKING AF

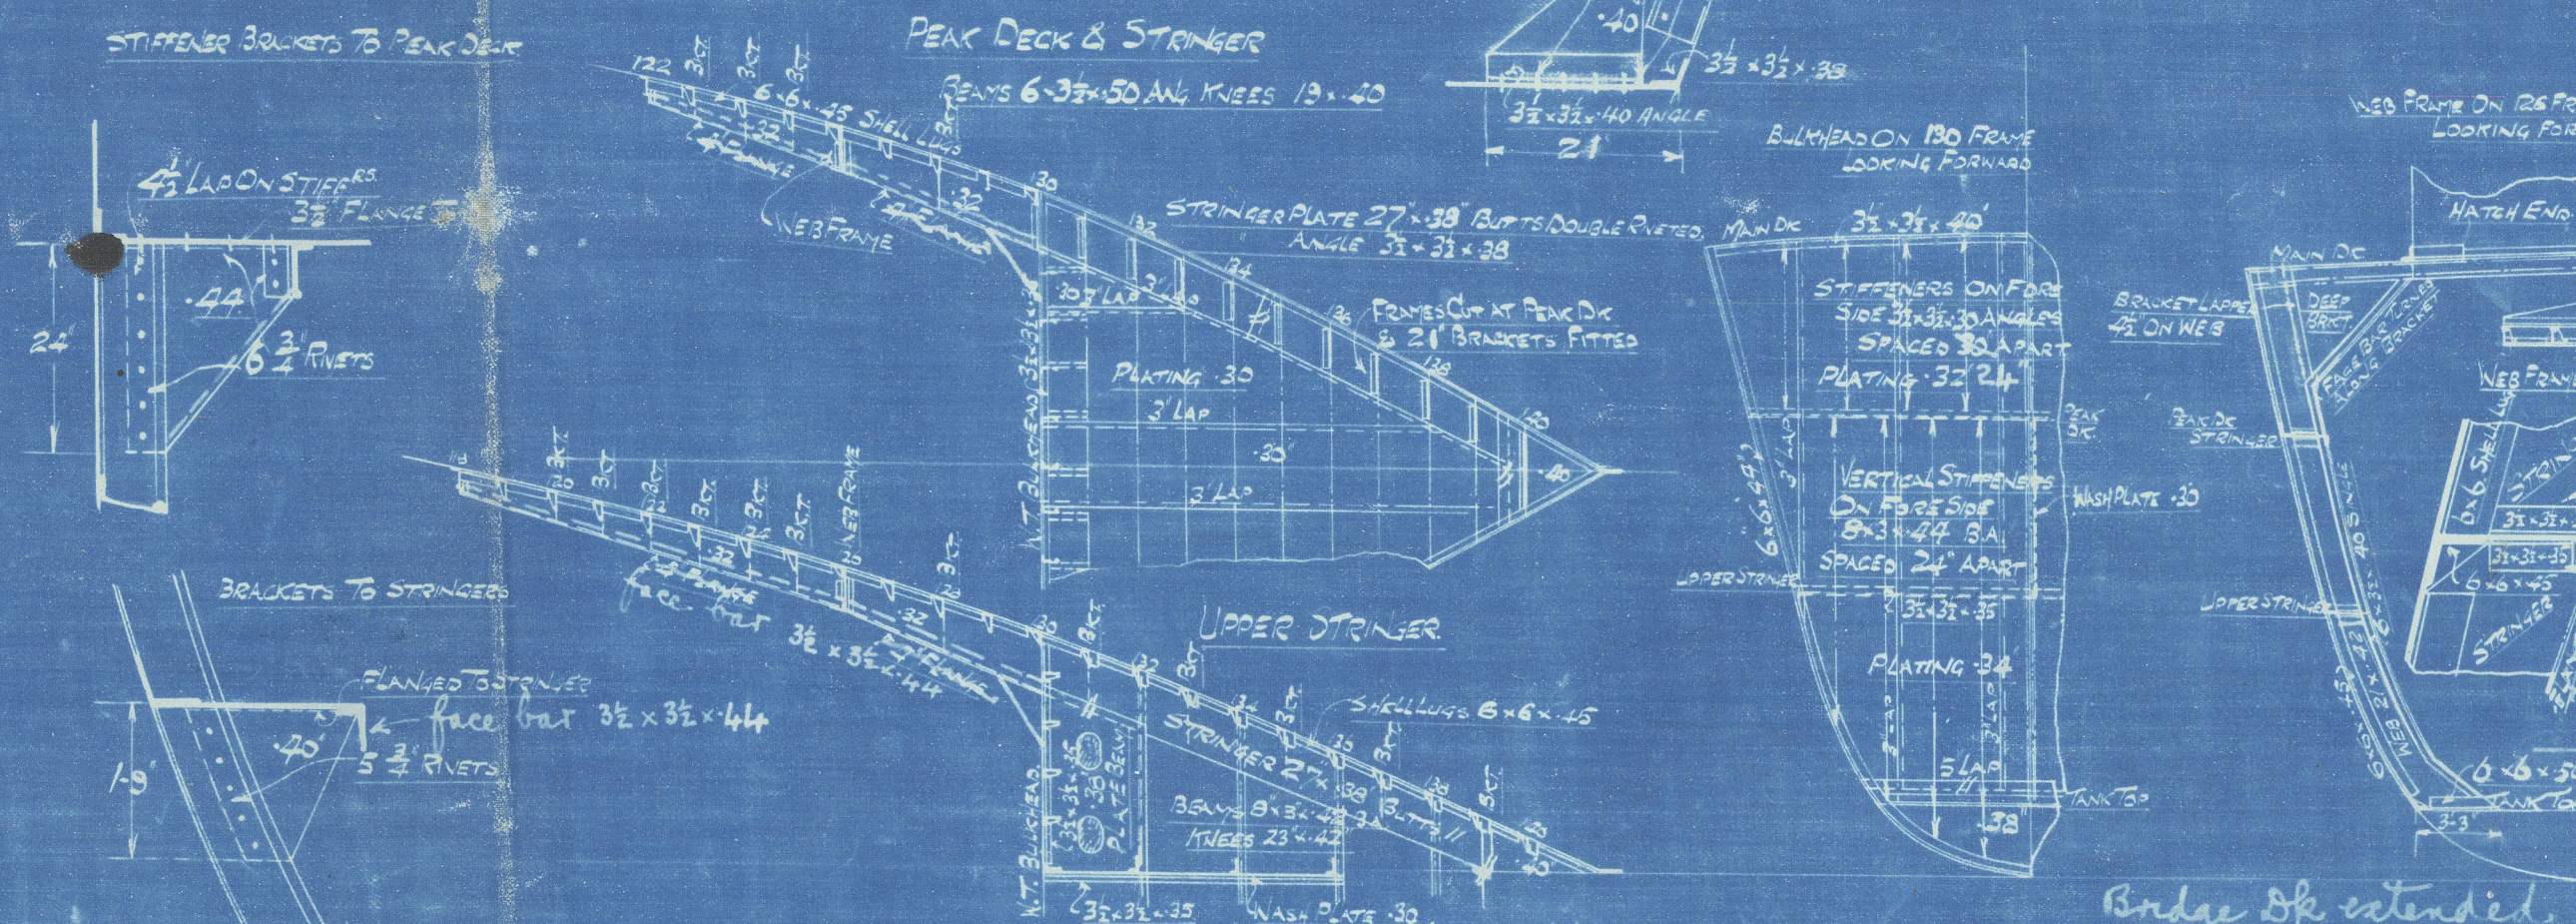

SKETCH OF DOUBLE BOTTOM



W. Gray & Co  
Profile & Deck Plans.

No 900 & 901



Standard D.

S.S. "WAR TORPEDO" No 900

Hpl. Rept. No 15521. ~~15529~~

S.S. War Shell No 901.

Hpl. 15529.

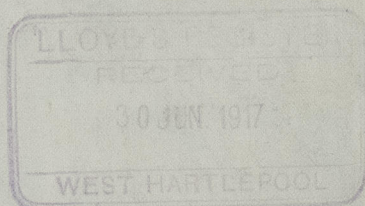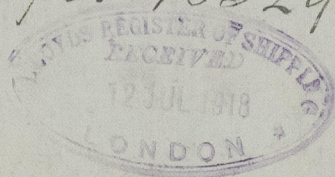

© 2021

Lloyd's Register  
Foundation