

- 100 A ♣ 3 DECK RULE -WITH FREEBOARD-



- RIVETING.
BUTTS OF SHELL PLATING BETWEEN KEEL & SHELLSTRAKE LAPPED & TREBLE RIVET WHERE INSIDE STRAKES EXCEED 54" & OUTSIDE 46" TO BE QUADRUPLE LAPPED. TANK TOP PLATING, BUTTS LAPPED & DOUBLE RIVETED FOR 6" LEN SINGLE AT ENDS.

LR

MESSRS. S. P. AUSTIN & SON LTD.

S.S. N° 216 = SS Edith

MIDSHIP SECTION

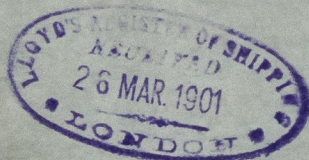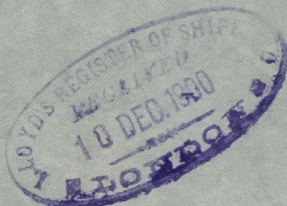

Sec Letter = 11-9-00

Sunderland N° 20718

009451-009458-0050



© 2020

Lloyd's Register
Foundation