
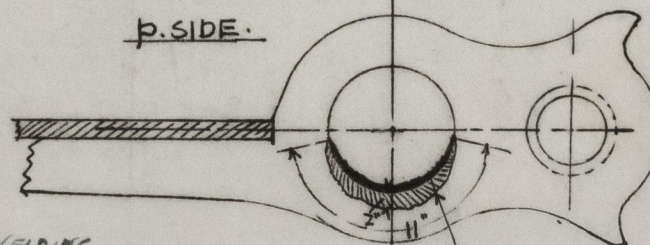
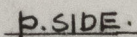


REPAIRED SKETCHES OF RUDDER

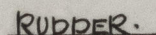

S. SIDE.

OLD E. WELDING
FRACTURED
✓ CORRODED
PART

~~CHIPPED &~~
~~ARC WELDED~~
QUASI ARC.
SYSTEM

