

009451-009458-0233

PLAN No. 1751
 FOR ENCLOSURE TO
 Messrs. Lloyd's Surveyors
 Hull
 FROM
 COCHRANE & SONS,
 SHIPBUILDERS, SELBY.
 DATE 15/7/12 *RR*

MIDSHIP SECTION

STEEL SCREW TRAWLER


Nº 522 & 537

DIMS 115'-0" B.P. x 21'-6" EXT. x 12'-6" MLD

SCALE 1/2" = ONE FOOT.

TO CLASS 100.A.1. FOR FISHING PURPOSES.

DECK PLATED OVER IN WAY OF MACHINERY SPACE
 ENGINE & BOILER CASING AS PREVIOUSLY ARRANGED.

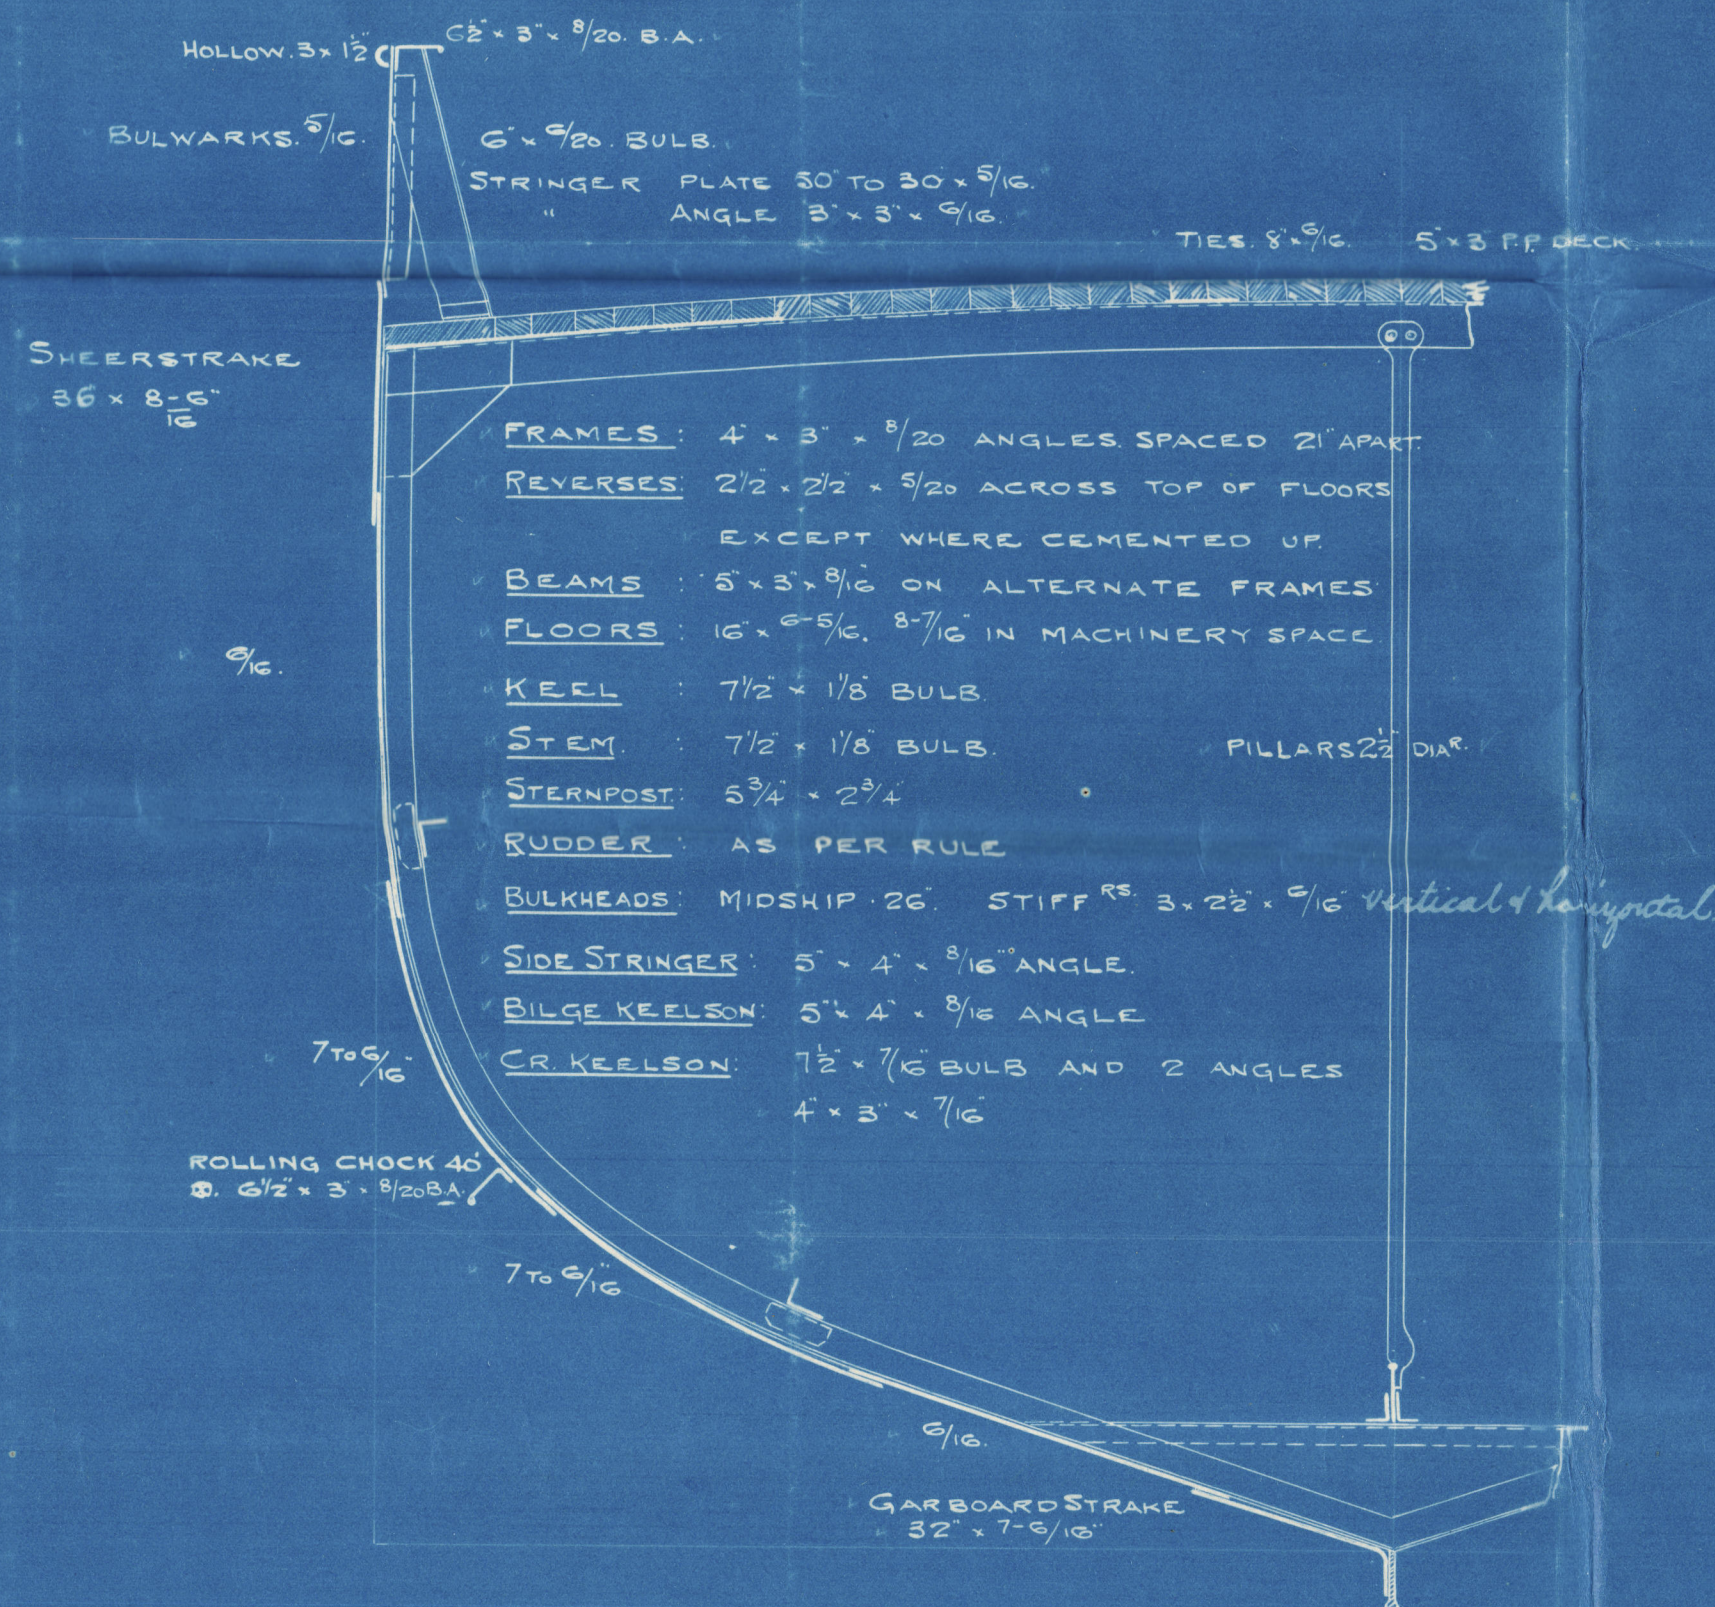

NUMERALS

B + D. --- 33.86
 L x (B + D) --- 38.93.

PROPORTIONS.

✓ $\frac{L}{B}$ --- 3.20
 $\frac{L}{D}$ --- 5.38

EQUIPMENT

ST. BOWER ANCHOR	5 CWTs EX STOCK OR 6 1/4 STOCKLESS
2 ND " "	4 1/2 " " " 5 1/2
KEDGE ANCHOR	2 1/2 " " " "
90 FATHOMS	1" CABLE
60 " "	5/2" HAWSER
60 " "	4" WARP

RIVETING.

BUTTS OF SHELL PLATING LAPPED & DOUBLE RIVETED
 EXCEPT GARB. & SHEER STRAKE WHICH ARE TO BE
 STRAPPED & DOUBLE RIVETED. LANDING EDGES DOUBLE
 RIVETED EXCEPT TOP EDGE OF SHEER STRAKE WHICH
 IS TO BE SINGLE RIVETED
 BUTTS OF STRINGER & TIE PLATES LAPPED & DOUBLE RIV.

C.B.
5.1.12.

Wm. Cochrane & Sons
16255-231
Wm. Cochrane & Sons



© 2020
 Lloyd's Register
 Foundation

009451-009458-0233

Cochrane & Sons.

No. 522 & 537

Duplicate

Midship Section

of Emmanuel Hall Reports No. 25276

Lead Ex 25517



© 2020

Lloyd's Register
Foundation

009451-009458-0233