



23.4.06  
19.6.06



N<sup>os</sup> 285 & 6.  
PROFILE & DECK PLANS  
SCALE 1/8" = ONE FOOT.  
DIMENSIONS: 376'-0" B.P. x 52'-0" x 28'-0" M<sup>to</sup> SPAR DECK  
20'-0" M<sup>to</sup> MAIN DECK  
TO CLASS 100 A1 AT LLOYD'S SPECIAL SURVEY SPAR DECK RULE  
WITH 3 DECK MINIMUM FREE BOARD.

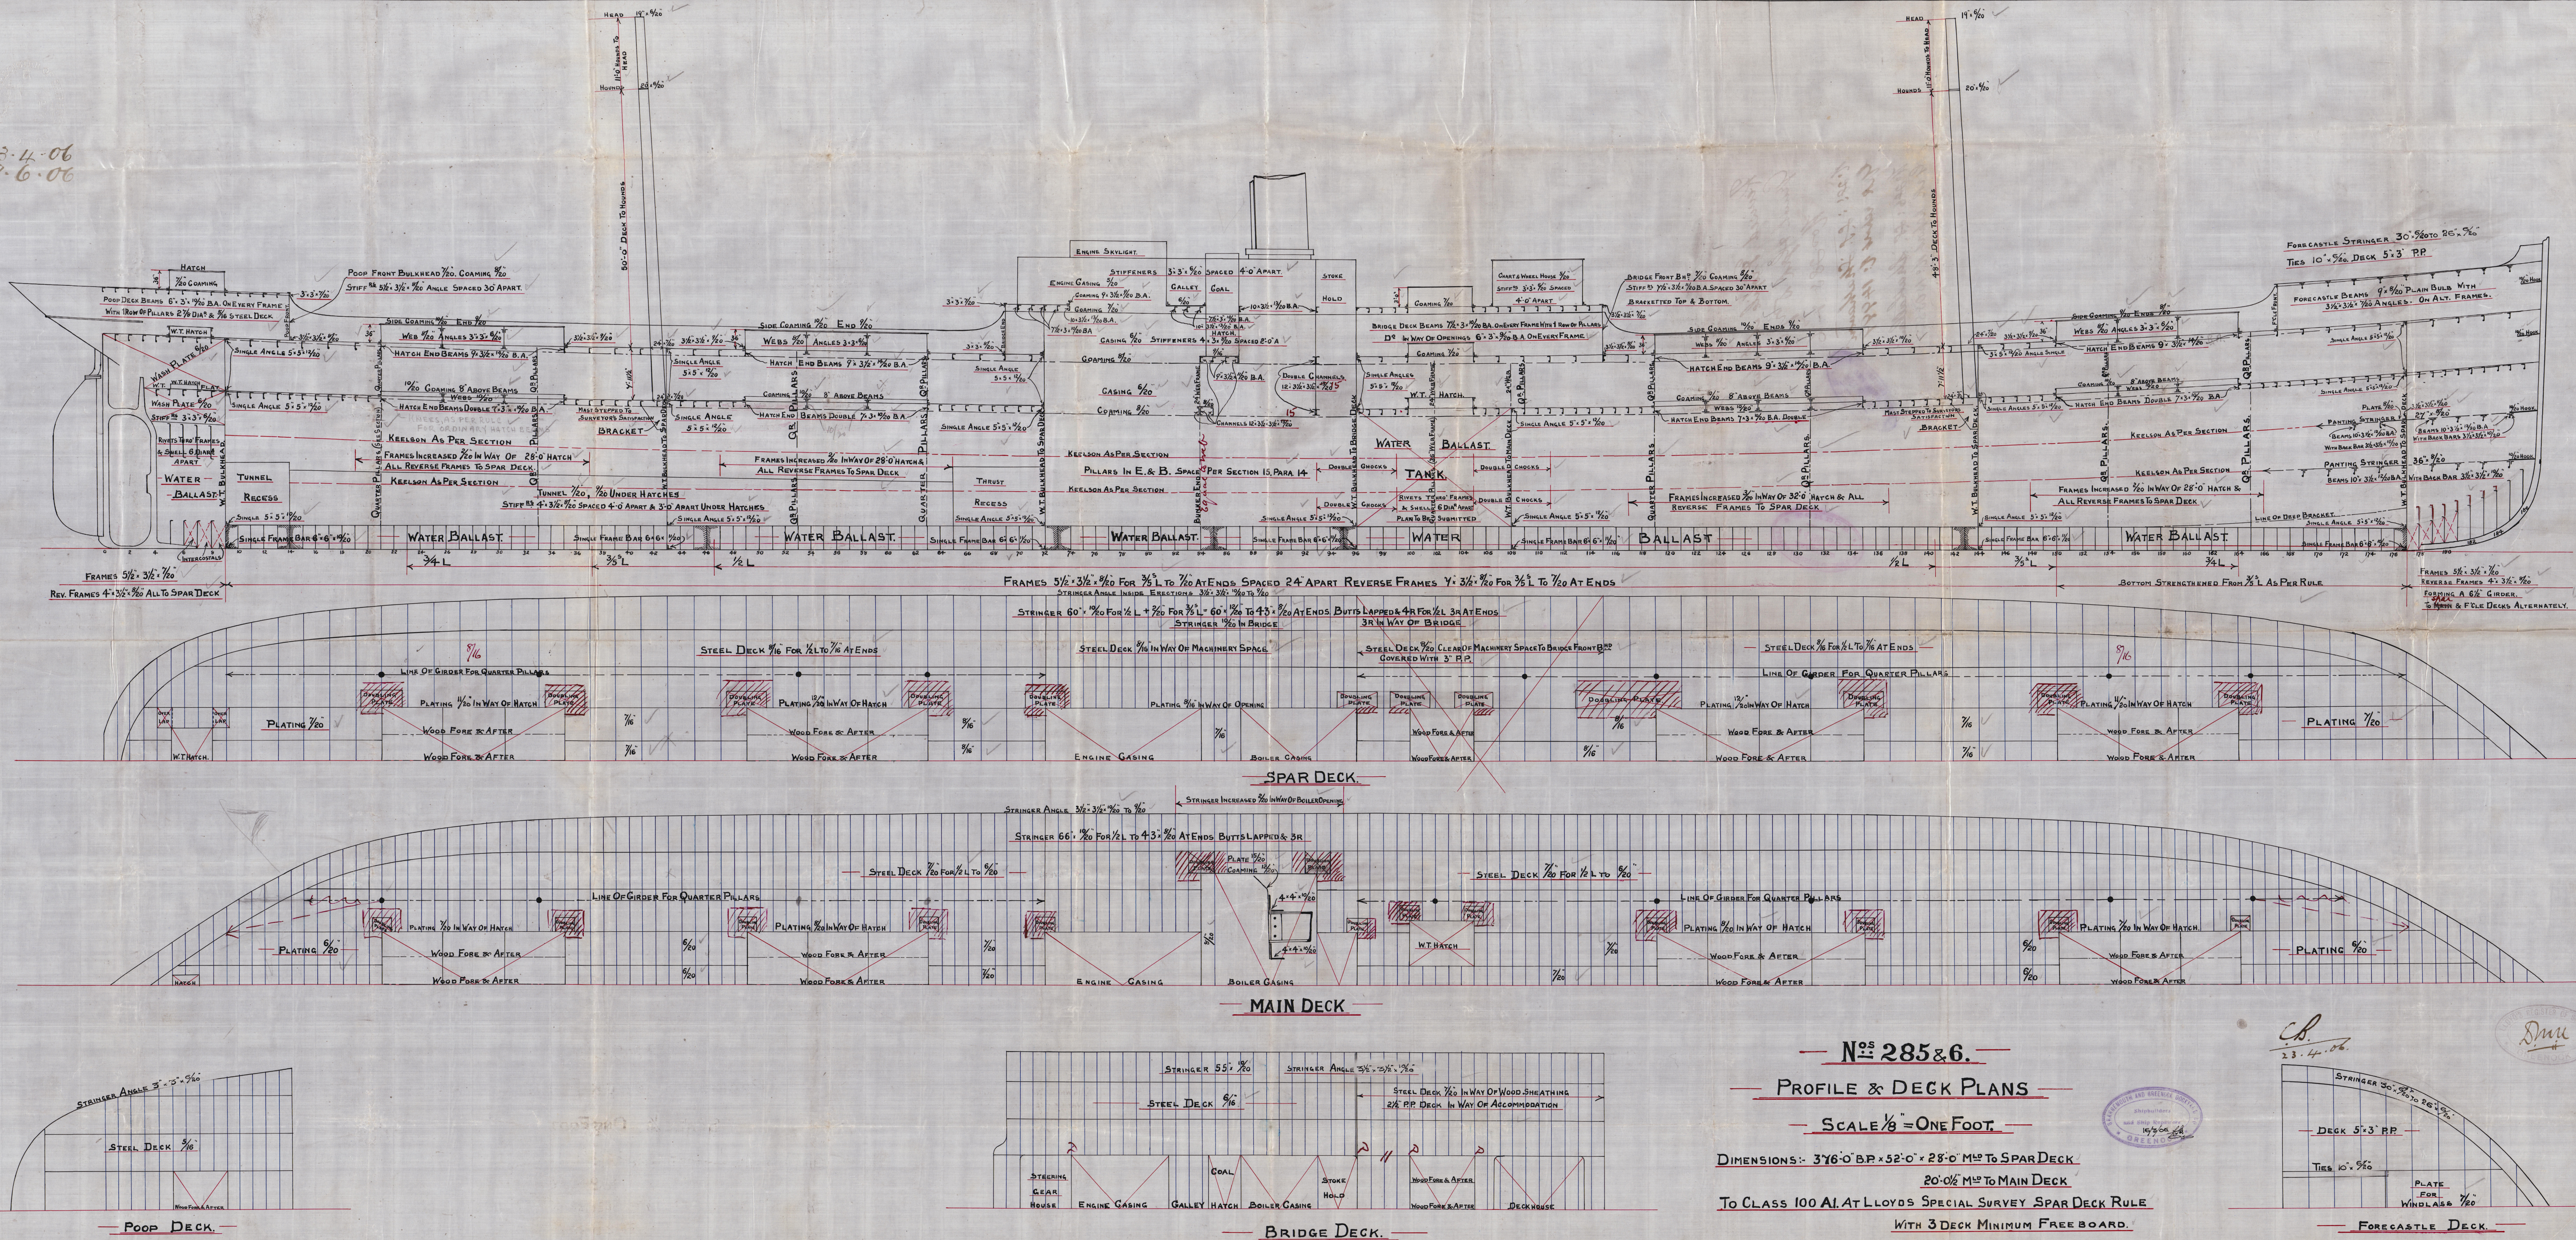

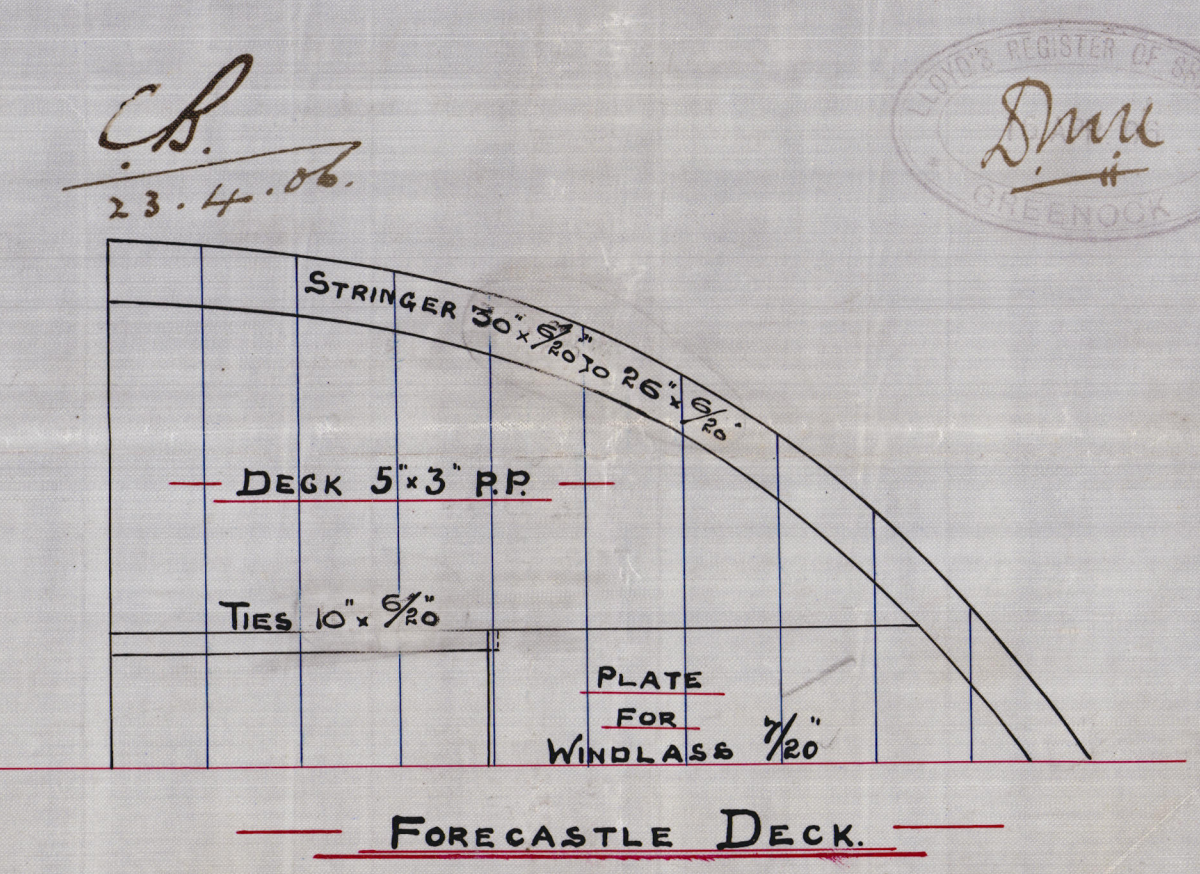


Revised Profile Sk plan  
Gravel & Gravel Co

No 285 & 6

No 285: L.S. Skathallan  
Gravel report No 14989

No 286: L.S. Skathallan  
Gravel report No 15055

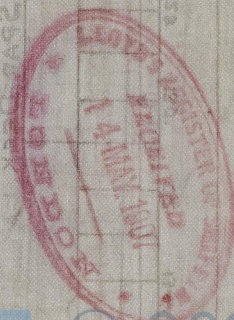

© 2020

Lloyd's Register  
Foundation