
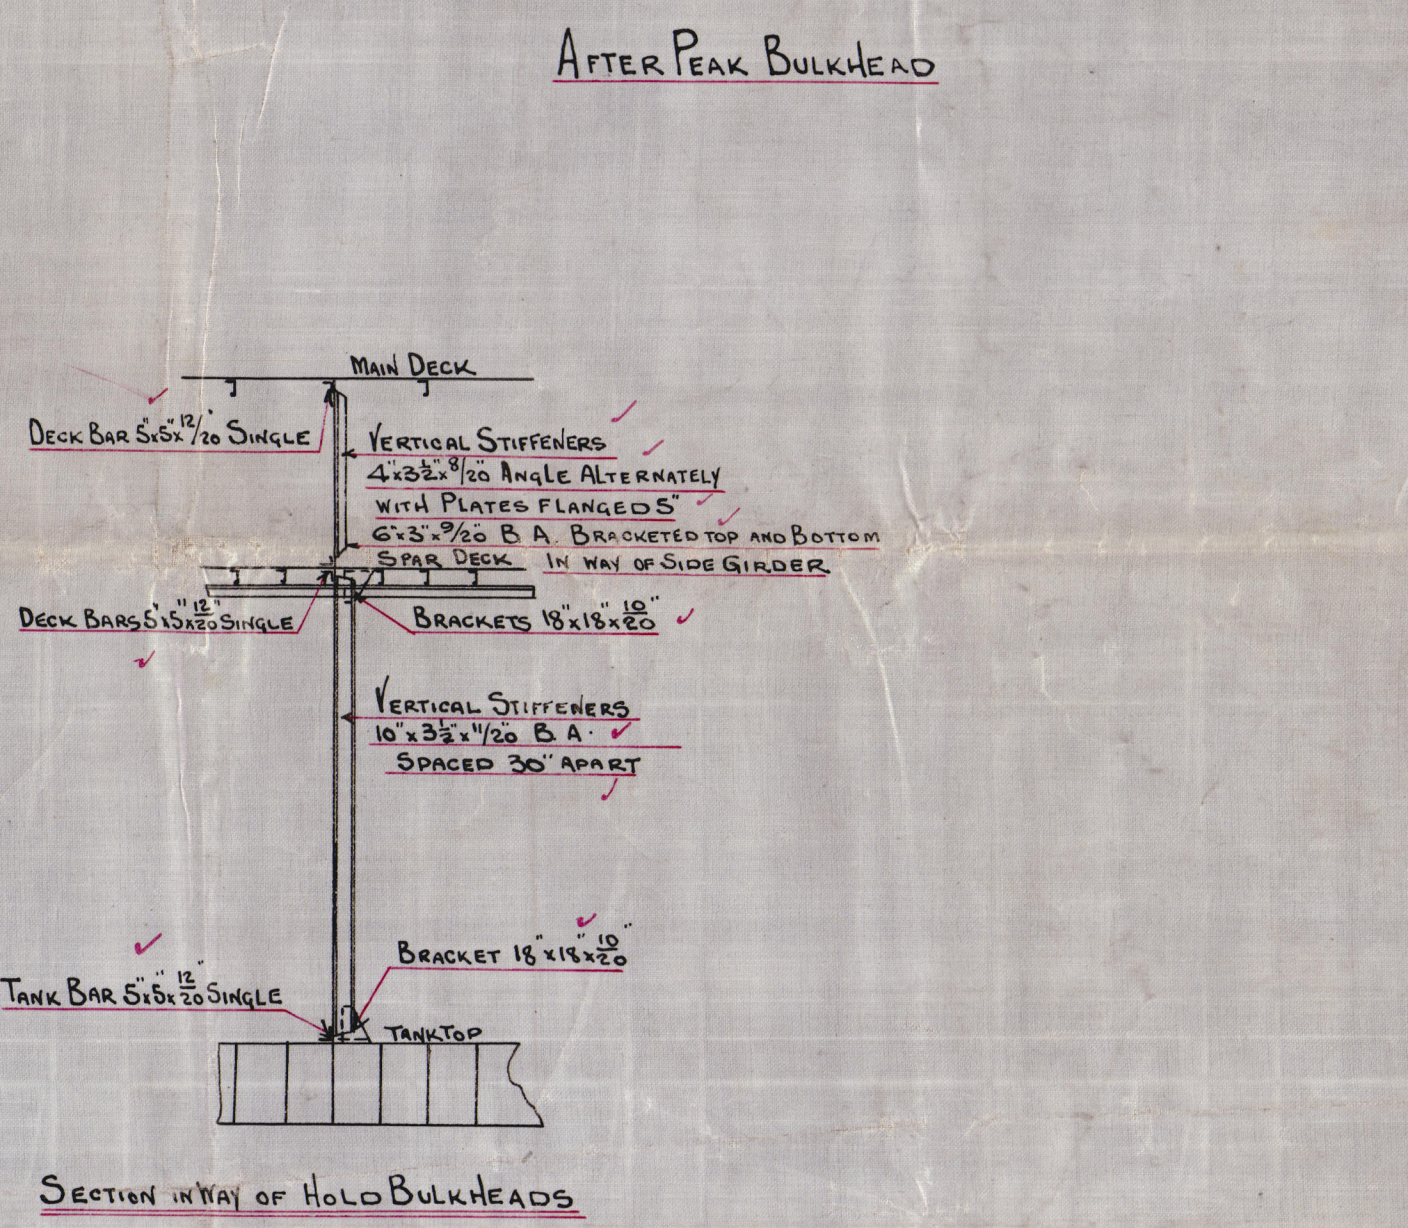
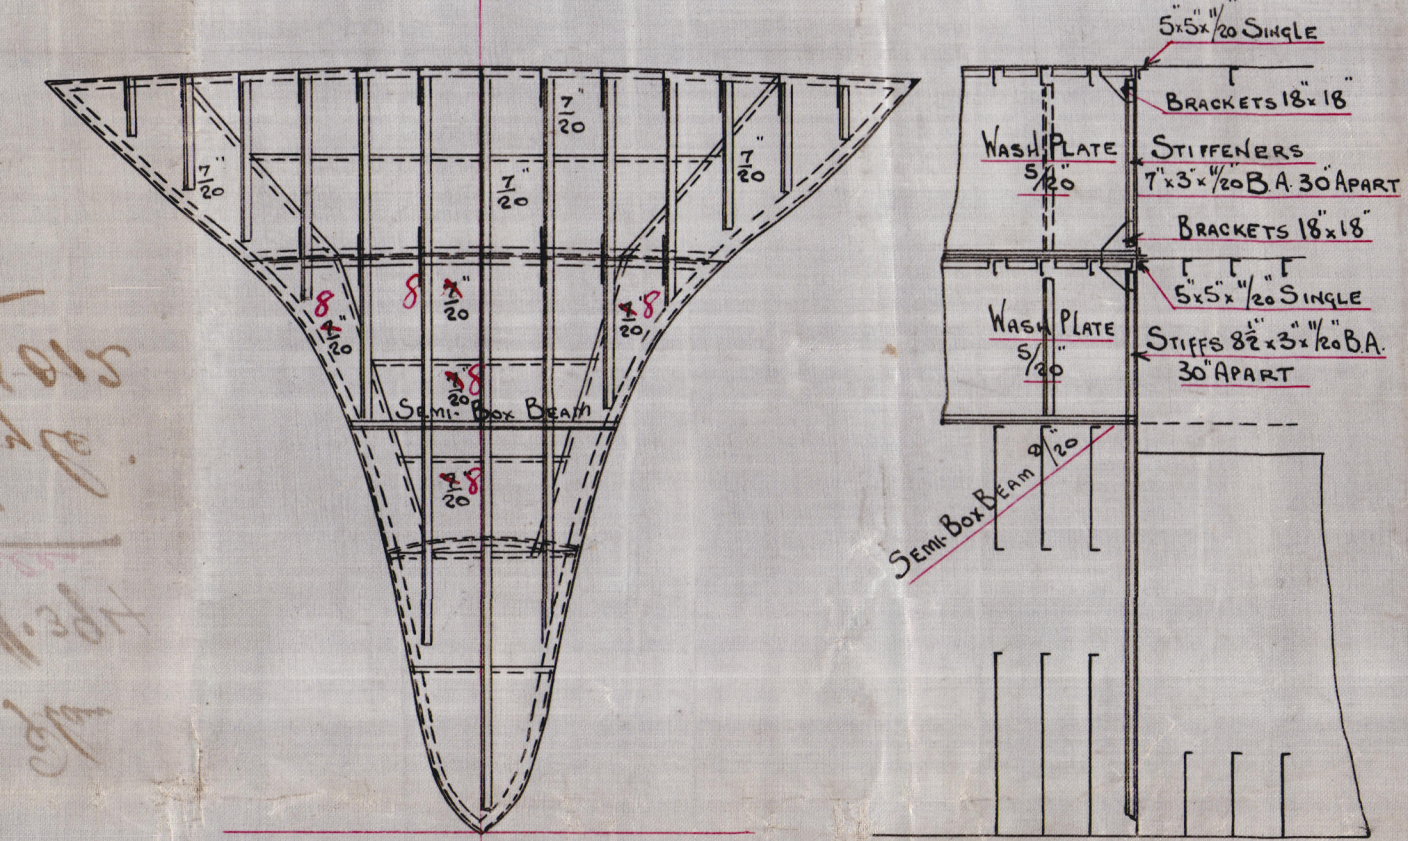


23. 10. 05

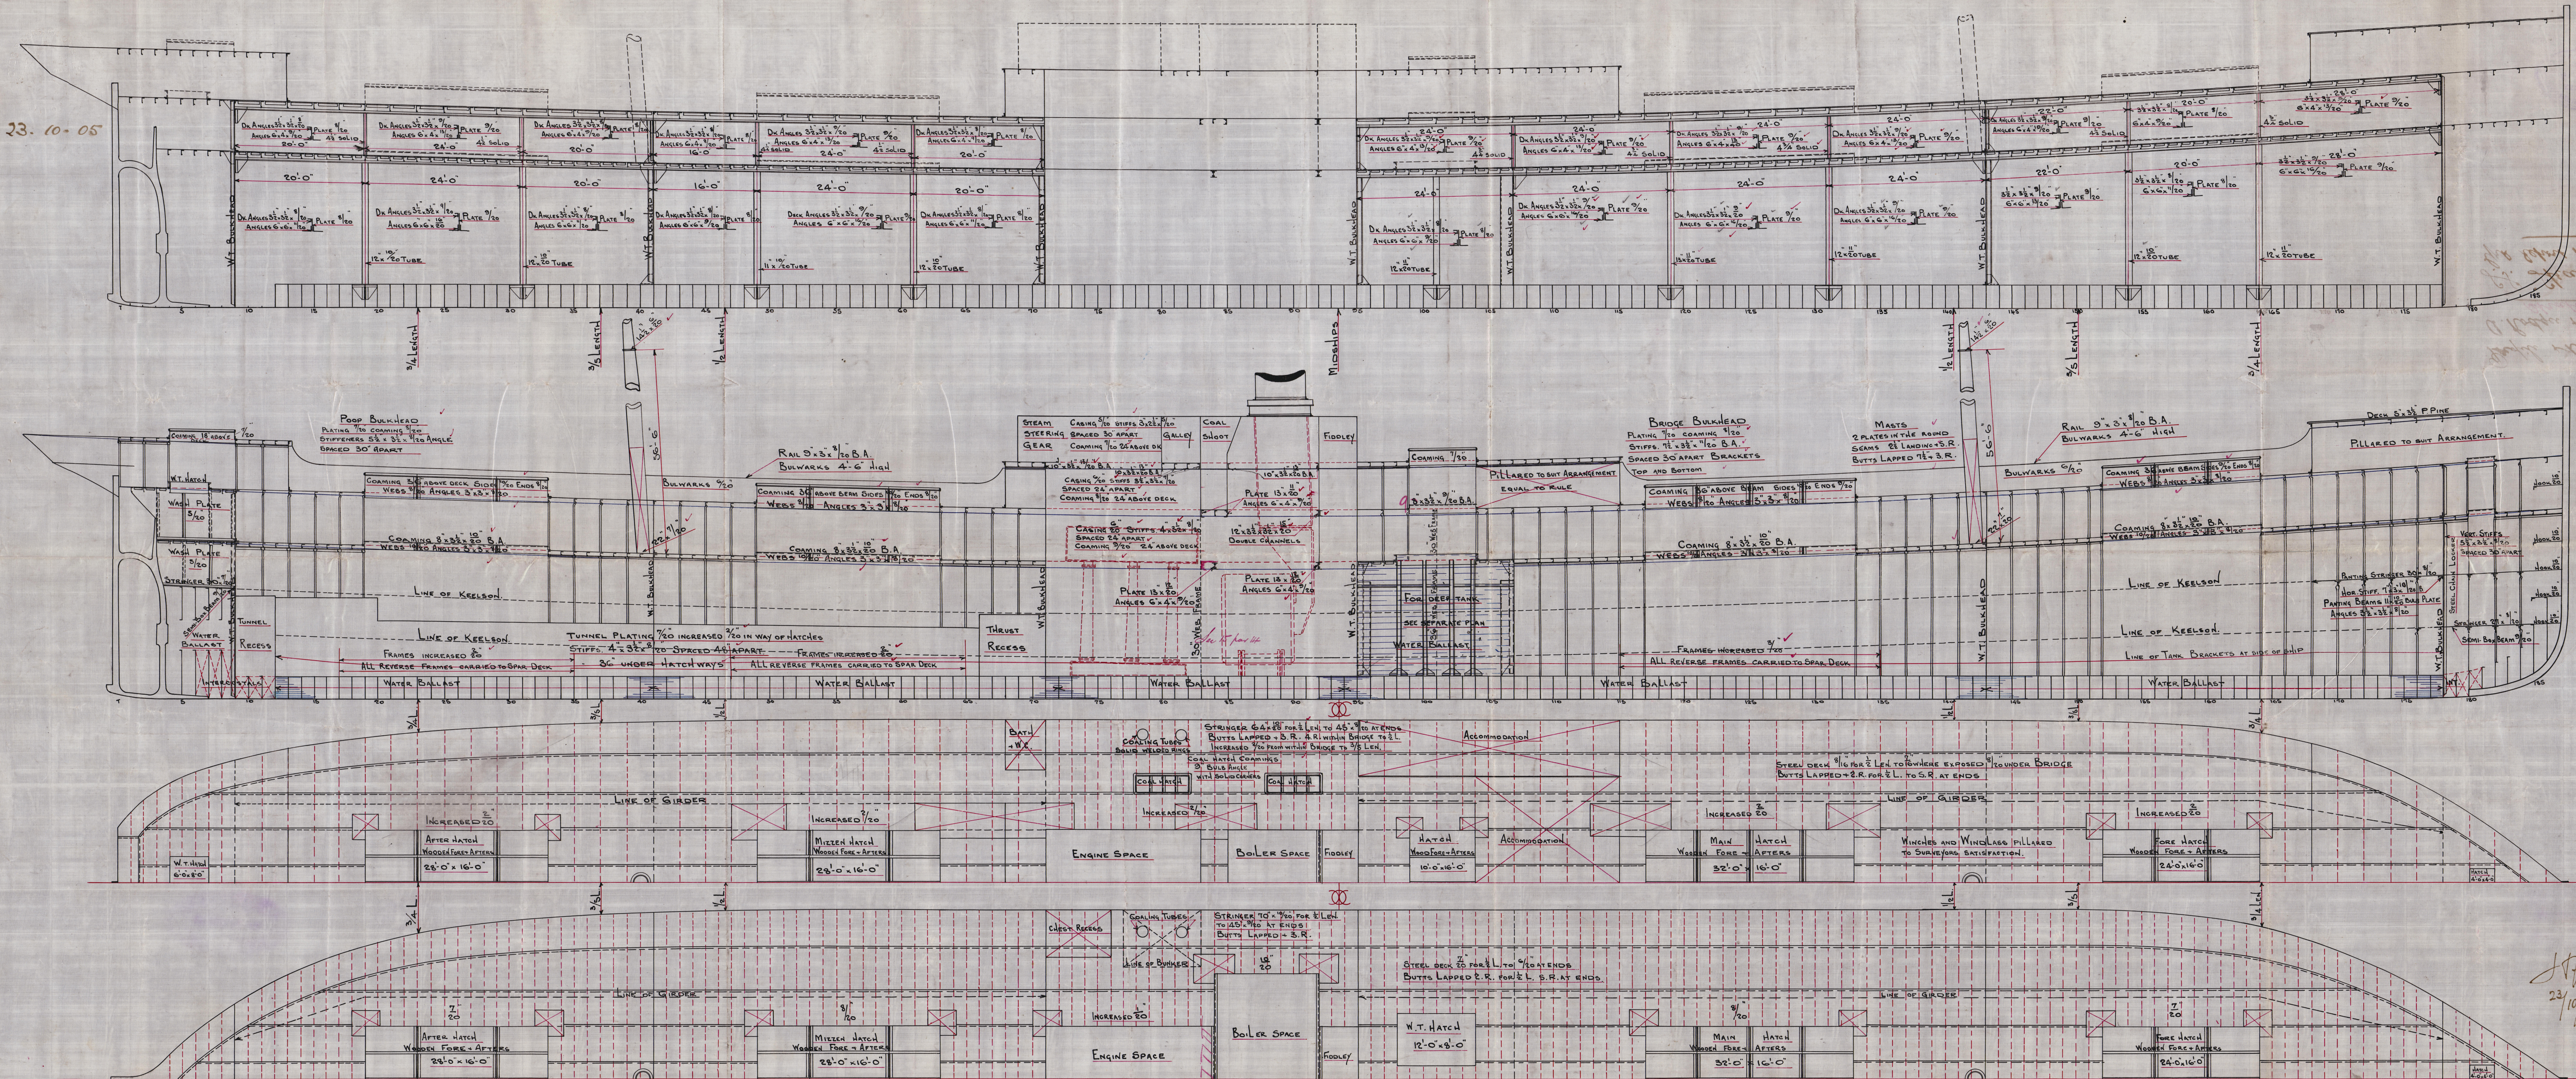

PROFILE AND DECK PLAN  
S.S. No 334  
Scale 1/8" = 1' 0"  
Dims 376'-0" x 52'-0" x 26'-0" MLO

RODGER & CO.  
DRAWING  
18 OCT. 05  
PORT-GLASGOW

23/10/05



Profile & Dr. Plan  
A. Rodger & L. N. 394  
Strathgyle

S. S. Strathgyle.  
Grd Report N. 15012



© 2020

Lloyd's Register  
Foundation

009469-009480-009481