

№ 122.

MIDSHIP SECTION.

NUMERALS

$\frac{1}{2}$ BREATH --- 10.75

$\frac{1}{2}$ GIRTH ----- 19.33

DEPTH-----13.25

IST: No: --- 43.33

LENGTH ----- 113.87

2nd No ----- 4933.98

Dt. L 8.59

B to L 5-29

OF A

STEEL SCREW TRAWLER.

DIMS: 115'-0" x 21'-6" x 12'-9" MOULDED.

TO CLASS 100A1 LLOYDS.

FOR FISHING PURPOSES.

FLUSH DECK, NO ERECTIONS.

SCALE $\frac{1}{2}" \approx 1 \text{ Foot}$

EQUIPMENT N° 4933

ANCHOR 5 C WTS: EX STOCK


1	"	$4\frac{1}{2}$	"	"	"
---	---	----------------	---	---	---

1	"	2 1/2	"	"	"
---	---	-------	---	---	---

90 FATHOMS | STUD LINK CABLE

60 " 5 $\frac{1}{2}$ " HAWSER

60 " 4 WARP

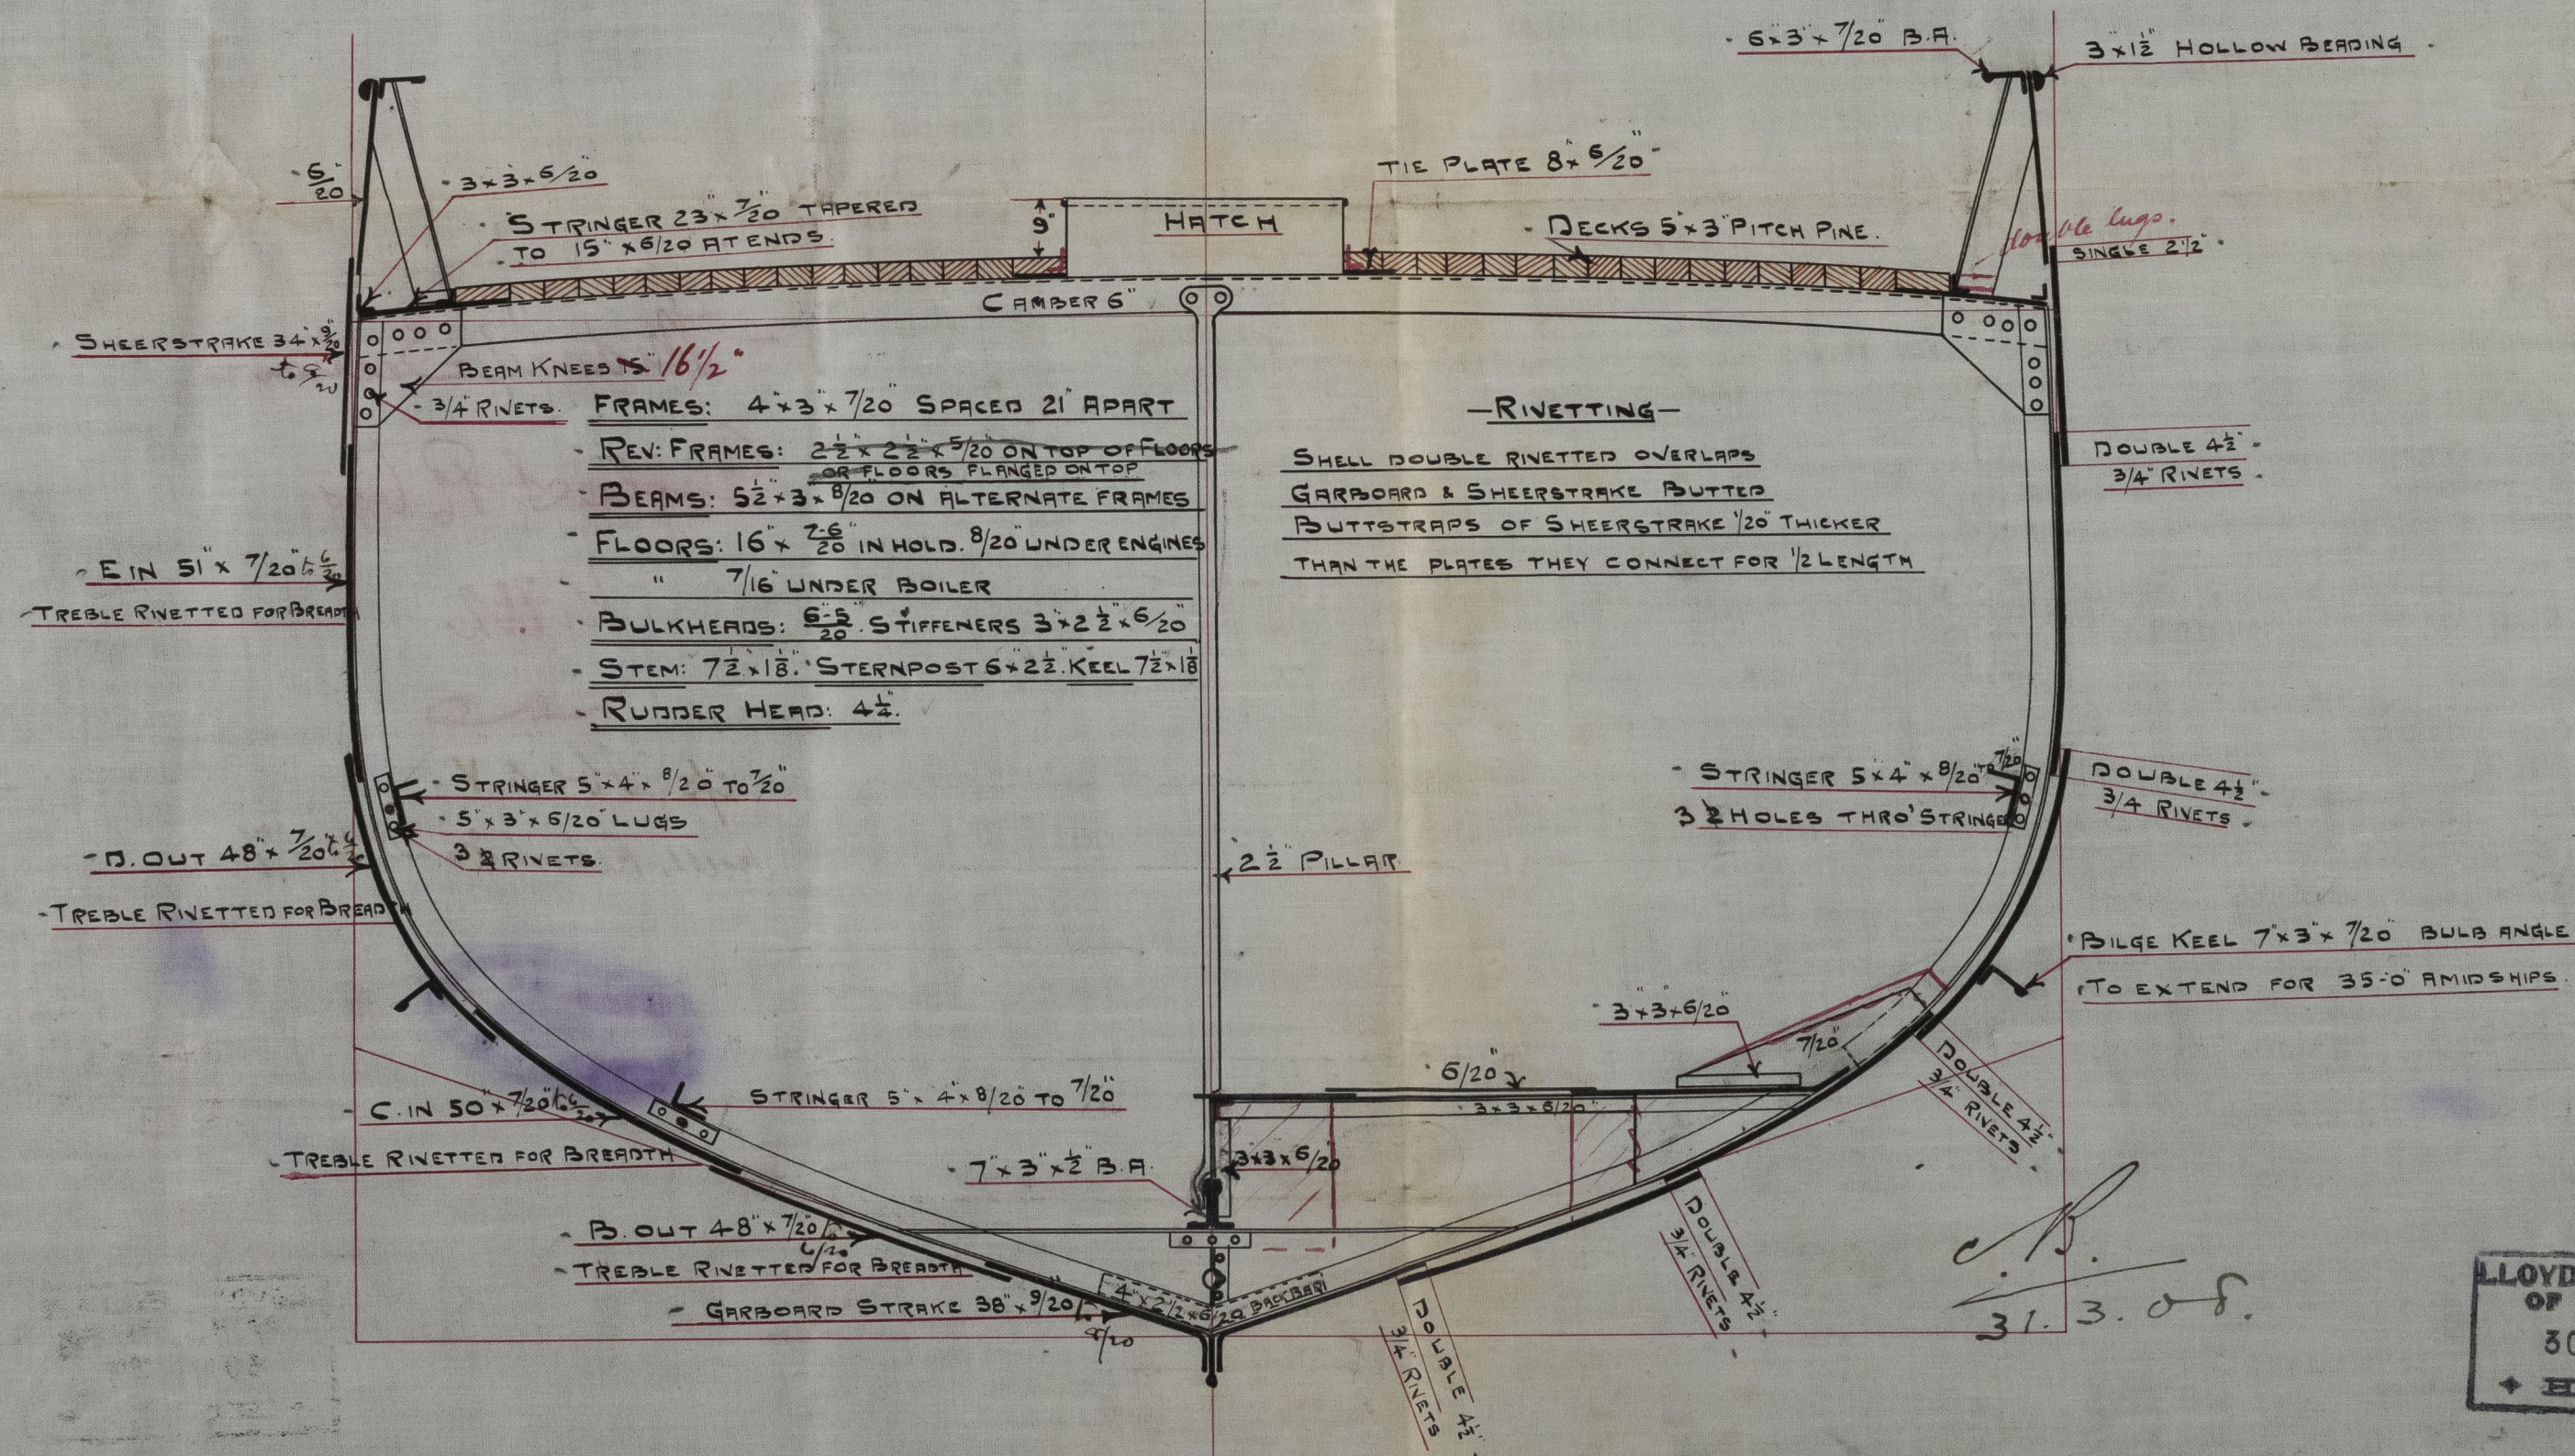

LLOYD'S REGISTER
OF SHIPPING
30 MAR. 1908
HULL

© 2021

Lloyd's Register
13-0064
Foundation

009505-009513-0064

- Midship Section -

Goole S. R. Co.

No 122

s/s Ibis V

Hull Report No 20.447



004505-009513-0064



© 2021

Lloyd's Register
Foundation