
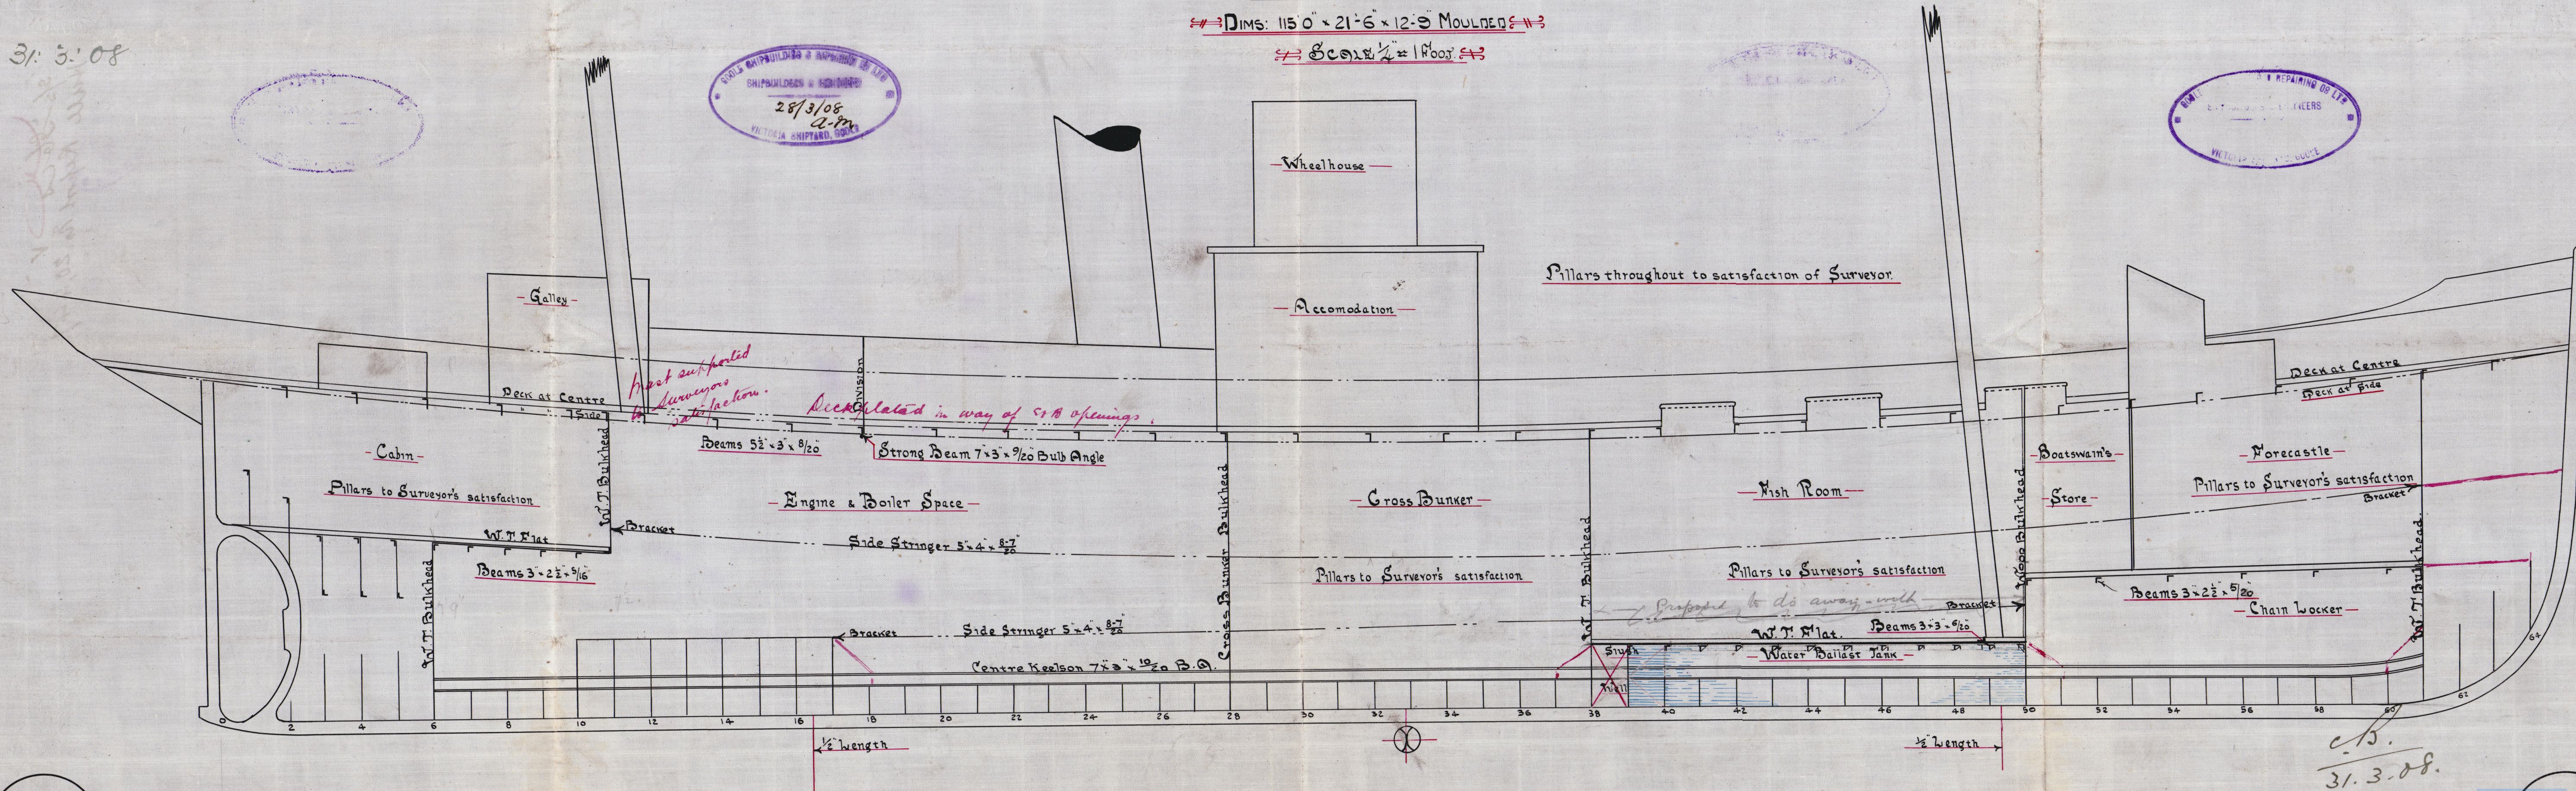
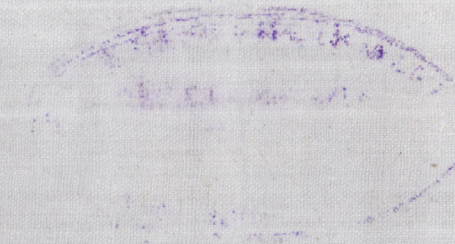


No. 122. ELEVATION

DIMS: 115' 0" x 21' 6" x 12' 3" MOULDED

Scale 1/4" = 1 Foot

31.3.08

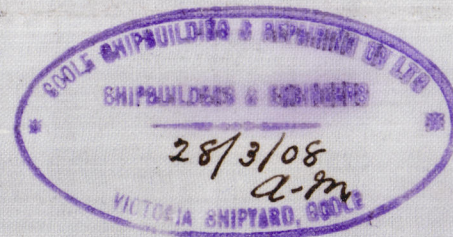

© 2004
LLOYD'S REGISTER
OF SHIPPING
50 MAR 1908
HULL

004505-009513-0065

-Profile + Deck Plan-

Goole S. P. Co.

No 122

s/s ~~St. V.~~
Hull Report No. 20,447

009505-009513 0065



© 2021

Lloyd's Register
Foundation