


SCALE 1/8 IN. TO 1 FT.

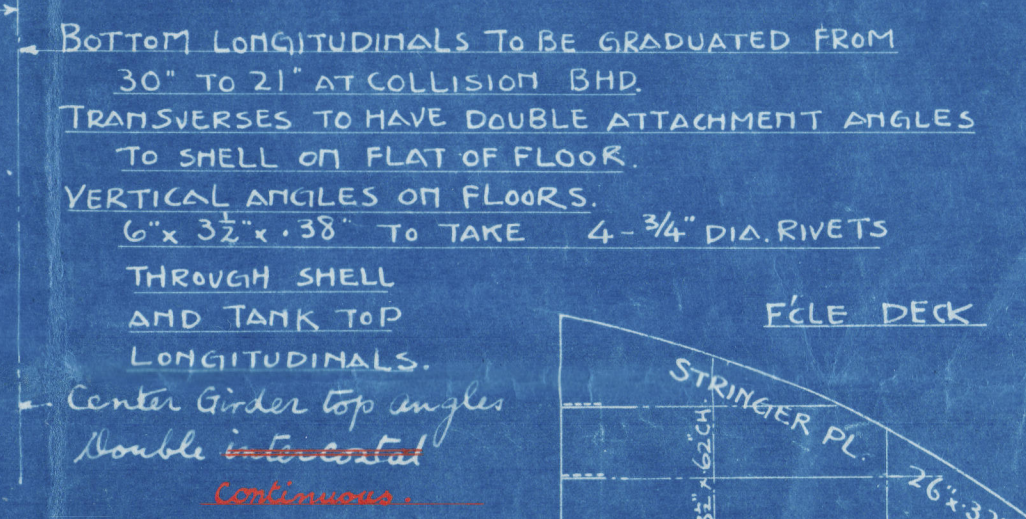

(Signed) H. J. Cox.

Copy for Lunda Office

NO 1058

S S KOJUN MARU
STRUCTURAL *the 4538,*
ARRANGEMENT

Profile & Deck



© 2021

Lloyd's Register
Foundation

00 4505-004513-01564