



# SCANTLINGS

area of support  
 14.  $3 \times .36$  where not  
 supported but cabin flat  
 or  $14 \times 3 = 42$

DIMENSIONS		FT	INS
LENGTH		160'	0"
BREADTH	MOULDED	30'	6"
DEPTH	DO	11'	9"

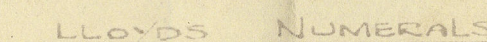

TRANSVERSE NO  $B + D = 42$  28  
LONGITUDINAL NO  $L \times (B + D) = \frac{6760}{42}$  6760  
 $L = 13.61$

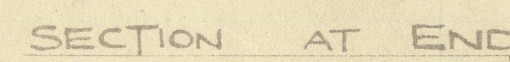

SCALE  $\frac{1}{2}$ " = ONE FOOT.

MIDSHIP SECTION N<sup>(S)</sup> 854-5

APPROVED  
LLOYDS REGISTER OF SHIPPING  
Munktoner H. Glatz  
DATE 29.19

LOBNITZ & CO LTD RENFREW.  
Nos 354-5  
Drawn by J. G. Brodie  
Checked by JMK  
DATE 23<sup>rd</sup> Aug. 19<sup>th</sup>

© 2021  
DWG NO. 15904  
Lloyd's Register  
Foundation



Labing No 854-5.

• Al Hopper Barge.

app. 2. 9. 19.

By G.W.C. No 11

Frederick Report

40158

G.W.C. No 11  
G.W.C. No 12

GLASGOW REPORT No. 40181  
Will be forwarded } 40182  
next week }



© 2021

Lloyd's Register  
Foundation

009514-009521-0089