
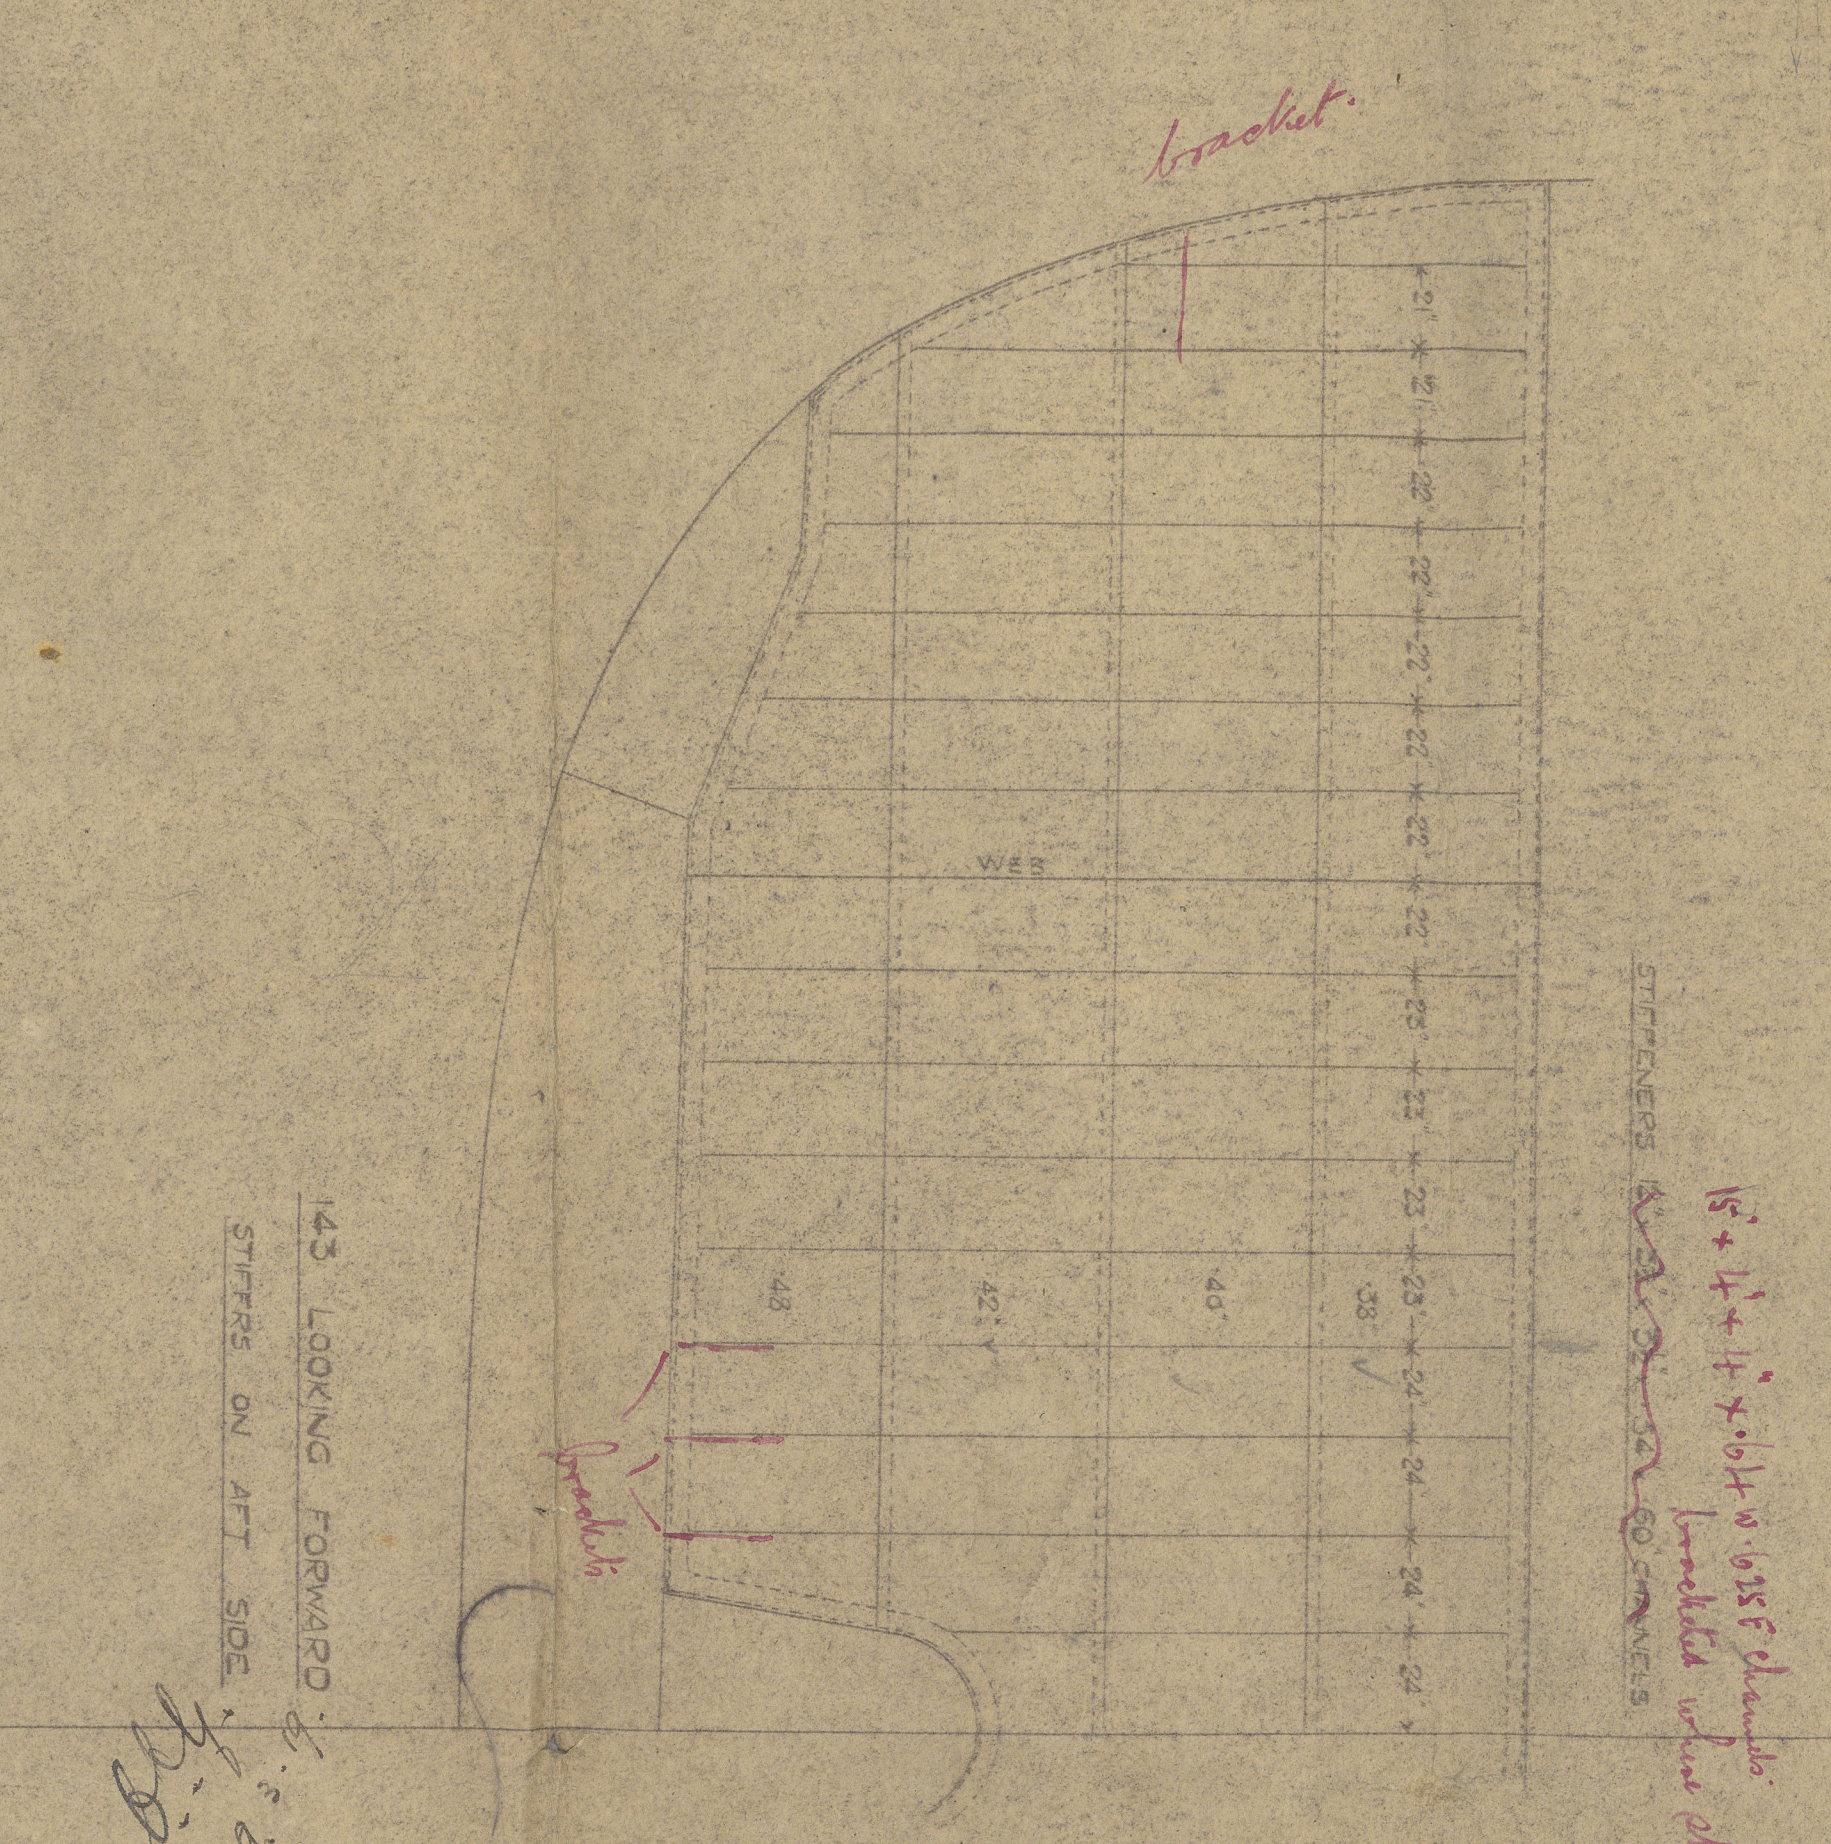
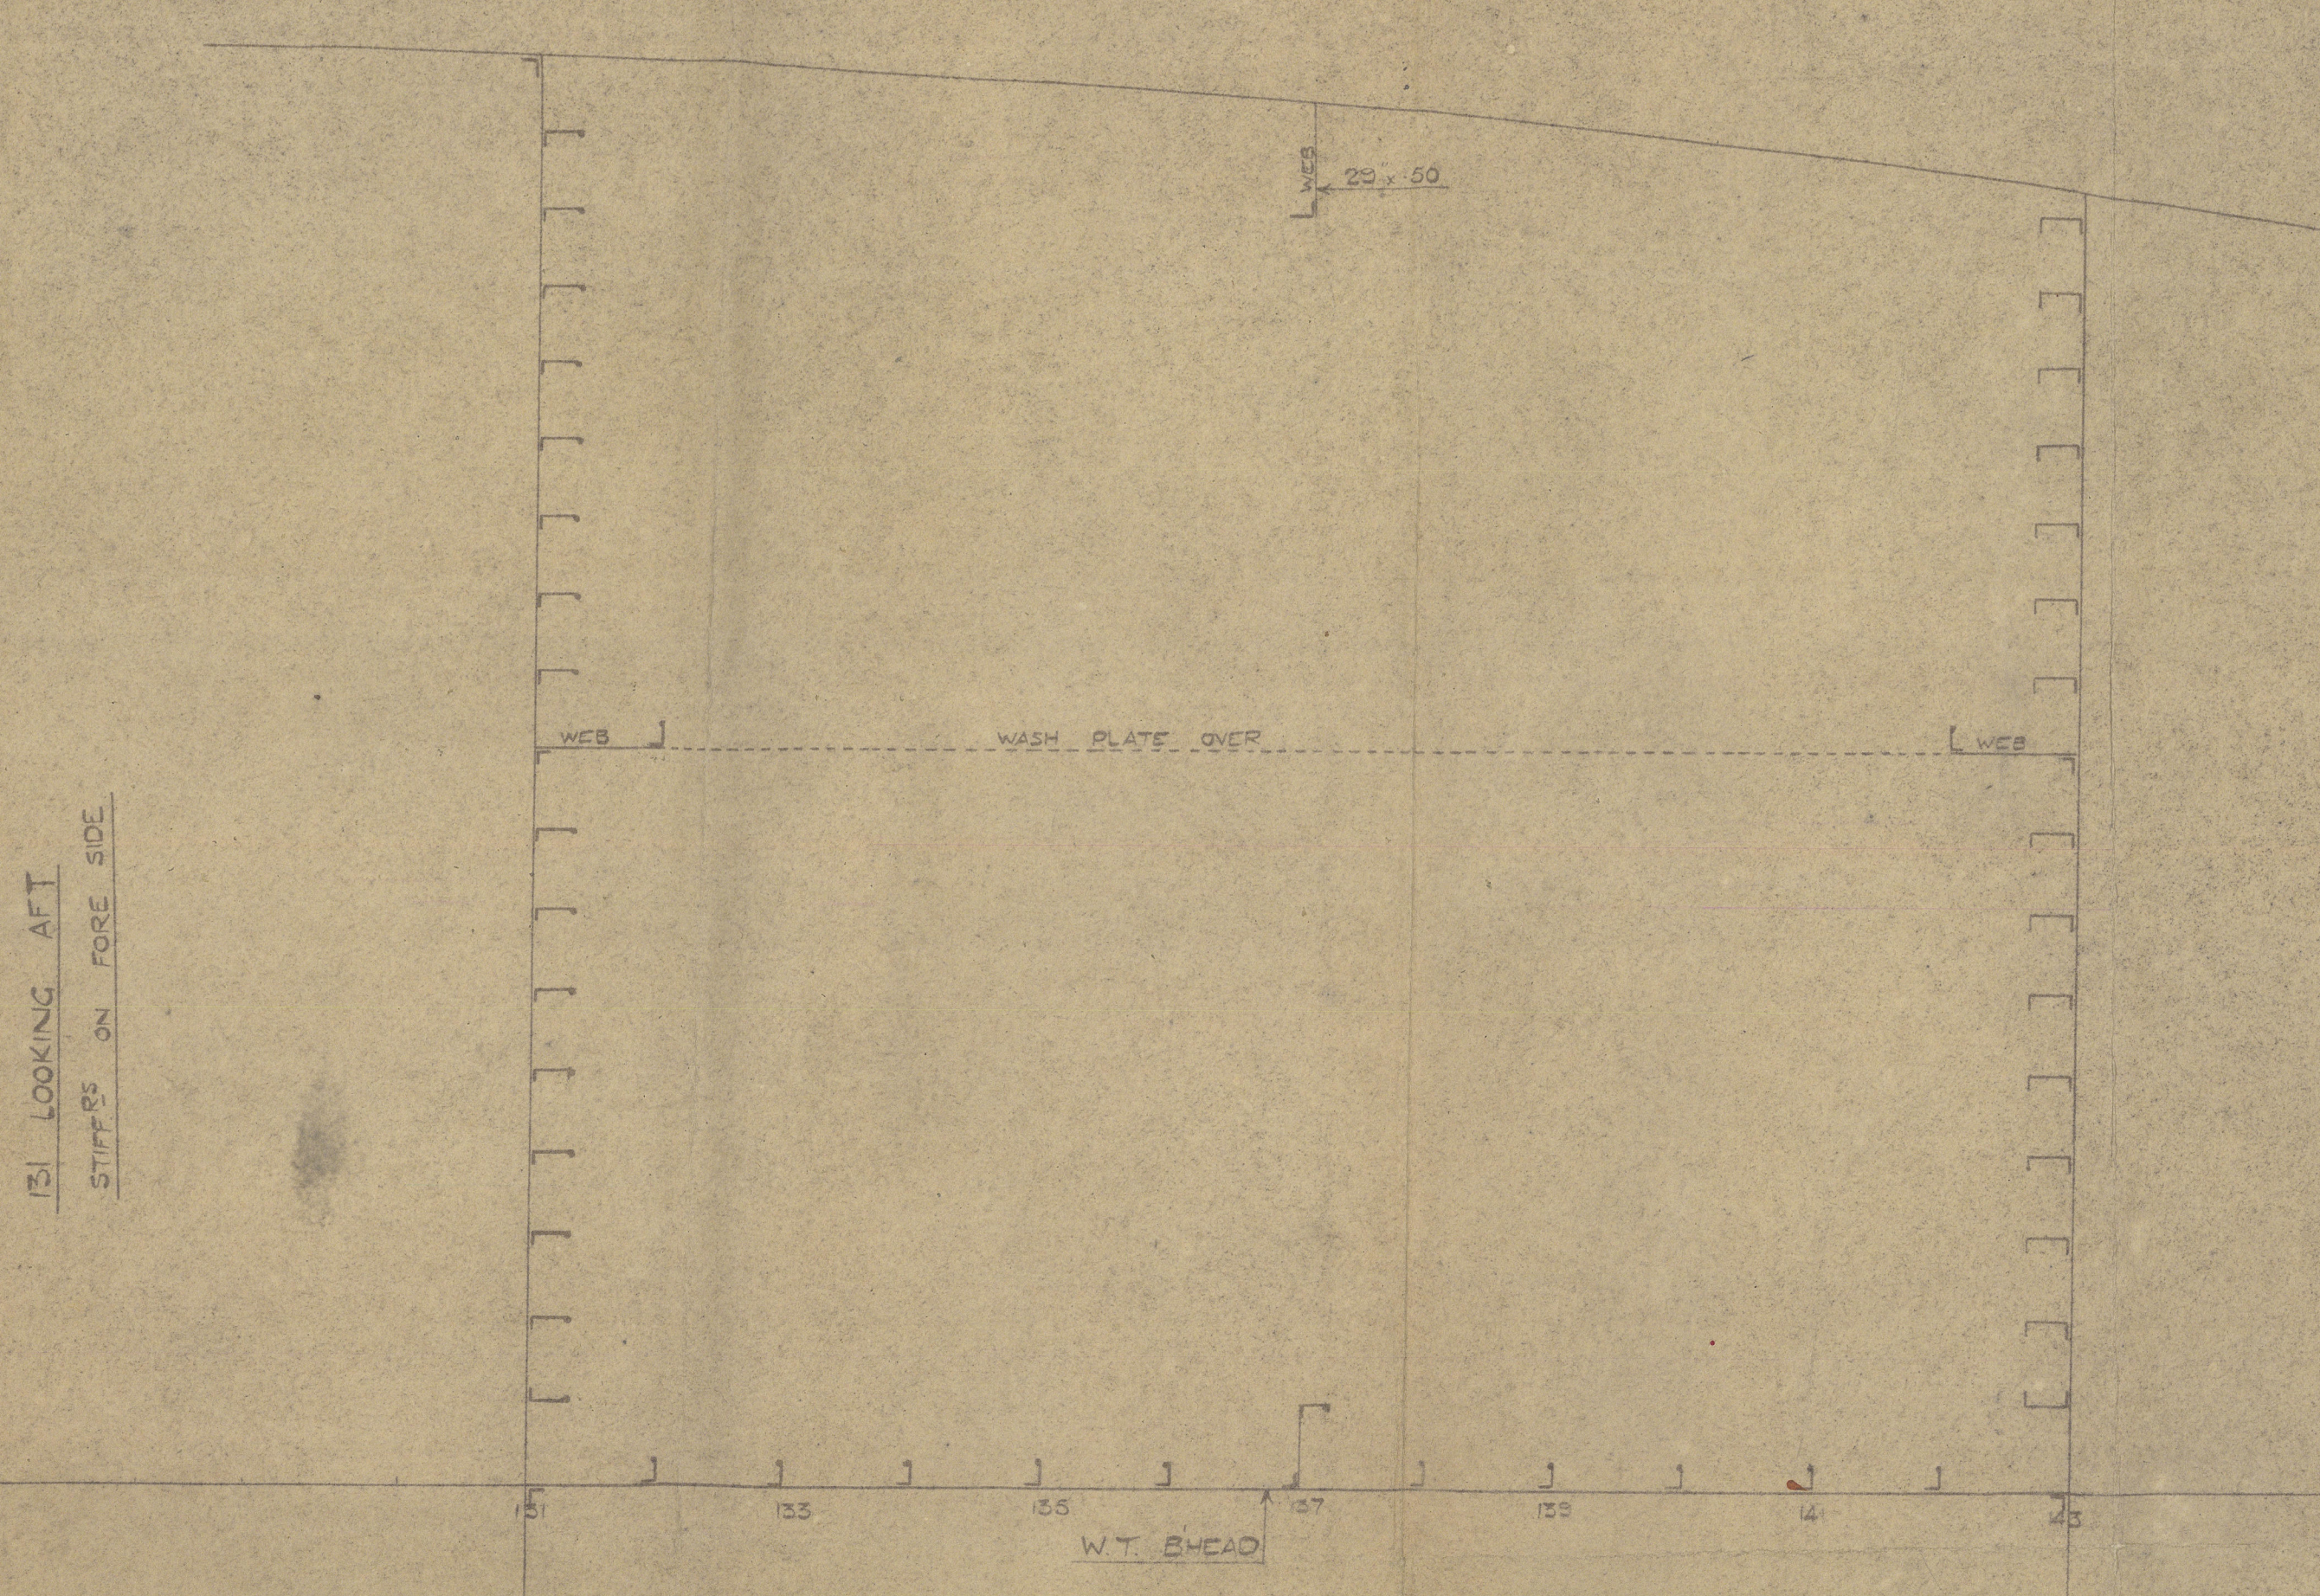
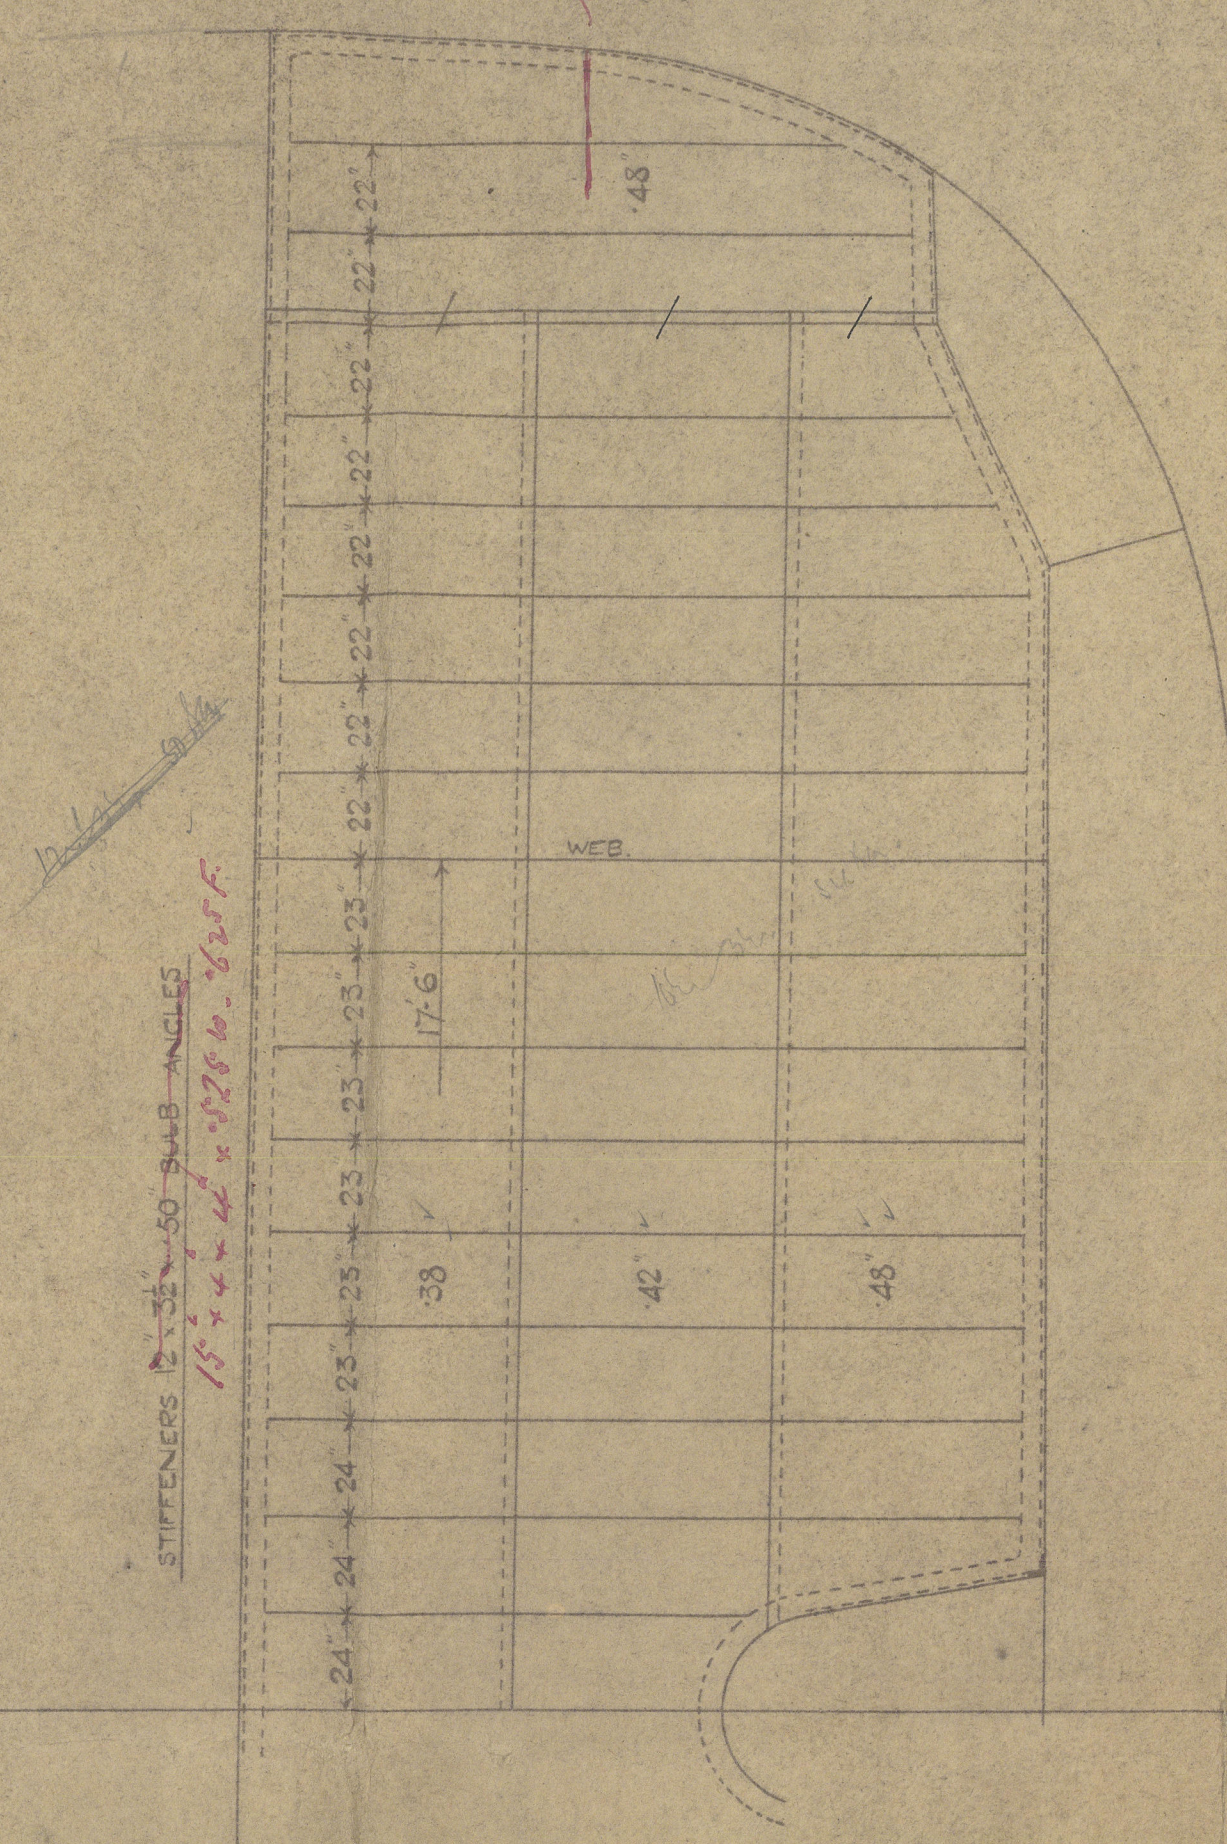
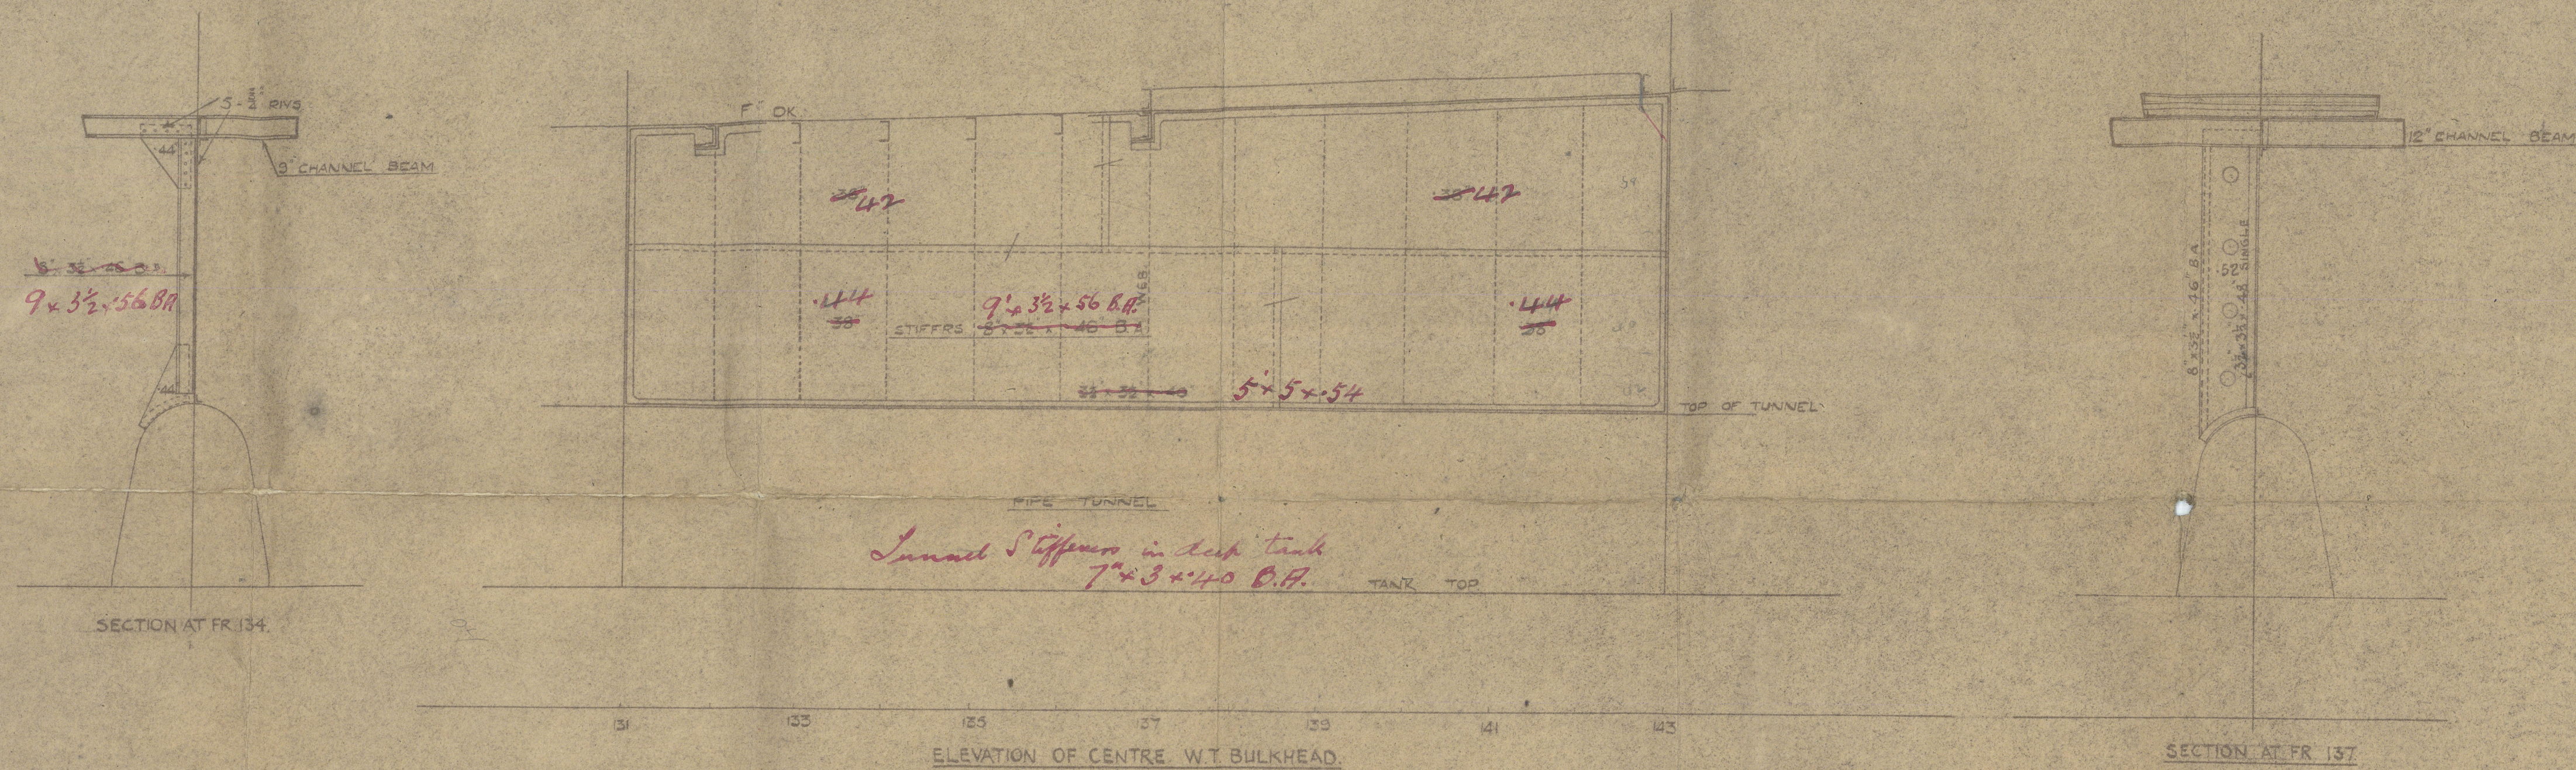
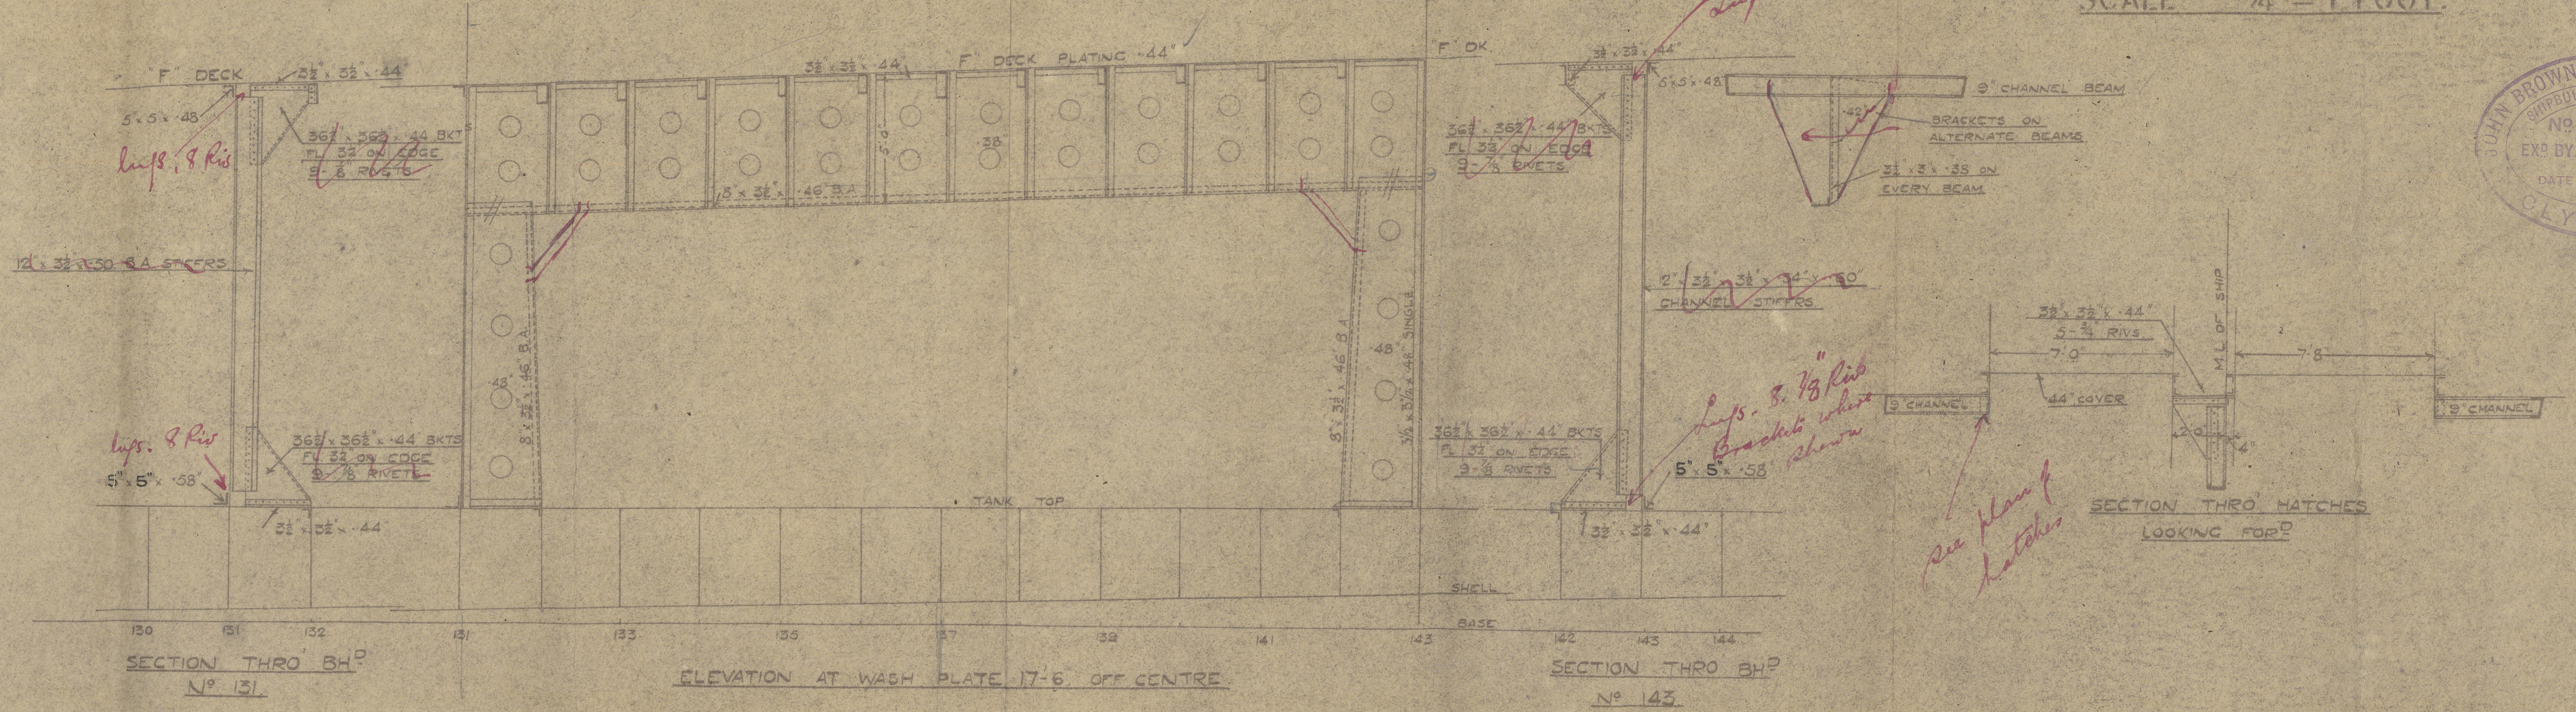


19.3.19

Nº 464-5.

DEEP TANK IN Nº 2 HOLD.

SCALE  $\frac{1}{4}$ " = 1 FOOT.

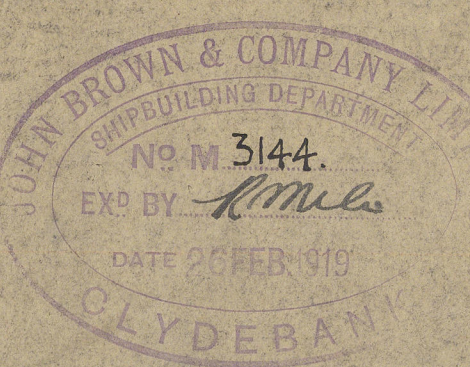




BUILDERS. Messrs. John Brown & Co. Ltd.,

YARD No. 4 6 4 / 5 .

PLAN, of Deep Tank.

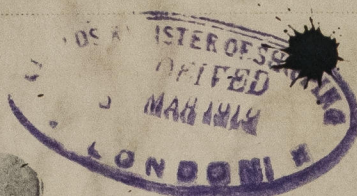

SHIP'S NAME,

*T.S. Montcalm*

GLASGOW REPORT No

41592

*T.S. Montrose*

GLASGOW REPORT No. 41829

*S.S. Montclair*

GLASGOW REPORT No. 42102.



© 2021

Lloyd's Register  
Foundation

009522-009526-0053