



1-6-18

T. S. S. Nos 464-5.

BOAT DECK.

SCALE $\frac{1}{8}'' = 1 \text{ FOOT}$.

STRINGER & DECK PLATING BUTTS ALL D.R.
DECK LANDINGS ALL S.R.

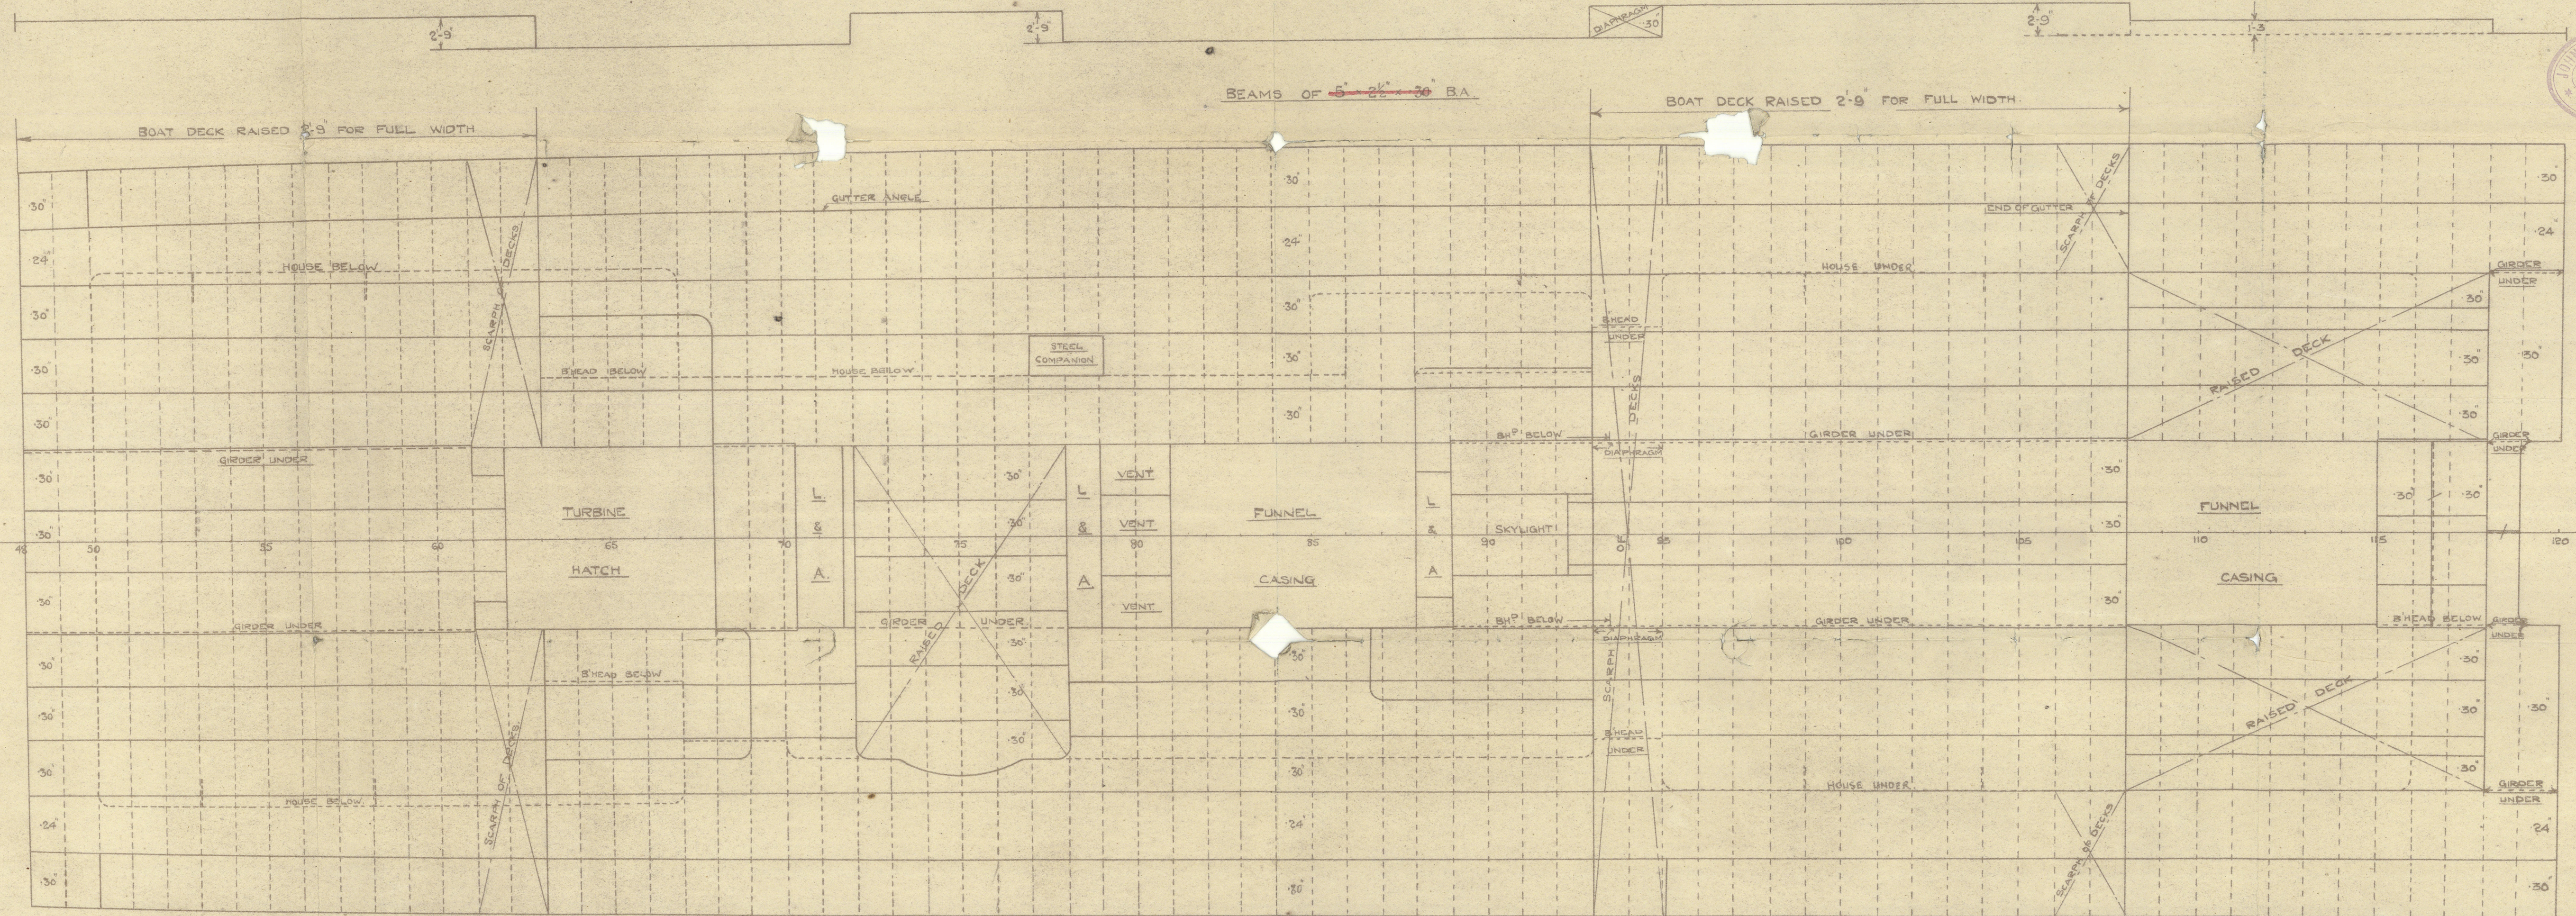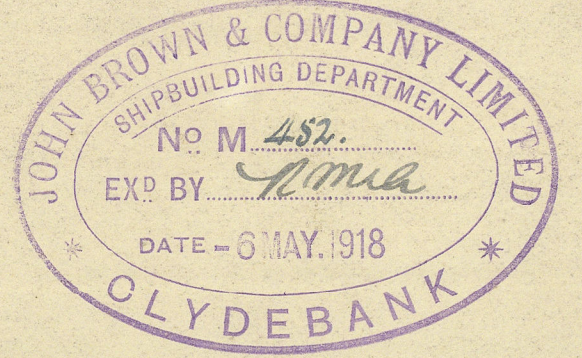

4+
✓
BUILDERS. *Messrs John Brown & Co. Ltd.*

YARD NO. ^{S.} *464-5*

PLAN. *BOAT DECK.*

SHIP'S NAME, *S.S. Montclair*

GLASGOW REPORT No. *41592*

S.S. Montclair

GLASGOW REPORT No. *41829*

S.S. Montclair

GLASGOW REPORT No.

42102



Lloyd's Register
Foundation