

SECTION AT FRAME NO 6  
LOOKING FRD.

10 x 7.5 x 4 = 30


150

3/4 = 10

SM = 60

60 = 6

10

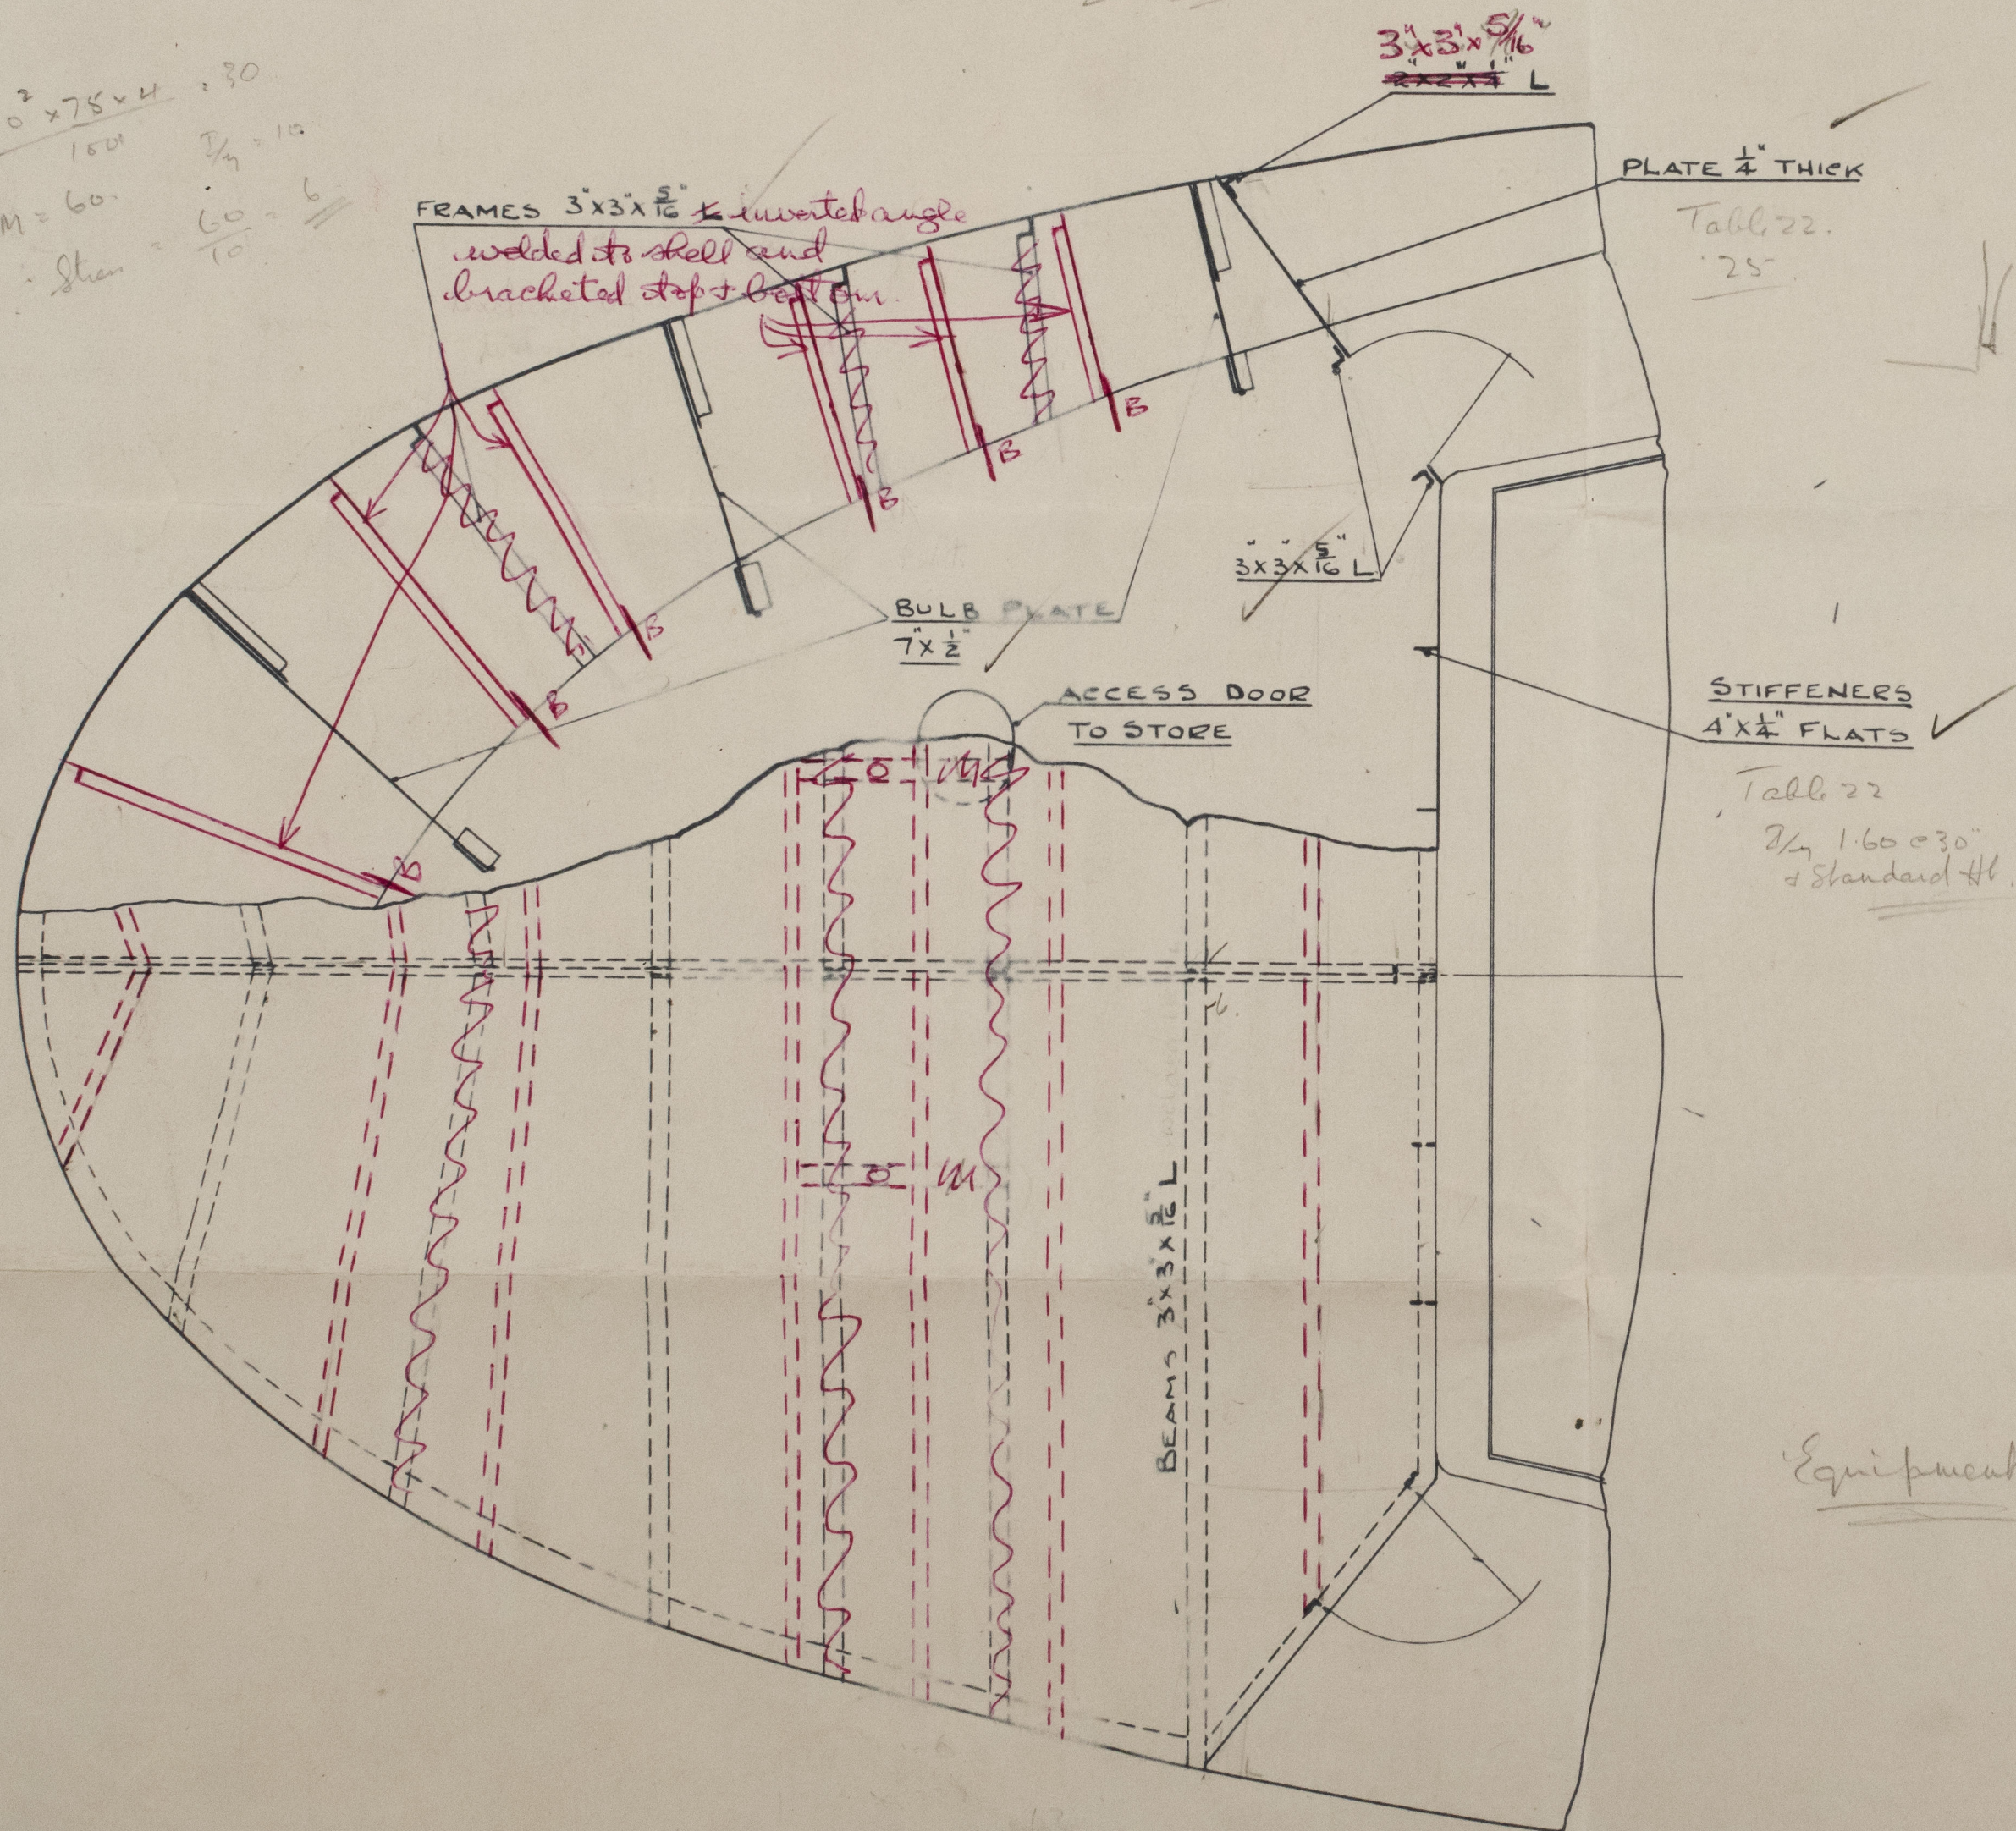

Frames Table 13 C  $2.11 \times \frac{36}{22.5} = 3.37$

Fitted 3" x 3" x  $\frac{5}{16}$ " OAR  $2.4 = 3.5$

Beams Table 24 Span 8'  $1.57 \times \frac{30}{22.5} \times 1.70 = 1.42$

Fitted 3" x 3" x  $\frac{5}{16}$ " OAR  $1.42 = 1.02$

4" x 3" x  $\frac{5}{16}$ " OAR  $1.42 = 1.72$

Equipment OK

Office

AMALGAMATED ENGINEERING CO. LTD. MARSA - MALTA			
CLIENT	M.V. "BRITANNIA"		
DRAWING	POOP HOUSE		
SCALE	DATE	APPROVED	DRG. NO.
$\frac{1}{2}$ " = 1 Foot	15-7-57		



High of water 11  
CLIP M

009522-009526-0228






© 2021

Lloyd's Register  
Foundation