



Reinforced Concrete Jug. 125'0" x 27'6" (on 12'0" W.L.) x 14'9"

15/2/18

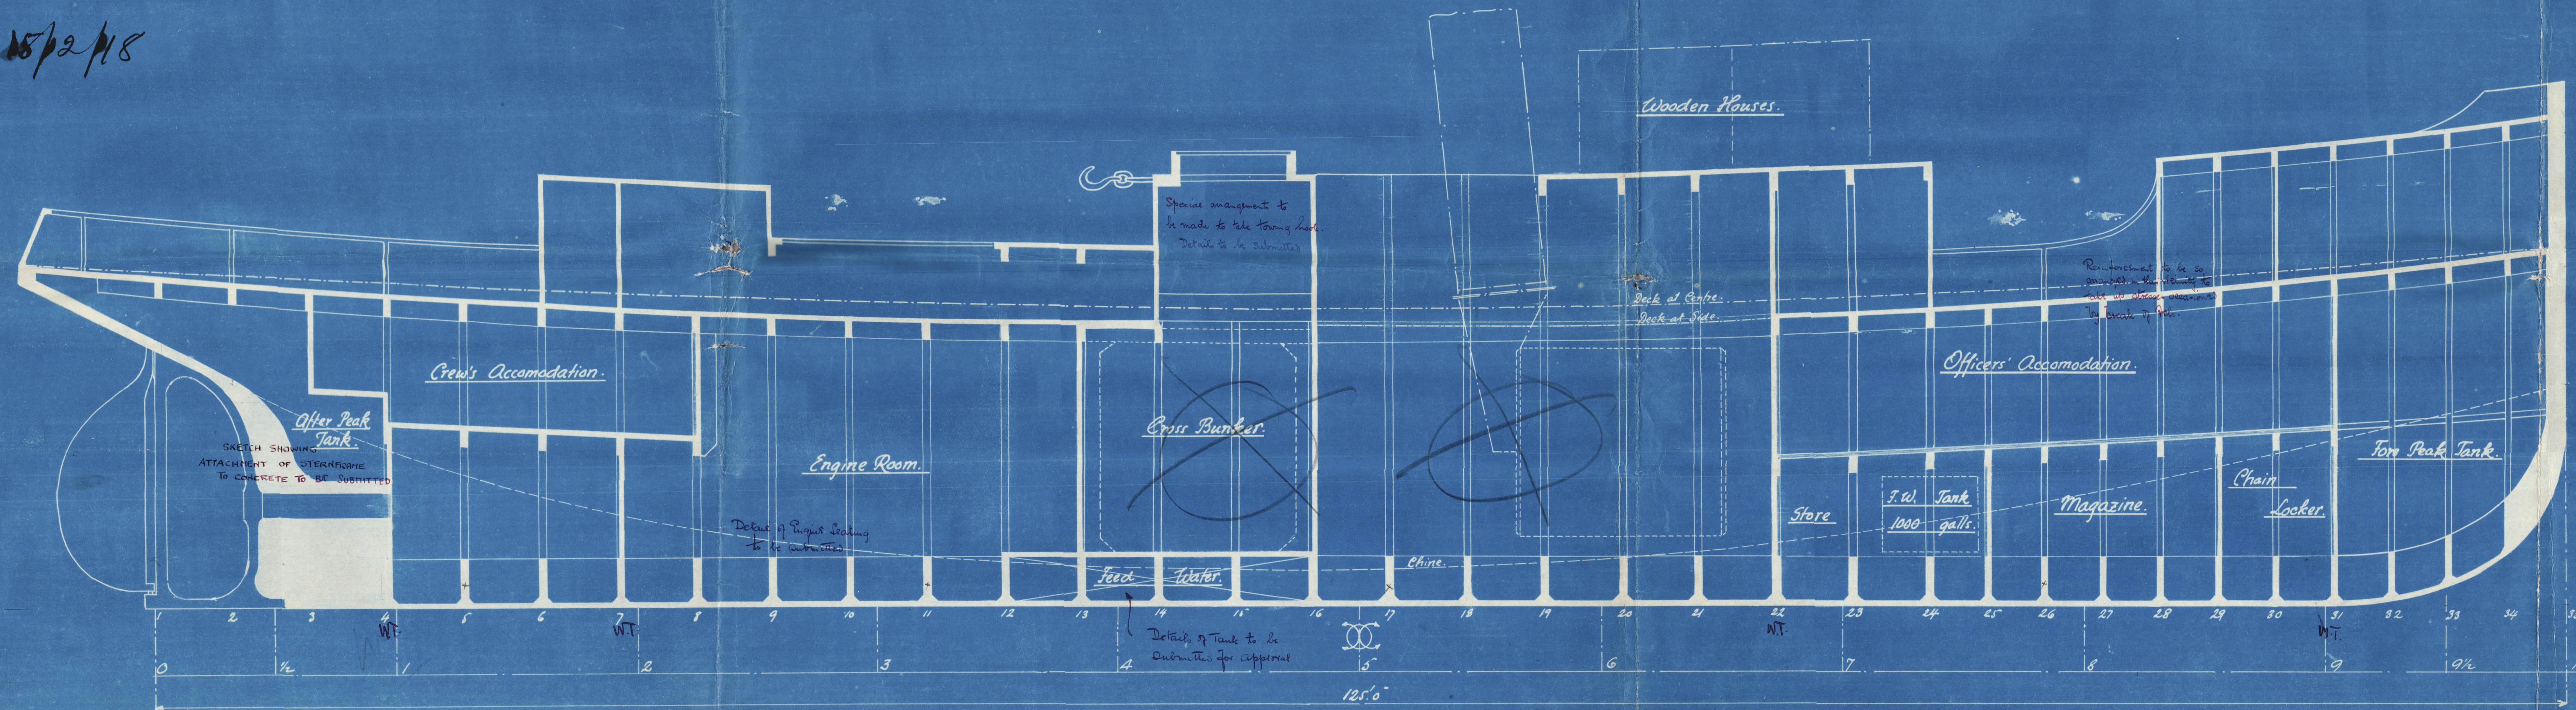


Profile.

See later plan 369

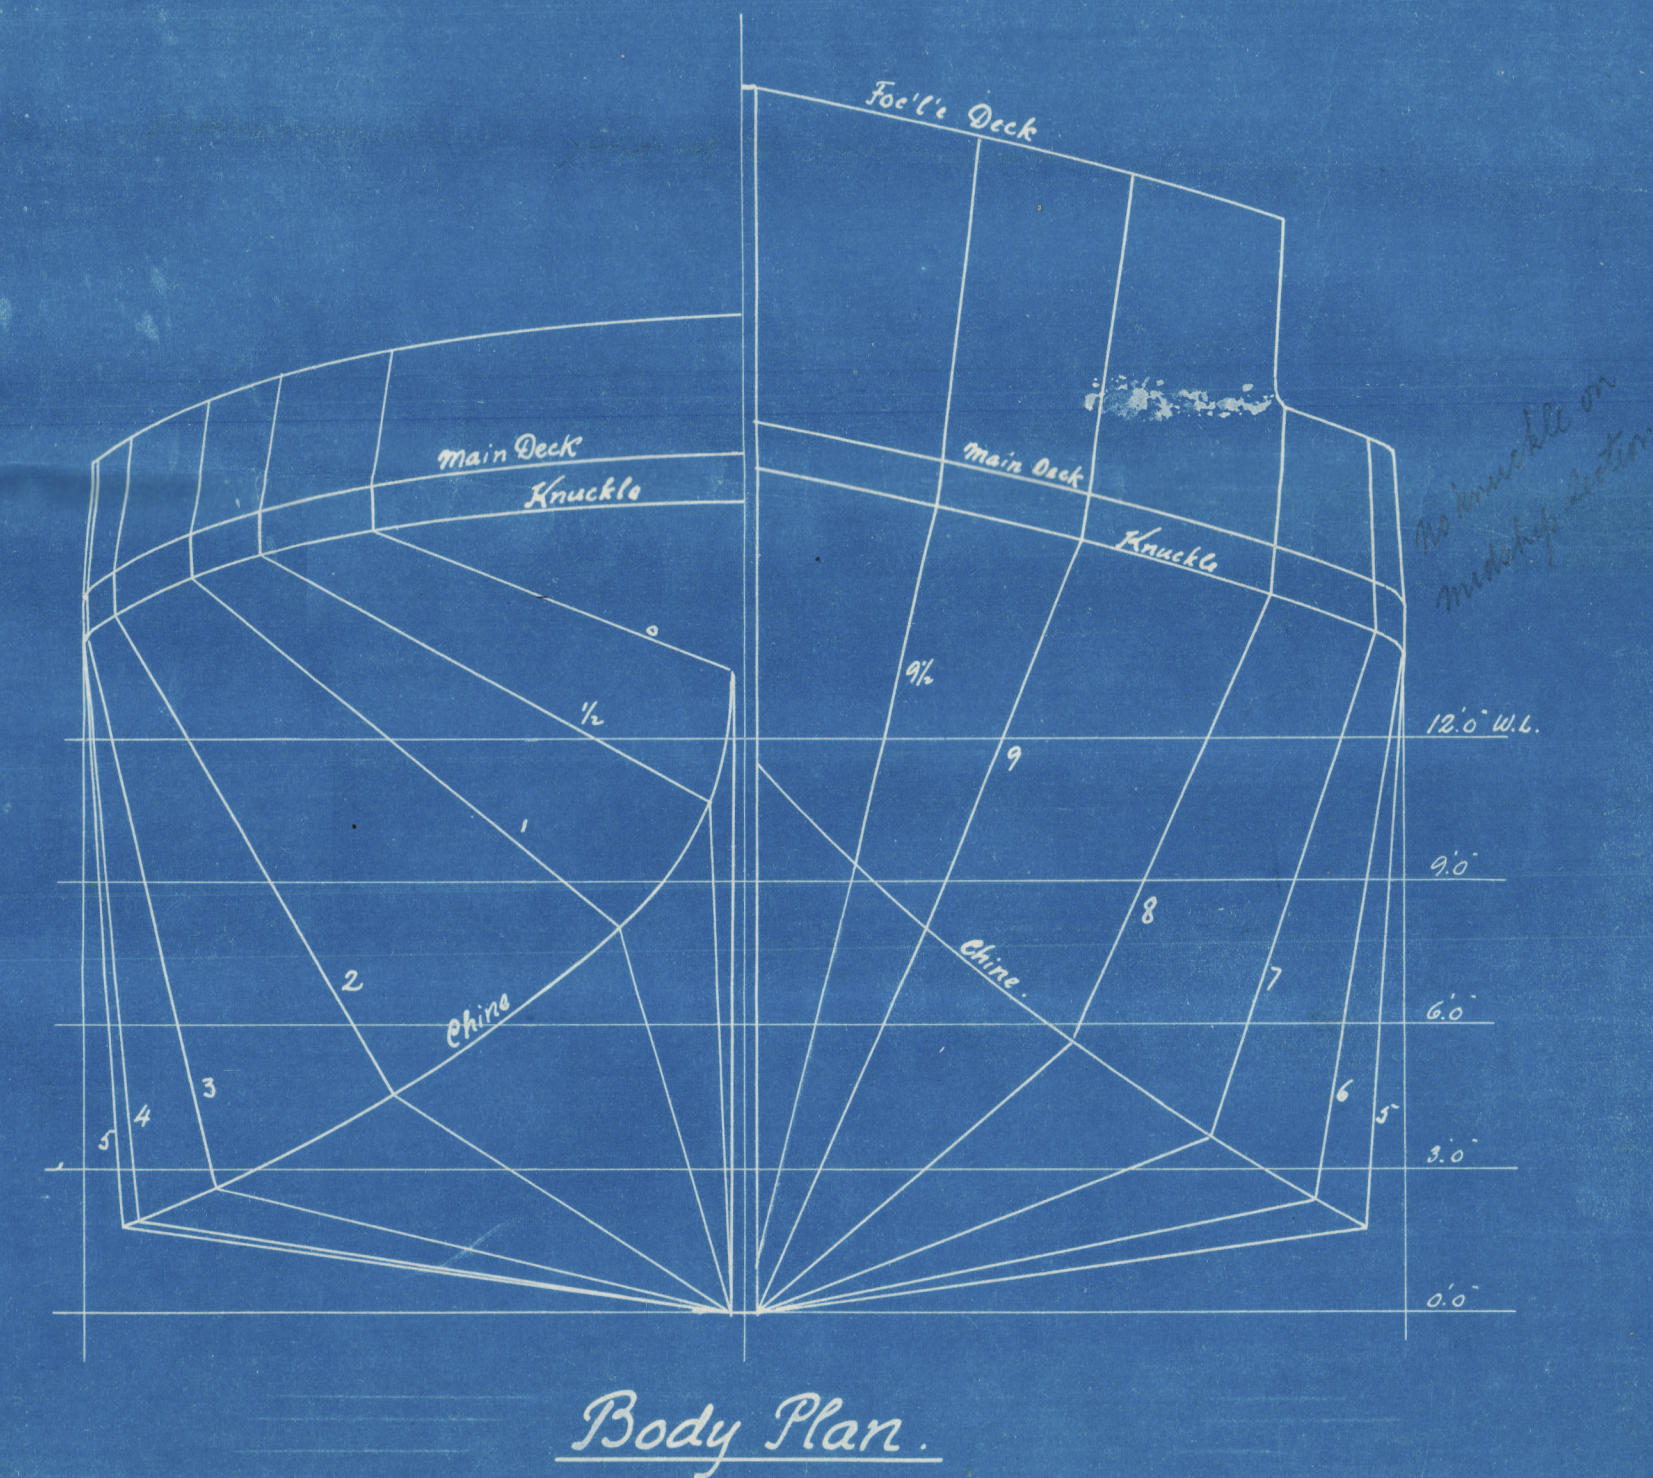

Body Plan.

Scale: 1/4" = 1'0"

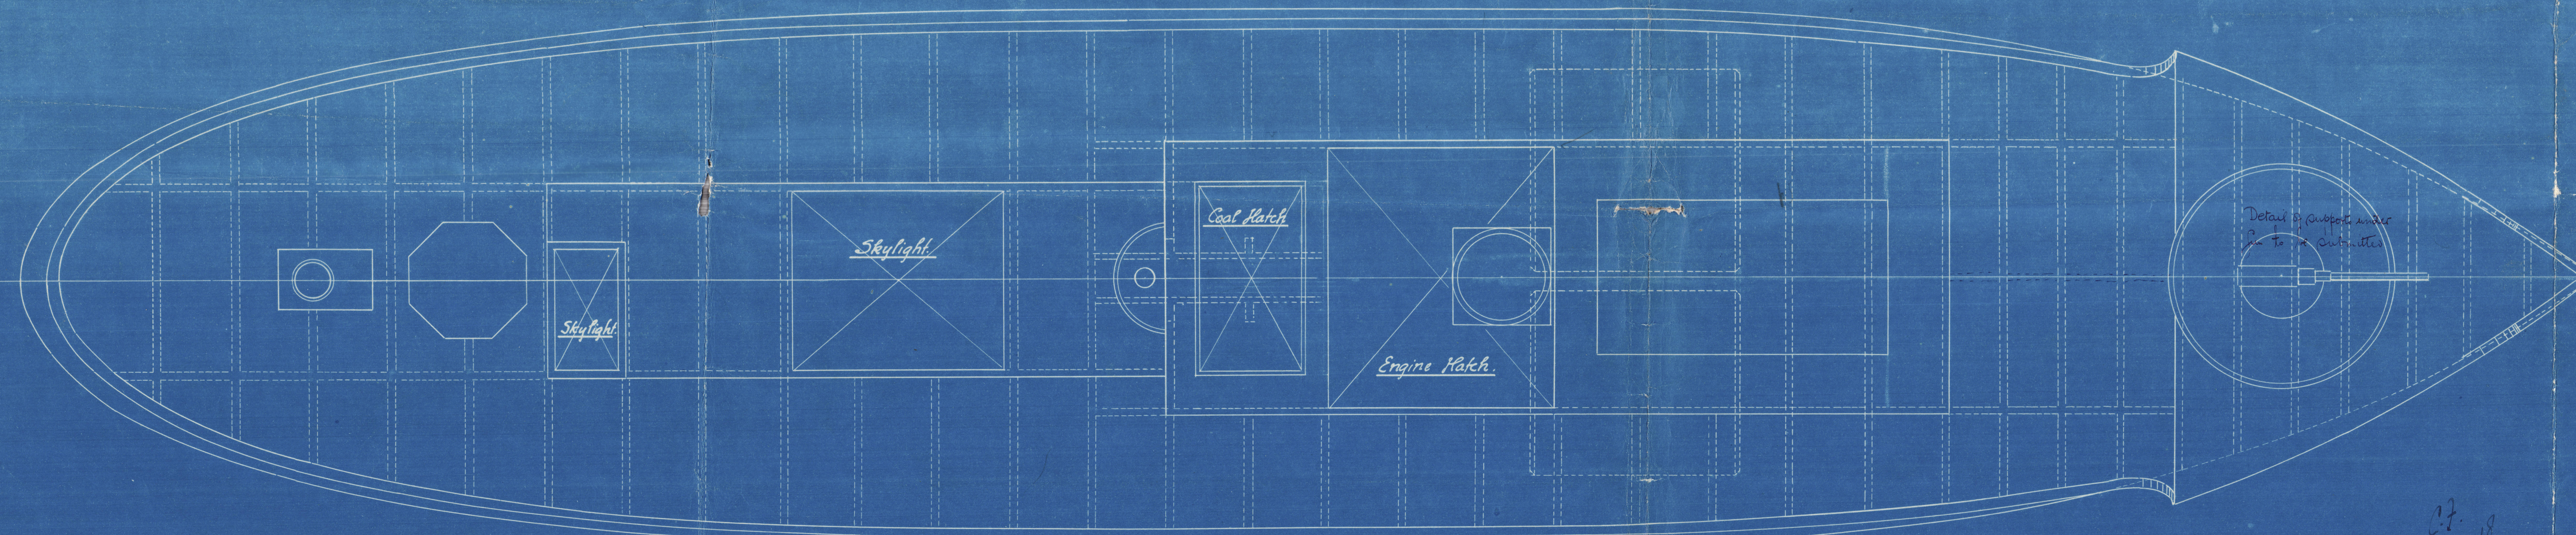


Deck Plan.

15.2.18

004527-004534-0135



SUNDERLAND

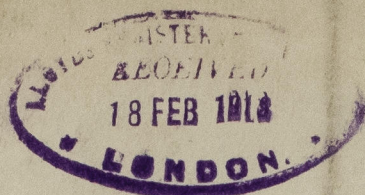

CONCRETE  
ADMIRALTY TUGS


PROFILE

Nº 1 CRETEHAWSER lld 27507.

Nº 2 Creterope. lld 27585.

Nº 3 Cretecable. lld 27654


SUNDERLAND RPT. NO. 27507.

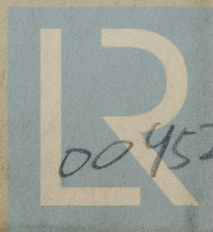

© 2021

004527-004534-0135  
Lloyd's Register  
Foundation



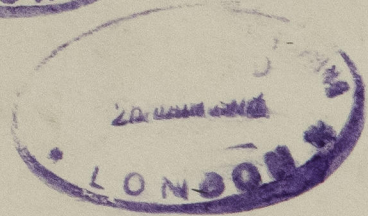

009527-009534-0135

