


Reinforced Concrete Tugs. 1-18

Lloyds
London
Stamp.

28/5/18.

Amended Arrangements of Slab Reinforcement.

Scale: $\frac{1}{2}$ " to 1 foot.

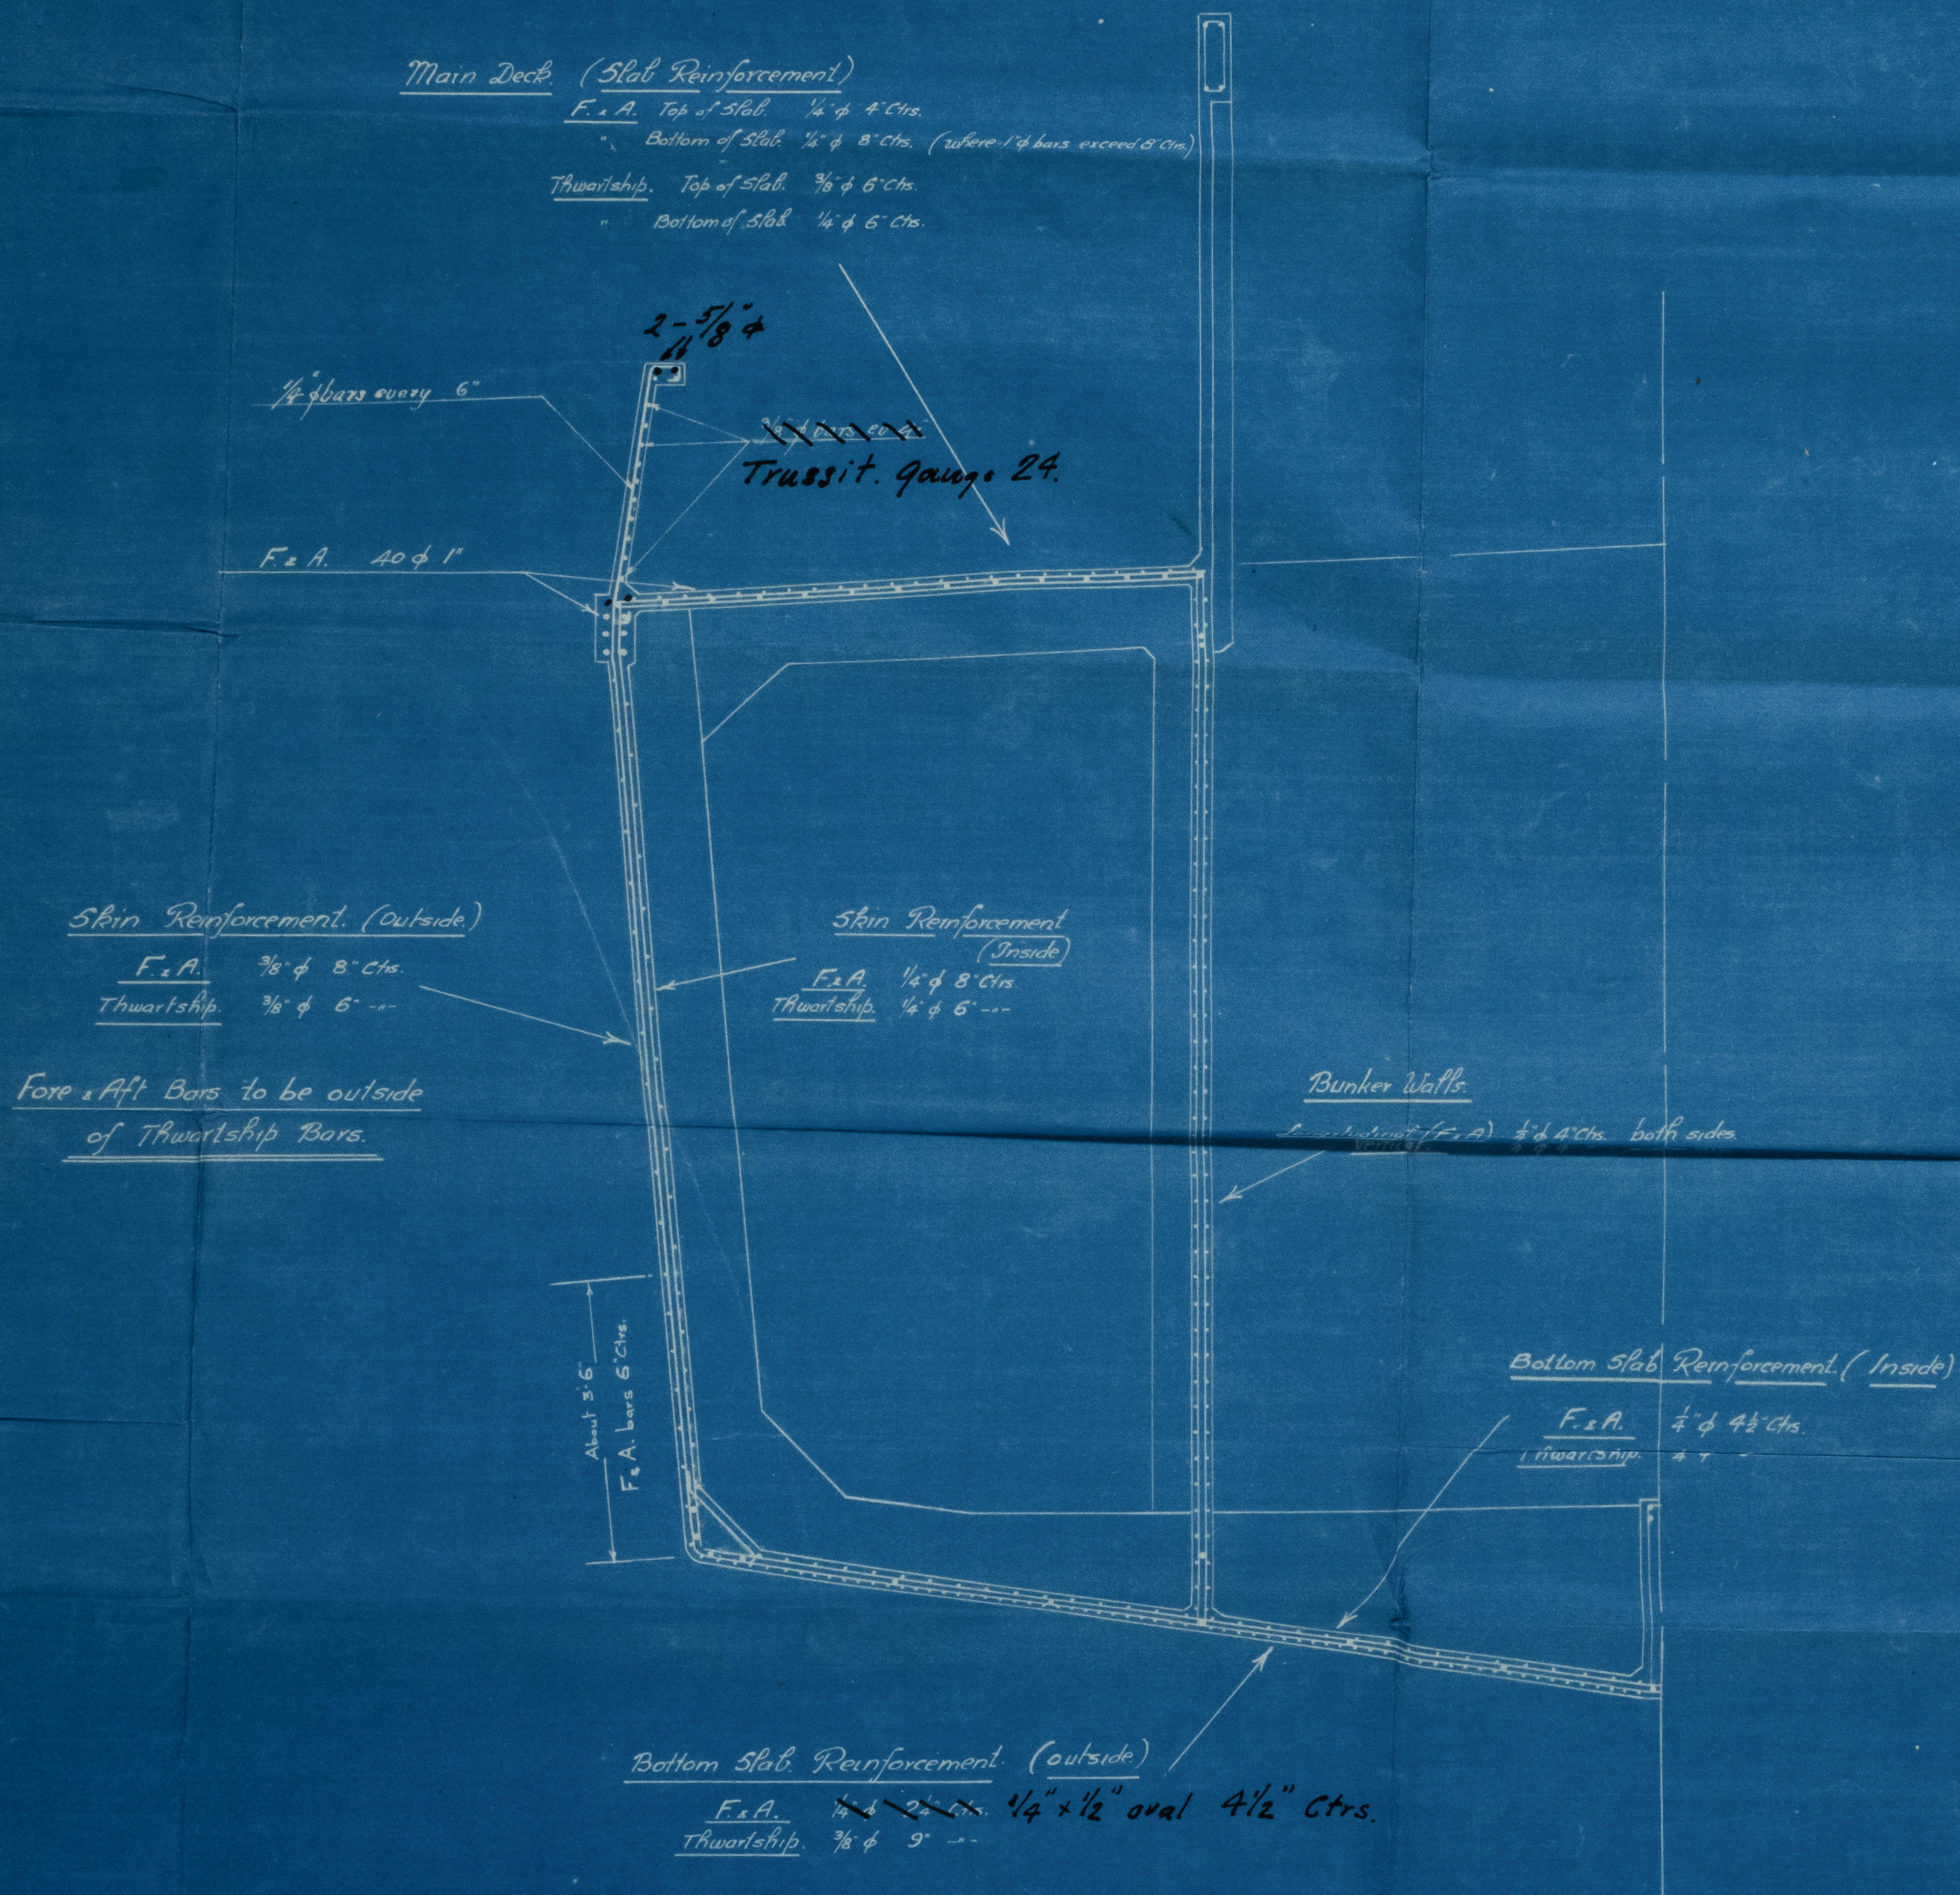

Half Section of Midship

(sign.) C7
 27/5/18

1-6. 24/5/18.
 186. London.
 WAB. 27C

Lloyds Stamp entered 27/5/18.
 Reference to Admiralty letter 23/4/18
 amended 24/5/18 H.M.S.

004527-004534-0139

Sunderland

Wean Concrete Blgls

Amended Arrog
of Slab Reinforcement

N^o 1 Cretekawser

Sld. 27507.


N^o 2 Creterope. Sld

27585.

N^o 3 Creterable

Sld 27654.

SUNDERLAND

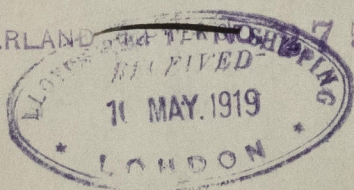

7507

009527-009534-0139

© 2021

Lloyd's Register
Foundation

2



© 2021

Lloyd's Register
Foundation