


FERRY STEAMER  
"KARAKARA"  
(AS BUILT)

## GENERAL ARRANGEMENT


### DOUBLE ENDED FERRY STEAMERS

DIMENSIONS LENGTH 187'-0" B.B. BREADTH 35'-6" MLD. DEPTH 14'-0" MLD.


SCALE  $\frac{1}{4}$  INCH = 1 FOOT YARD N<sup>o</sup> 413-14 PLAN N<sup>o</sup>  $\frac{5}{413-14}$

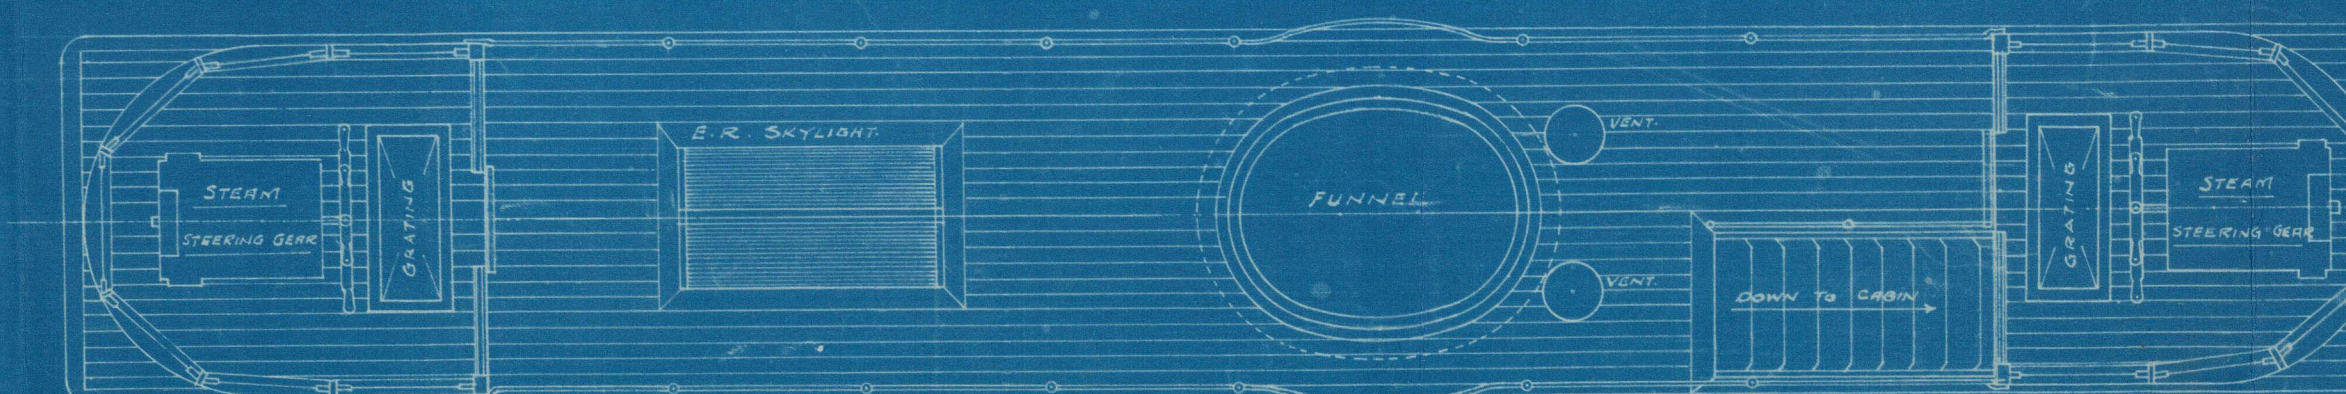

BRIDGE DECK

 

ELEVATION

 

MAIN DECK



GENERAL ARRANGEMENT  
(AS BUILT.)

FERRY STEAMER. "KARAKARA"

J. Cuckler & Son Ltd 1914.

S. S. \_\_\_\_\_

LIVERPOOL.

Report No. 90478

009535-009543-0188



© 2021

Lloyd's Register  
Foundation