

Mitchell's

C.B.
28.9.11.


Cochran & Sons

No 515-516.

Midship Section

$\frac{3}{4}$ Balder Hull Rpt No: 24709

"Brage" " " " 24710

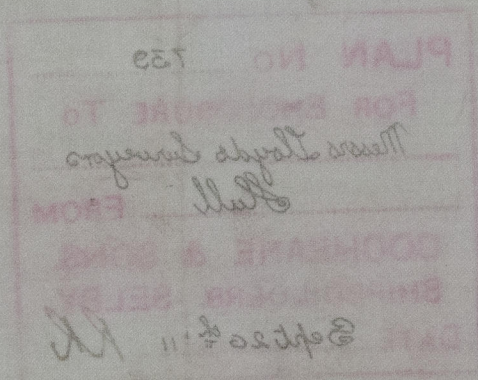

Run Ball 102-3-30 2nd


Spool 3 1/2 Hallow

Bulwarks 8 1/2 x 20 in

WAY OF GALLIES

6-8-20 Ball Pl

STUNGER

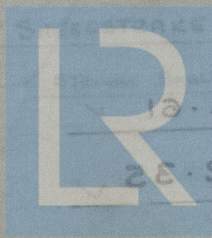

© 2020

Lloyd's Register
Foundation

009544-009556-0052


Rev. 1

52.6.11
J.P.

LOADING DOUBT RIVETED. BULKHEADS SHEET RIVETED.
WHICH ARE TO BE STRAPPED.
RIVETED EXCEPT CARRIAGE & SHEETSTEAK
BOLTS OF SHEET PLATE LAPPED & DOUBT

RIVETING

100	2	MASS
100	0	HAWSES
150	1	CABLE
250	2	EX STOCK
500	5	STAINLESS

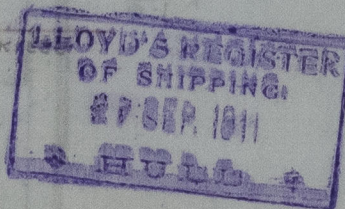

© 2020
Lloyd's Register
Foundation