


4.11.07
(132) 23.2.10

S. S. No 114.
LONGITUDINAL SECTION.

SCALE $\frac{1}{8}$ IN = 1 FT.
DIMS: 165-0 BP x 26-0 x 13-5 MLD M^{LD} M^{LD} D^{LD}.

29/10/07
A.M.

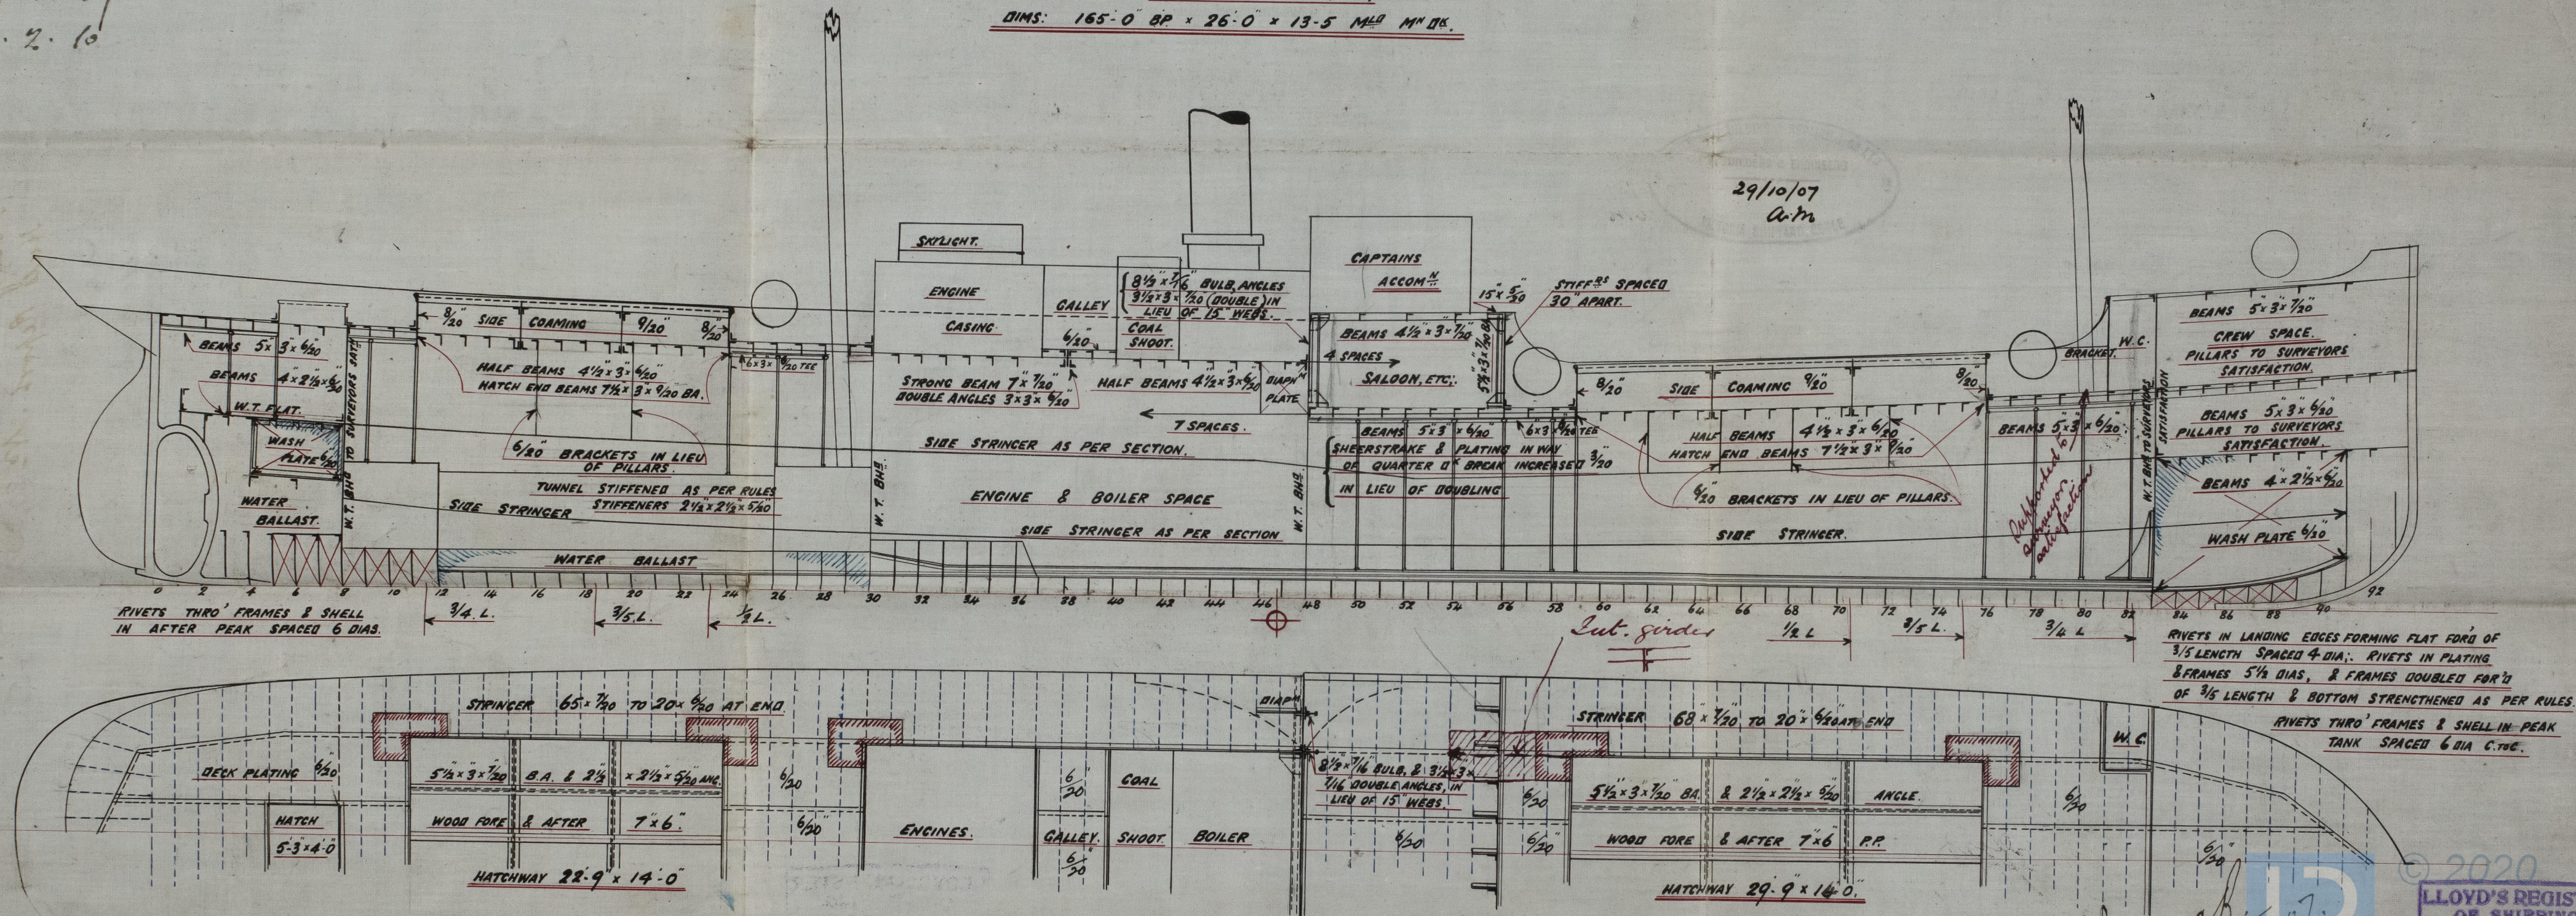

Cook S. & R. Co. Ltd

No 1147/32

Profile & Deck Plan

s/s Tay I

Hull Report No 20,330.

s/s Trent

Hull Rpt No 23281



© 2020

Lloyd's Register
Foundation

004557-004564-0022