

5.4.09

# MIDSHIP SECTION

STEEL SCREW TRAWLER

N<sup>o</sup>. 454

DIM<sup>s</sup>. 117'-0" B.P. x 21'-6" EX x 12'-3" MLD.


SCALE 1/2" = 1 FOOT

TO CLASS 100 A.1. STEAM TRAWLER.

DECK PLATED OVER IN WAY OF MACHINERY.

MACHINERY CASING AS PREVIOUSLY APPROVED.

PLAN NO. 8648  
Lloyds Surveyors  
Hull.  
2/4/09. RR

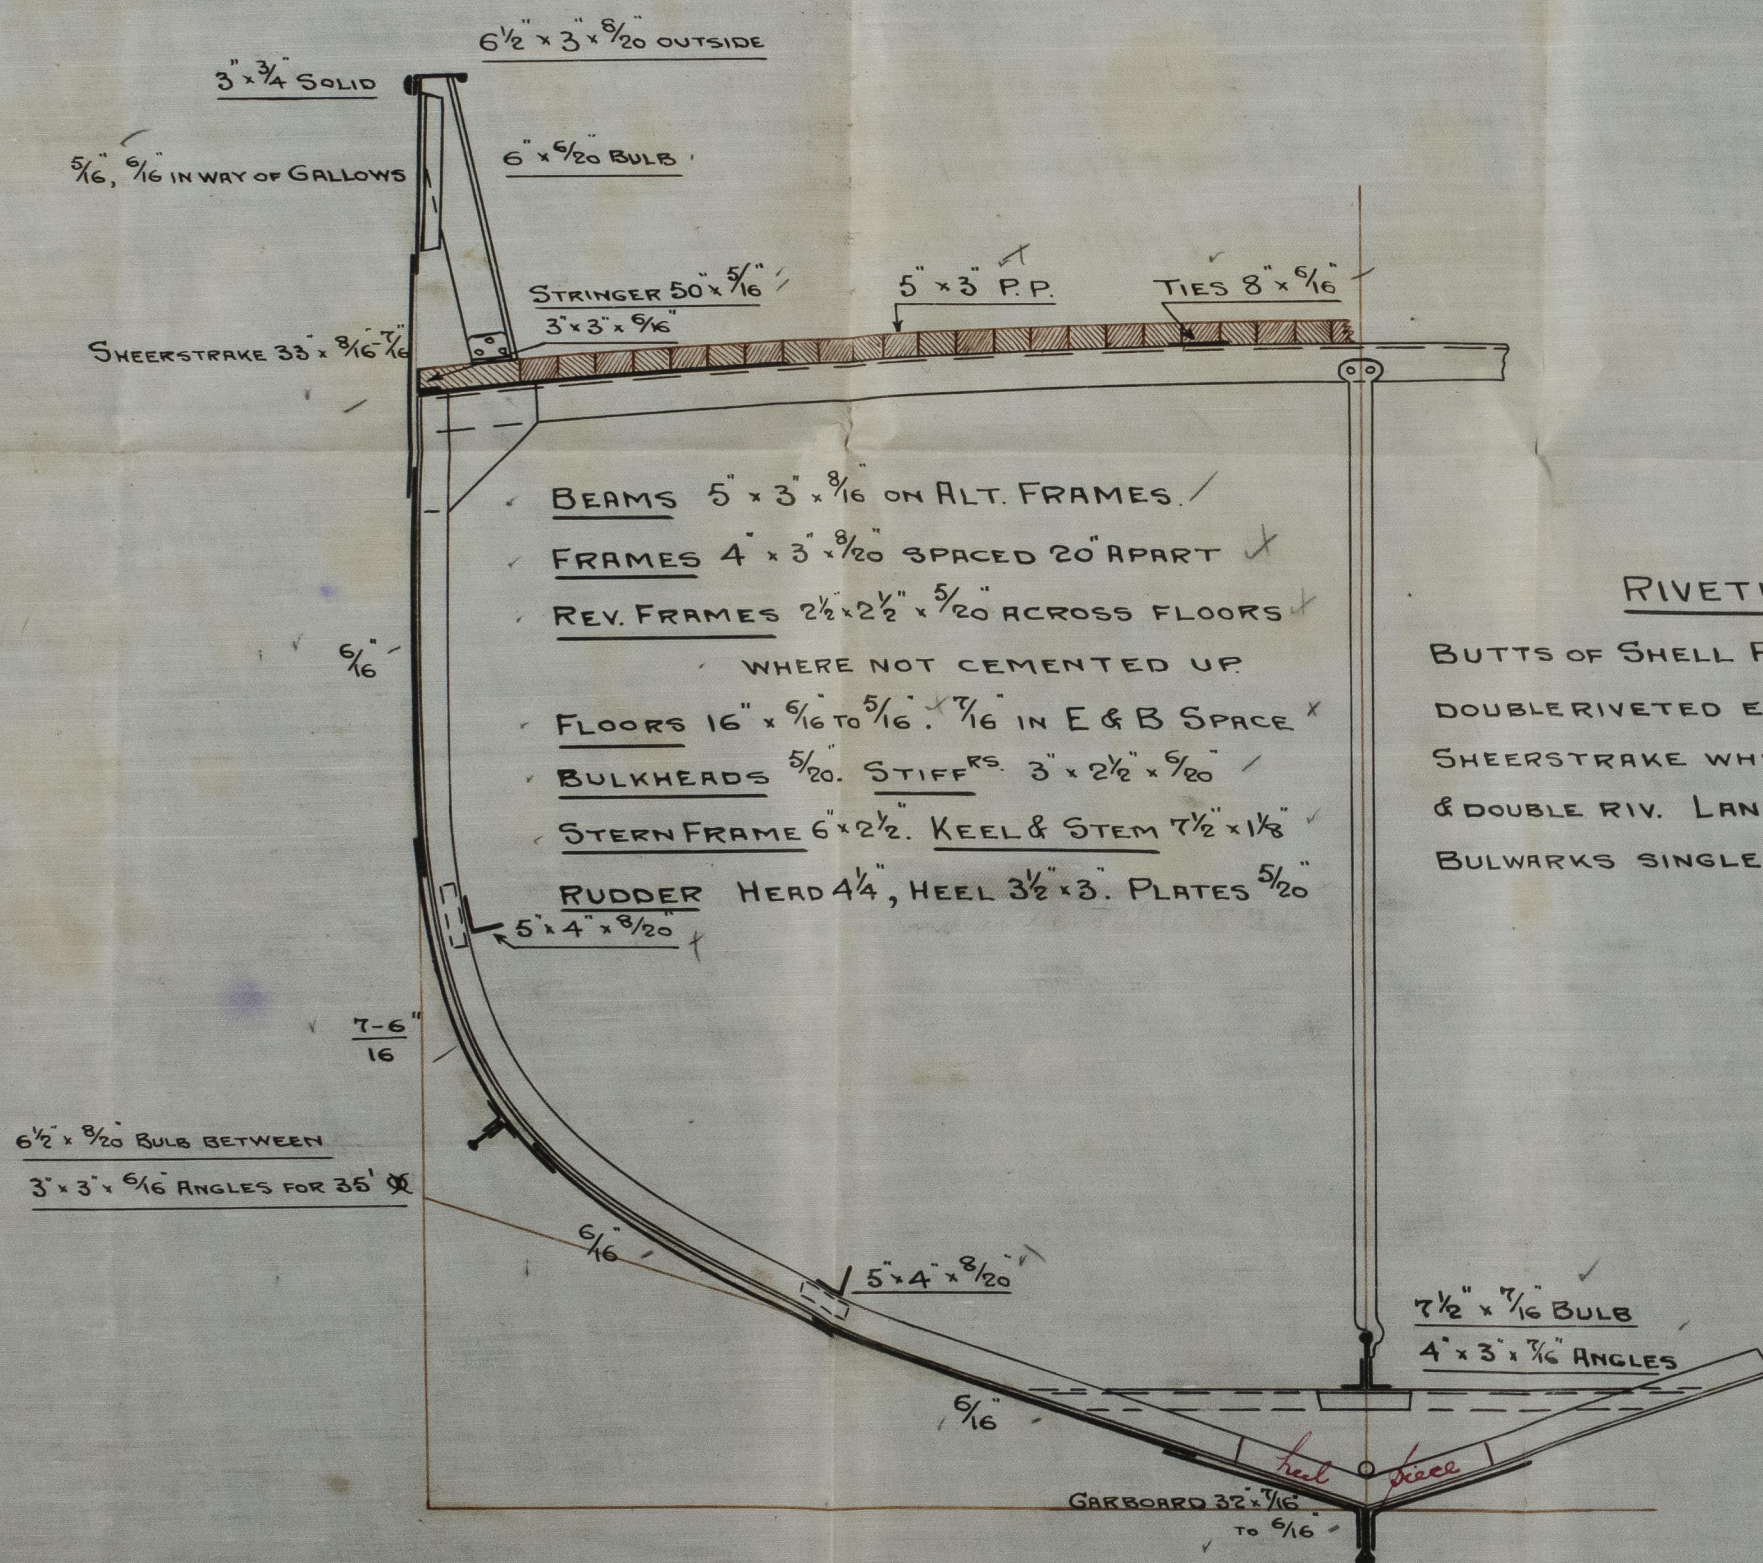

## RIVETING

BUTTS OF SHELL PLATING LAPPED & DOUBLERIVETED EXCEPT GARBOARD & SHEERSTAKE WHICH ARE TO BE STRAPPED & DOUBLE RIV. LANDINGS DOUBLE RIV. BULWARKS SINGLE RIV.

## NUMERALS

1/2 BREADTH	10.7
1/2 GIRTH	18.84
DEPTH	12.71
	42.25 1 <sup>ST</sup> NO.
	115.84
	4864.19 2 <sup>ND</sup> NO.


## PROPORTIONS

L/B	= 5.4
L/D	= 9.1

## EQUIPMENT

1 <sup>ST</sup> BOWER ANCHOR	5 CWTs EX STOCK
2 <sup>ND</sup> " "	4 1/2 " " "
3 <sup>RD</sup> " "	2 1/2 " " "
90 FATHOMS	1" SHORT LINK CABLE
60 " "	5 1/2" HAWSER
60 " "	4" WARP

C.B.  
5.4.09.

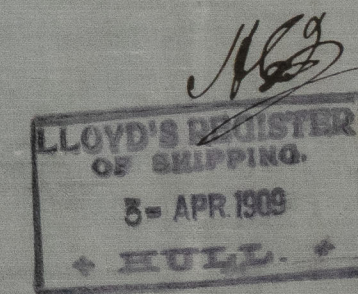

00 4557-0095690 110



© 2020  
Lloyd's Register  
Foundation



No 454

3/5 Washington  
Hull Rpt. no.

90.11.2

© 2020

Lloyd's Register  
Foundation

009557-009569-0110