

PROFILE & DECK PLAN


N^o 454

SCALE $\frac{1}{4}$ " = 1 FOOT.

PLAN N^o 2649
FOR ENCLOSURE TO
Messrs Lloyd's
Surveyors
FROM
COCHRANE & SONS,
SHIPBUILDERS, SEASIDE,
DATE 2/4/09. RR

5.4.09.


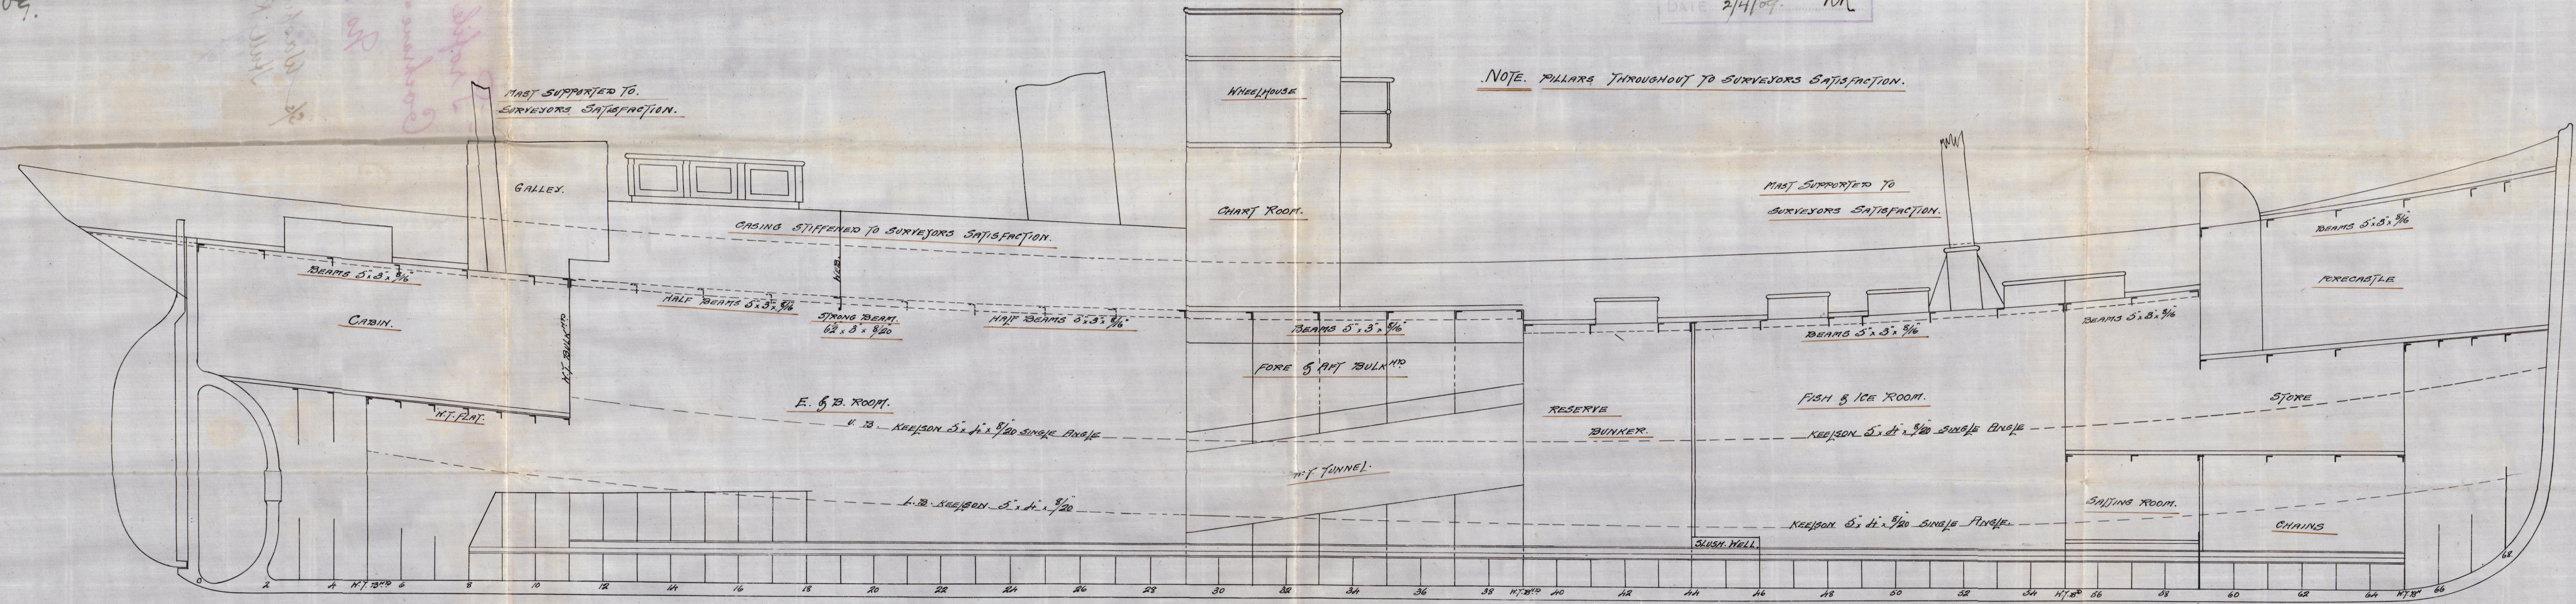

- Profile & Deck Plan

Cochrane & Sons


No 454

an

S/S Washington

Hull Rpt. No. 21573

20.1.2

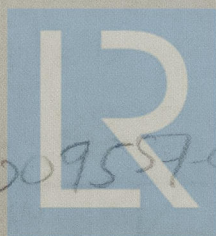

© 2020

009557-004561
Lloyd's Register
Foundation