

# SINGLE SCREW STEAMER — No 101. —


DIMENSIONS 225' x 35' x 22'-6"

STEEL PROFILE & DECK PLANS [AS BUILT]

SCALE 1" = 1 FOOT.

FULL SCANTLING VESSEL

70 CLASS LLOYDS 100 A1

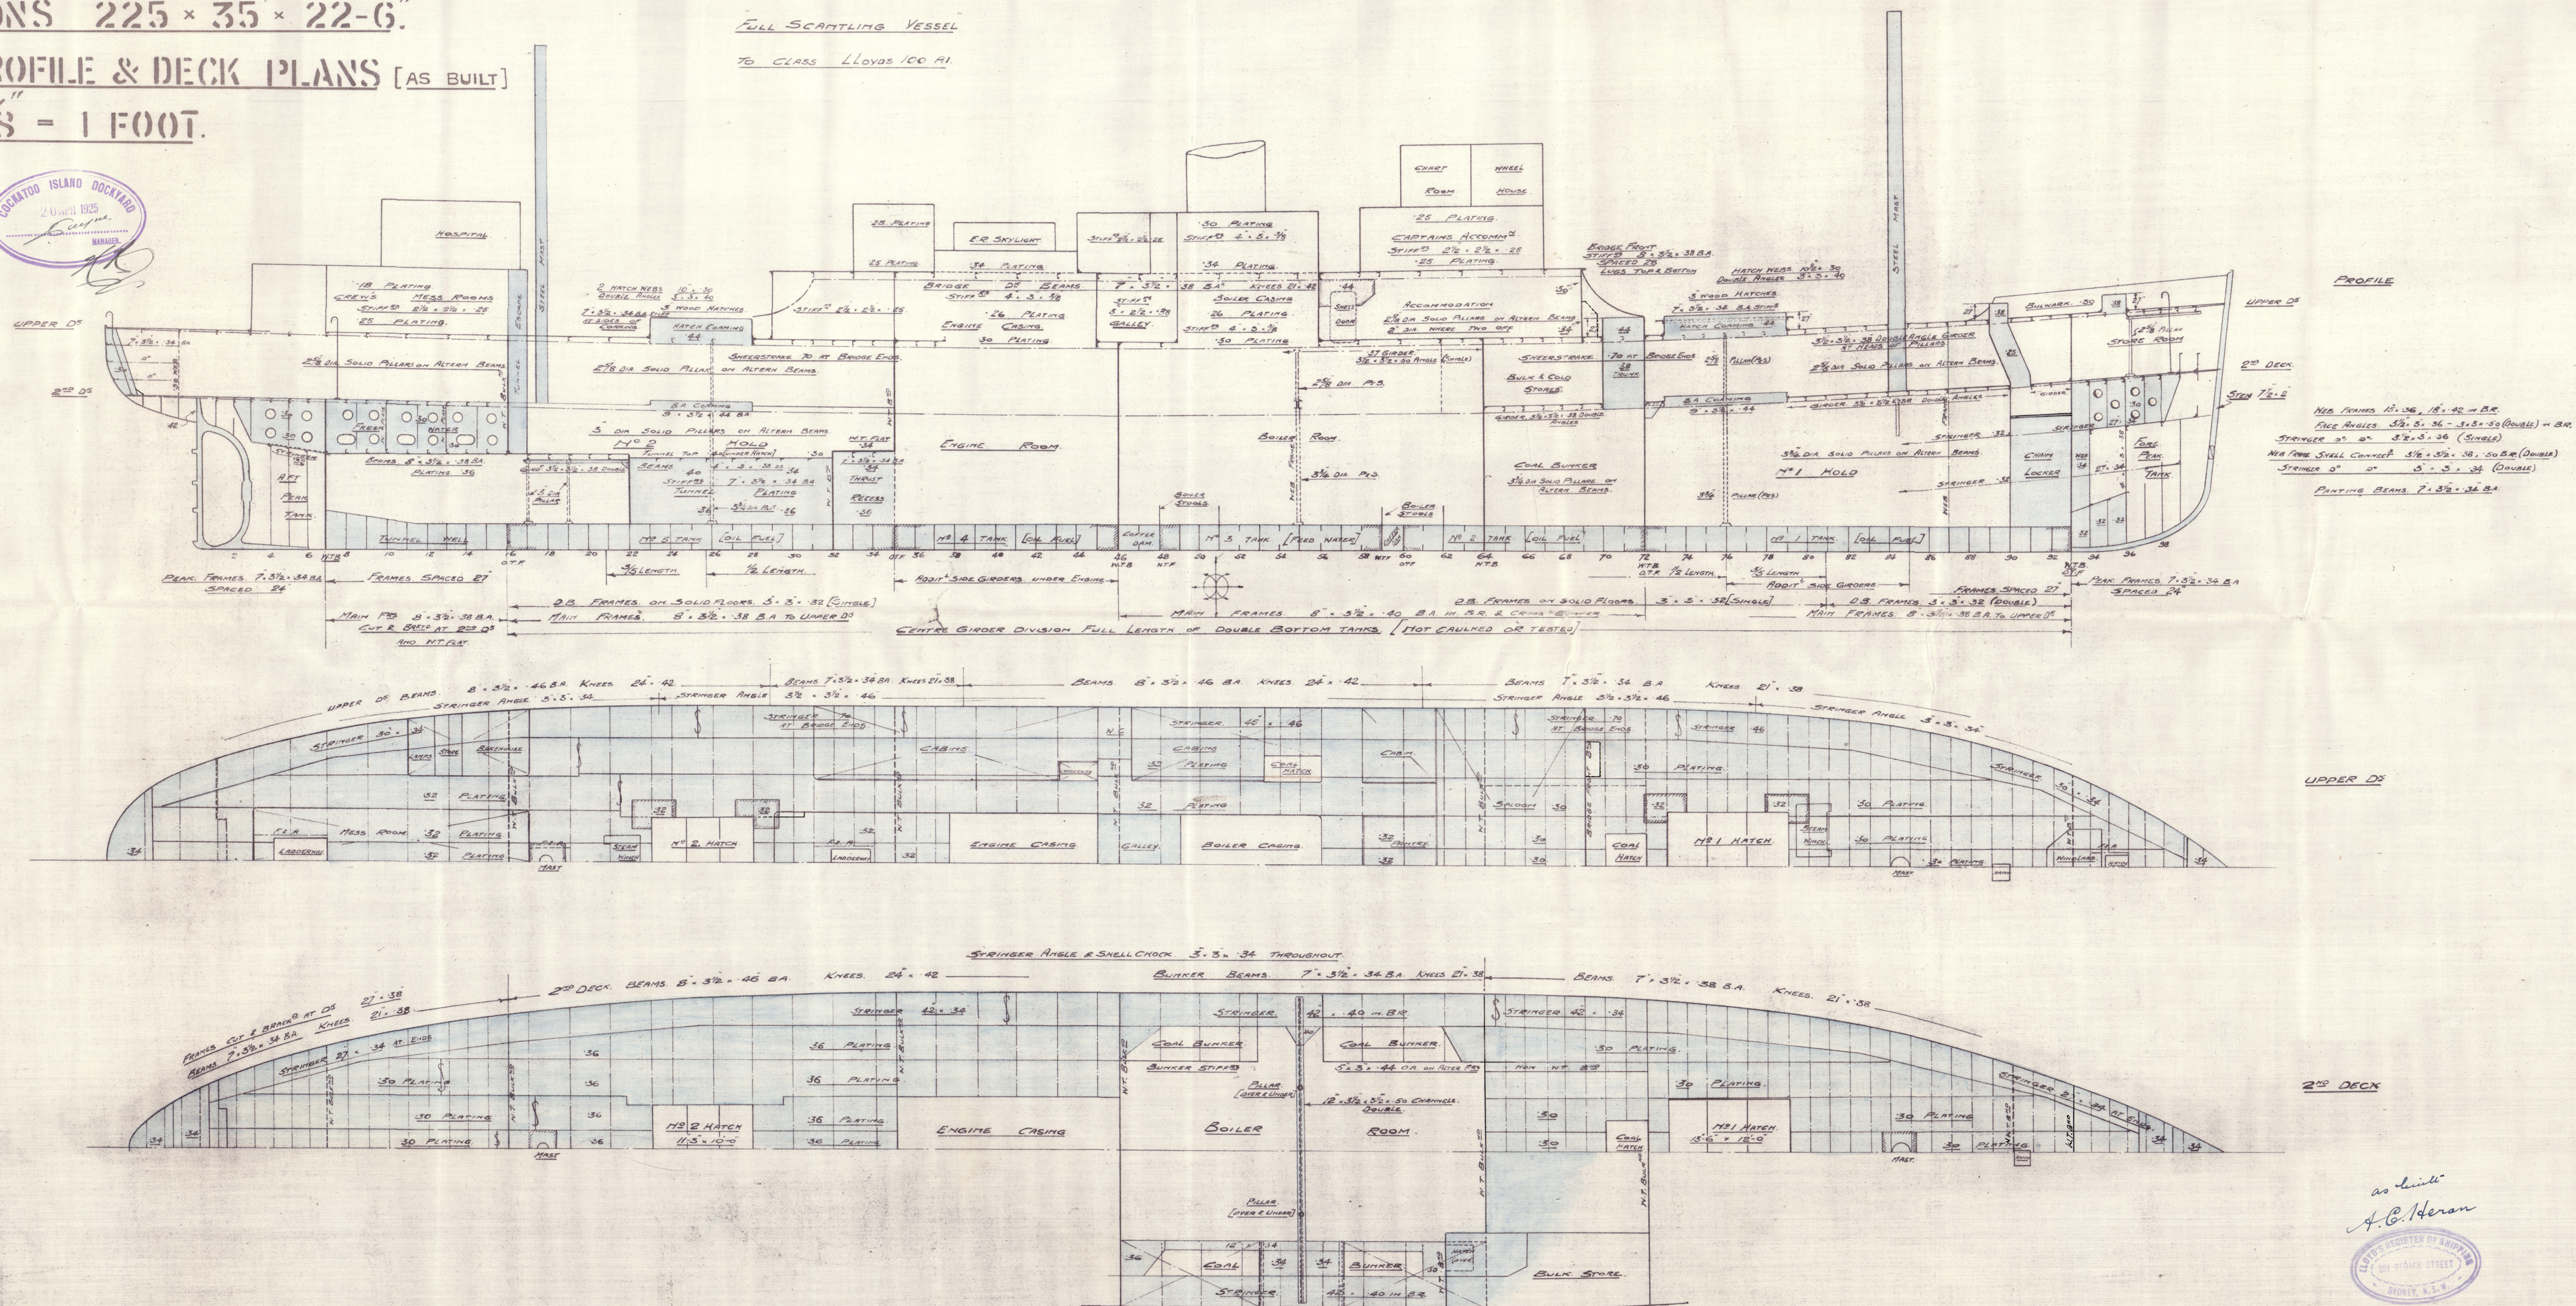

27-3-25

Q.B.



© 2020

Lloyd's Register Foundation  
009557-009567-24



S. S. "CAPE LEEUWIN"

PROFILE & DECK PLANS

VESSEL AS BUILT

COCKATOOS N<sup>o</sup> 101

---



© 2020

Lloyd's Register  
Foundation

009557009569-0247