


# DESIGN FOR A COASTING CARGO STEAMER.

• 116 Idship Section.

SCALE  $\frac{1}{25}$ .

DIM 120' x 22' x 9'-9" ~~9'-0" Draught~~

250 tons Deadweight.

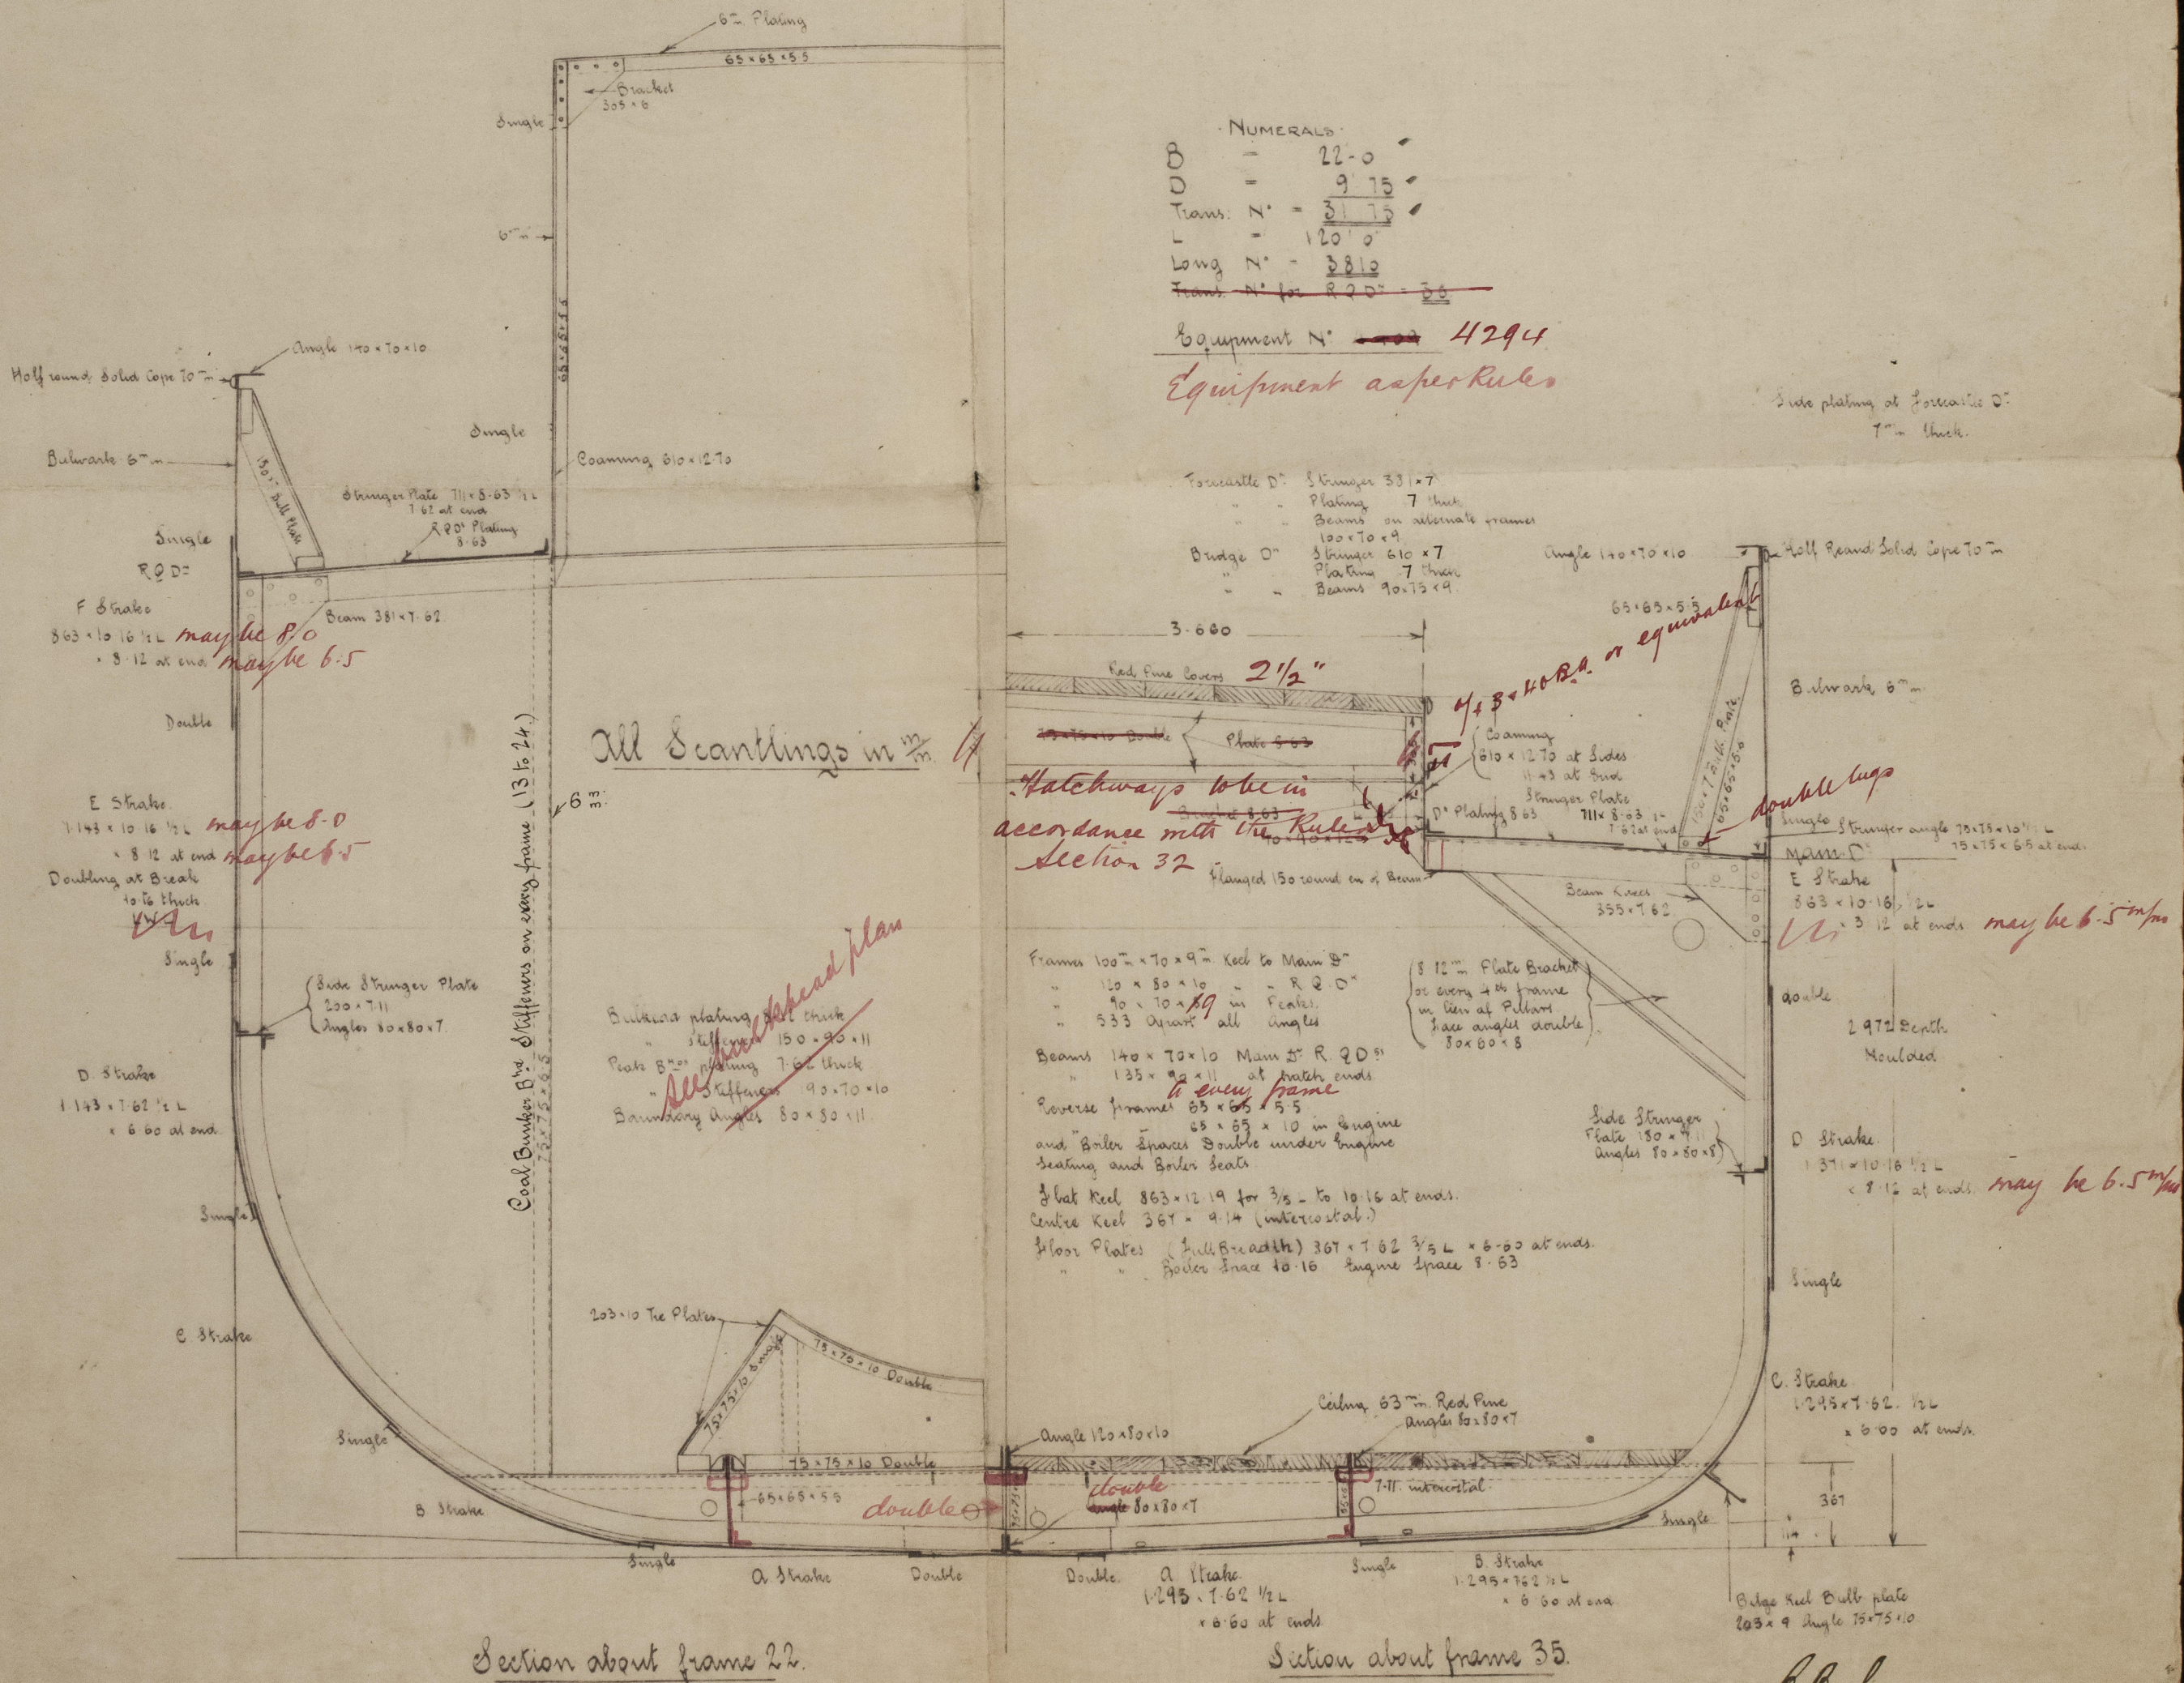



① "Lucrecia"  
② "Gloria"

Rbs 5283.

See WRECK INDEX

Rbs. 5321.

No. 1

Riera y Cia.

Gijon.

Midship Section

~~Gen Box 2247~~



© 2021

Lloyd's Register  
Foundation

009 570 - 009 579 - 0060