


PROFILE & DECK PLAN

DIMNS: 115'-0" B.P. • 27'-6" MLD. • 13'-6" MLD.
 TO CLASS \star 100A.I. FOR TOWING SERVICES
 SCALE: $\frac{1}{4}$ " = 1 FT.

SHIP NOS
 1297-8

PILLARING THROUGHOUT TO SURVEYOR'S
 SATISFACTION.

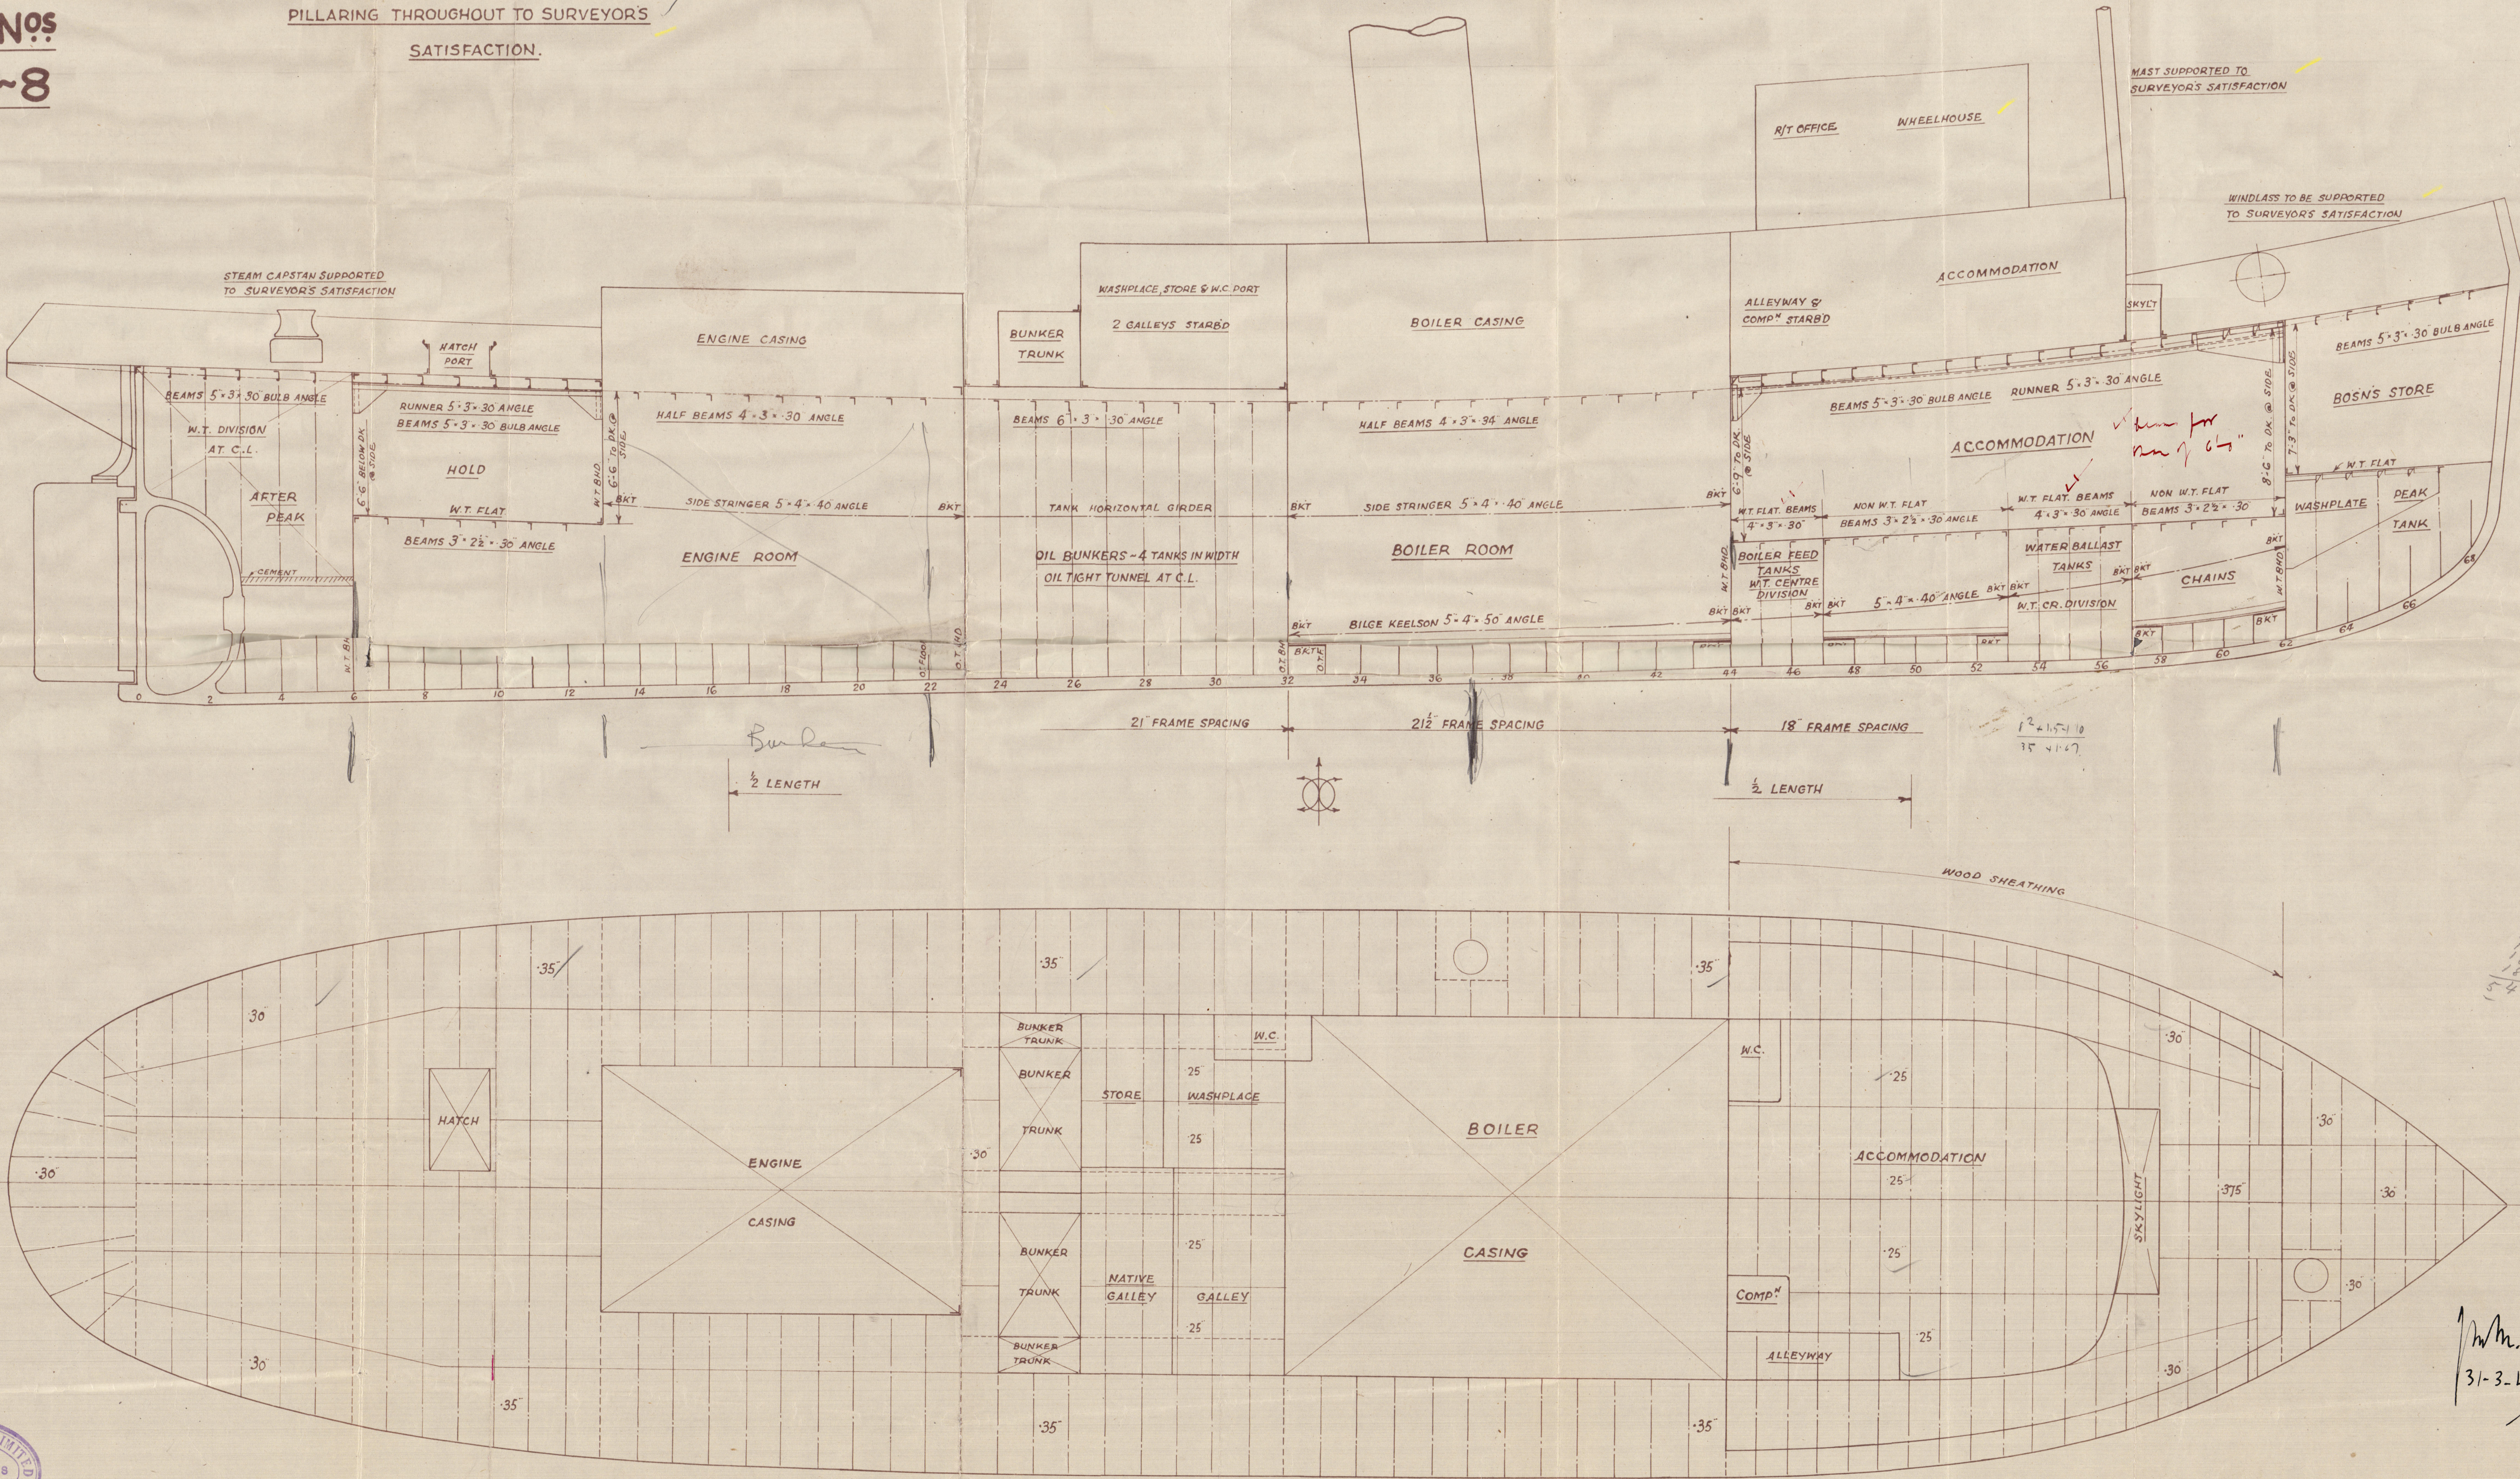

2

X Taurus X
ex
" Empire Flora "

D/S
470

COCHRANE & SONS
YARD NOS- 1297/8
1299-1304

PROFILE & DECKS

Hul 53089



© 2021

Lloyd's Register
Foundation

009570 - 009579 - 0082