

254-16

NO. 1-6

RUDDER, STERN FRAME & SHAFT BRACKET.



SCALE 1/2" TO ONE FOOT

Scantling Number :-

Trial Speed, Half Load 14 Knts
Service " 11 "
A, below Scarph 132.1 Sq. ft.
D 3.82 ft.
AXD, not forced 54.62

Materials :- Stern Frame Cast Steel
Shaft Bracket " "
Rudder Frame Forged "
" Stock " "
Pillies " "

Particulars :- Rudder Single Plate Type, Plate 1.00 Thick
" Head 10 1/2" dia.
Pillies 5 1/4" dia.
Riveting per Rule.

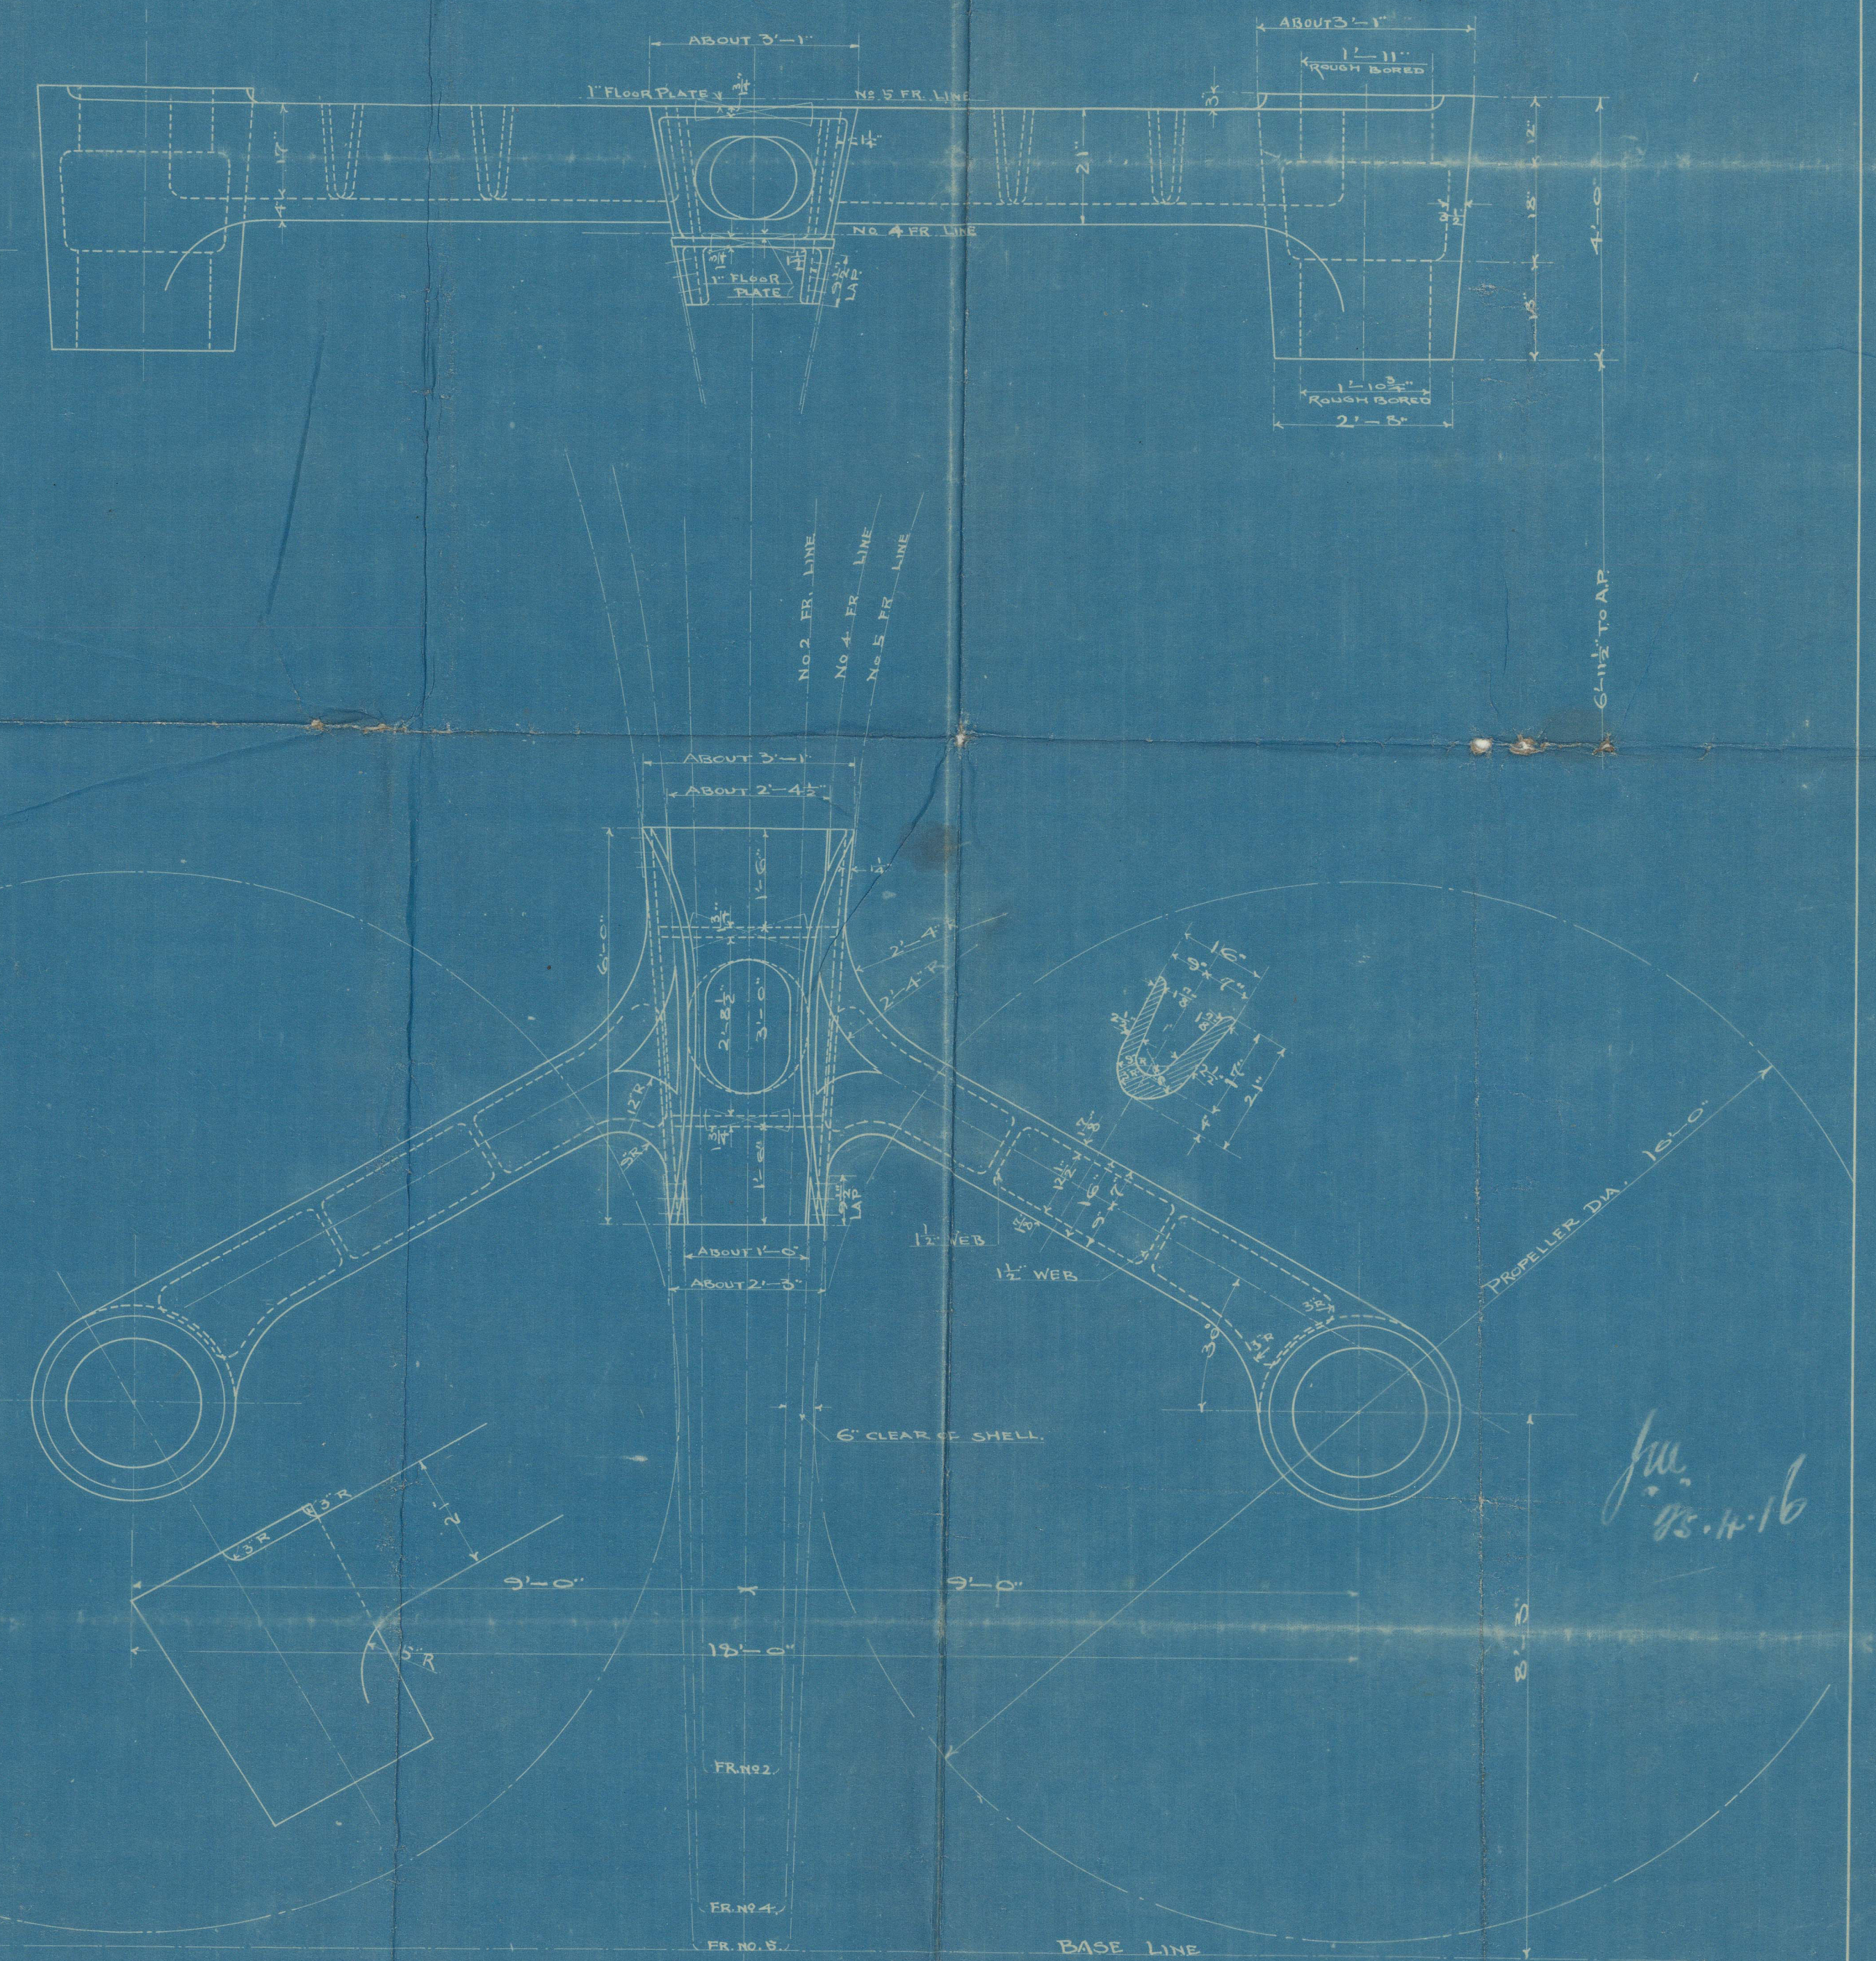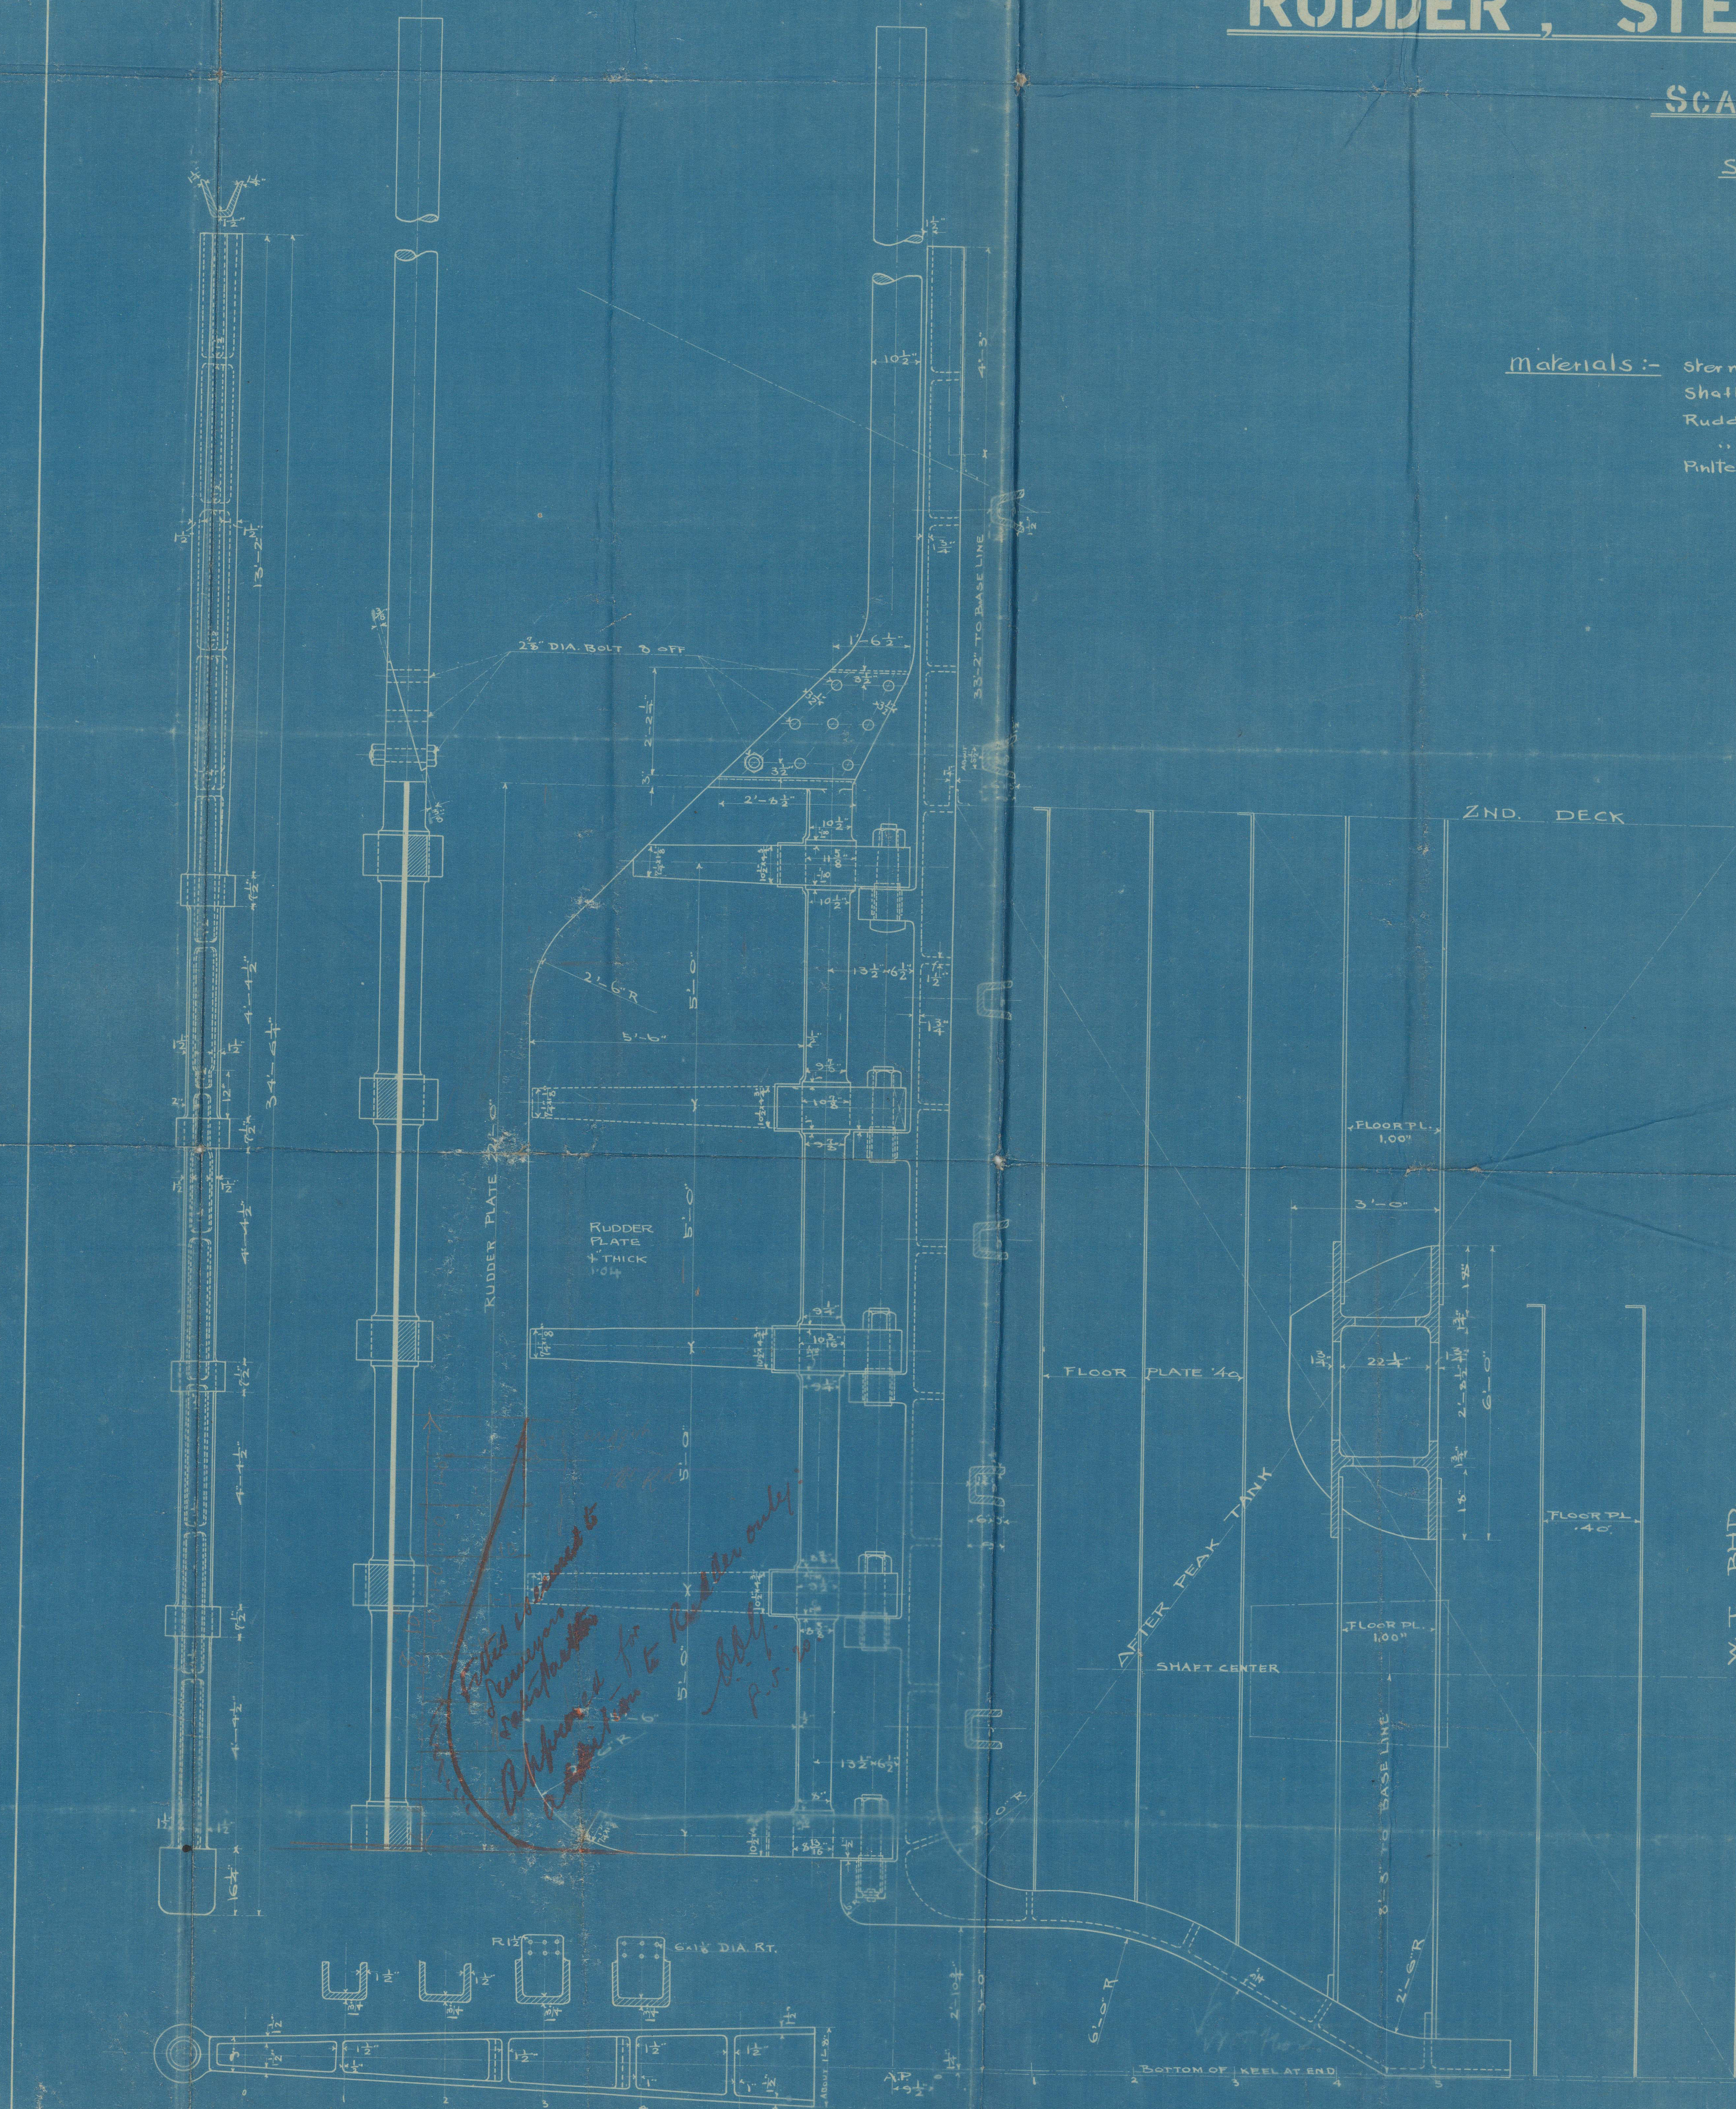

fm.
13.4.16

13.4.16

Rudder, Sternframe & Shaft Brackets

Hakushika Maru

n/n "Hakushika Maru."

Yka-2307.

Yka 2307.

(also "~~War Lance~~")




© 2020

Lloyd's Register
Foundation

009580-009589-0096

132
126
124
122

132

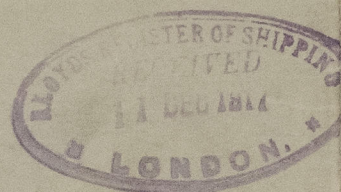

© 2020

Lloyd's Register
Foundation