

# S.S. IBUKISAN MARU.

## MIDSHIP SECTION.

TO CLASS TEISHINSHO RULE 1ST CLASS VESSEL  
& LLOYD'S 100 A.I. WITH FREEBOARD.


SCALE 1/2 IN. TO ONE FT.

PRINCIPAL DIMENSIONS	
LENGTH BETWEEN P.P.	385' 0"
BREADTH MOULDED	51' 0"
DEPTH MOULDED TO UPPER DK.	28' 6"
HEIGHT BETWEEN UPPER & AWNING DK.	8' 0"
" " " 2ND DK.	8' 6"
SCANTLING NUMBER	
B	51.00
D	28.05
TRANSVERSE NUMBER	19.05
LONG. NUMBER	385.00
2D TO AWNING DK.	10.68
d = 16' 0"	
EQUIPMENT NUMBER	
LONG. NUMBER	30.434.25
AWNING DECK (385' x 8' 3/4")	2,310.00
DECK HOUSES (126' 5" x 7' 5" x 3")	490.19
NUMERAL	33,234.44

EQUIPMENT	
1 BOWER ANCHOR (STOCKLESS) 70 CWT. QWR. 51 LB.	
" " " " 70 CWT. QWR. 25 LB.	
" " " " 59 CWT. 1 QWR. 61 LB.	
1 STREAM " (COMMON) 16 CWT. 2 QRS. 15 LB. EX. STOCK	
1 KEDGE " " " 7 " " 25 " "	
2 7/8" FATHOMS 2 1/2" STUP. CHAIN CABLE	
60 " 4 3/4" STEEL WIRE FOR STREAM ANCHOR	
120 " 4 3/4" " " " " " " " " " " " "	
2 COILS OF 90 FATHOMS OF 8" MANILA	
" " " 90 " " 7 " " "	

ROWS OF RIVETS IN BUTTS		
ITEMS	1/2 L &	ATENDS
AWNING DK. STRINGER PLATE	3	3-2
" " PLATING	2	2
UPPER DK. STRINGER PLATE	3	3-2
" " PLATING	2	1
SECOND DK. STRINGER PLATE	2	2
" " PLATING	2	1
SHEER STRAKE	4	3
STRAKE BELOW SHEER STRAKE	4	3
SIDE PLATING	4	3
BOTTOM PLATING	4	3
KEEL	4	4-3
MIDDLE STRAKE OF INNER BOTTOM	3	2
INNER BOTTOM PLATING	2	1
MARGIN PLATE	3	2
CENTRE GIRDER	3	3

**RIVETING IN SHELL TO FRAMES**  
RIVETS 7/8" DIA. THROUGHOUT SPACED 7" DIA. APART  
EXCEPT IN PEAK TANKS, DEEP TANK & BOTTOM  
BEFORE 3/4" L & WHERE 5 1/2" DIA. APART.

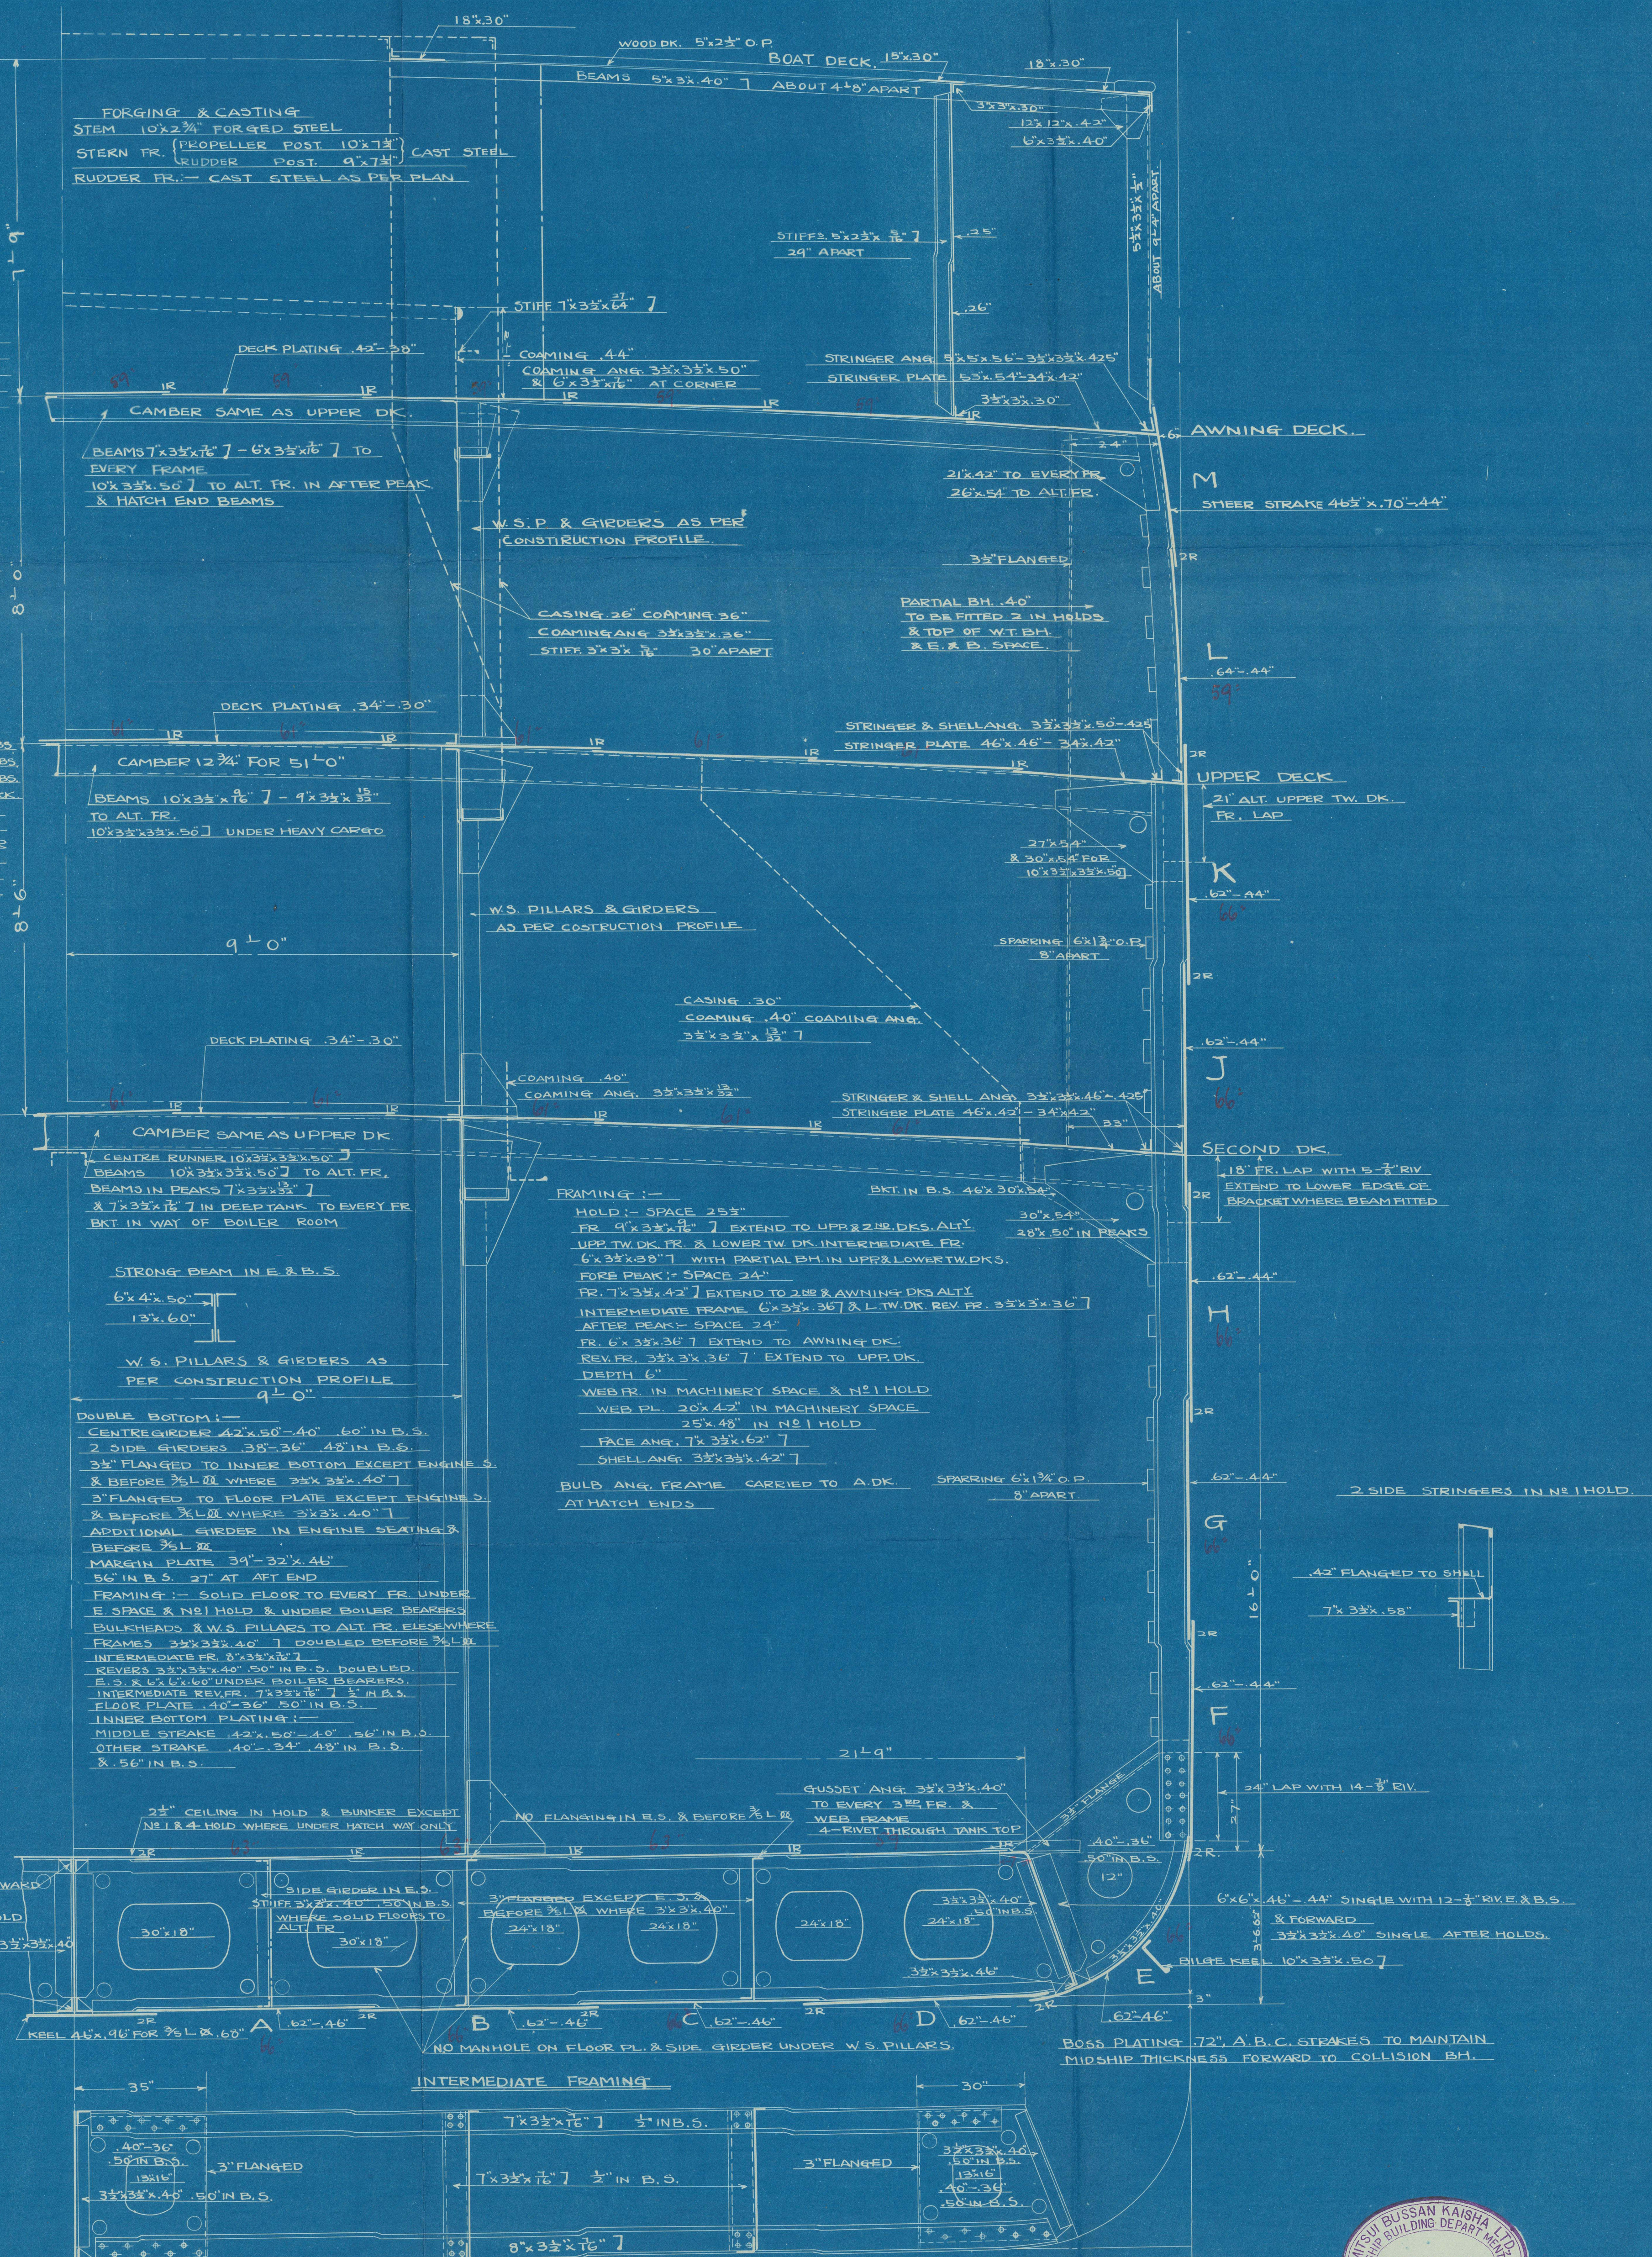



S.S. <sup>(D)</sup>Hokusai Maru. Kbe 3516.

Midship Section

Larkin



© 2020

Lloyd's Register  
Foundation

009590-009589-0158