

30.4.10.

PLAN No 9203  
Messrs Lloyd's Surveyors  
Hull  
COOPER & SONS,  
SHIPBUILDERS & ENGINEERS  
26/4/10. RK

# MIDSHIP SECTION

STEEL SCREW TRAWLER

## N° 470


LENGTH B.P. 115'0" x 21'6" EX x 12'3" DEPTH M.L.D.

SCALE 1/2" = 1 FOOT

TO CLASS 100.A1 STEAM TRAWLER

*Handwritten notes in red ink:*  
"Hull of 1st class steam trawler"  

**RIVETING**  
BUTTS OF SHELL PLATING LAPPED & DOUBLE RIVETED EXCEPT GARBBOARD & SHEERSTRAKE WHICH ARE TO BE STRAPPED & DOUBLE RIV. LANDINGS DOUBLE RIV. BULKHEADS SINGLE RIV. BUTTS OF STRINGER & TIE PLATES OVERLAPPED & DOUBLE RIV.

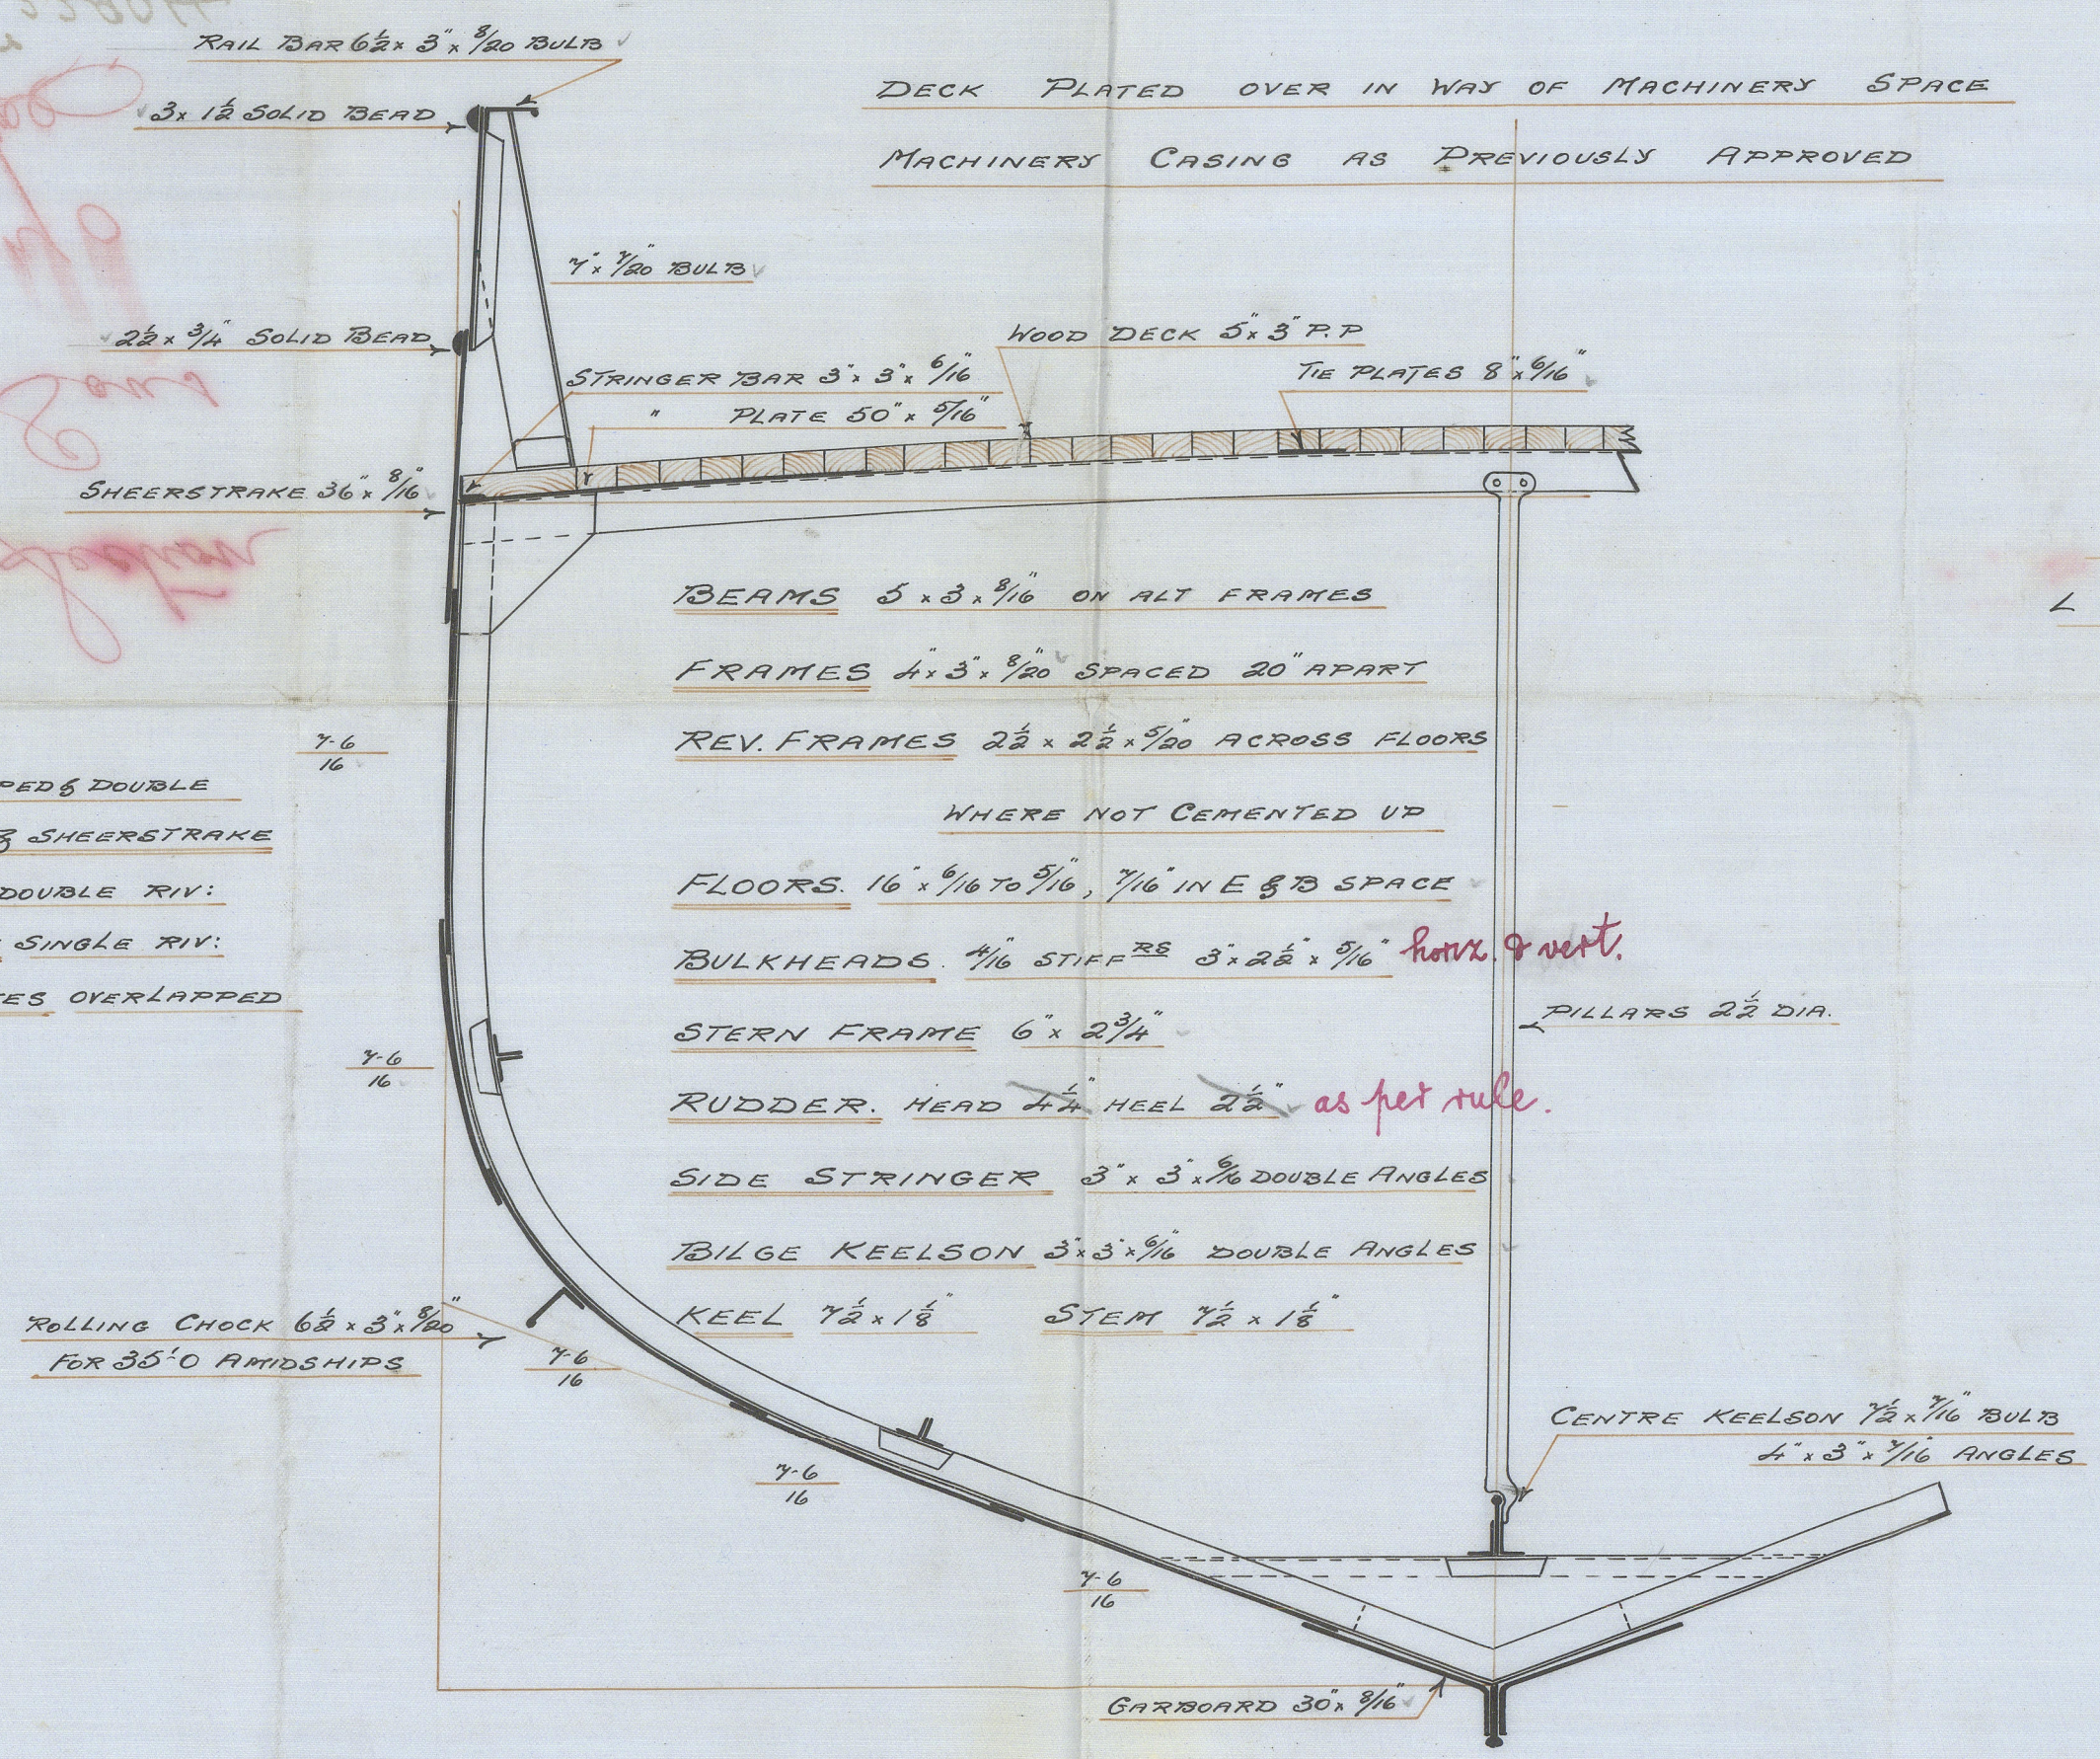

DECK PLATED OVER IN WAY OF MACHINERY SPACE  
MACHINERY CASING AS PREVIOUSLY APPROVED

### NUMERALS

B + D	=	33.6
L x (B + D)	=	3864

### PROPORTIONS

L/B	=	5.37
L/D	=	9.38

### EQUIPMENT

1 <sup>ST</sup> DOWNER ANCHOR	5 CWTs EX STOCK
2 <sup>ND</sup> " ANCHOR	1 1/2 " " "
KEDGE ANCHOR	2 1/2 " " "
90 FATH M/S	1" CABLE
60 "	3/4" HANSE
60 "	4" WARP.

LLOYD'S REGISTER  
OF SHIPPING.  
27 APR 1910  
HULL.

Cf.  
30/4/10.



- Midship Section  
Cochrane & Sons

A 0440

s/s Prince Victor  
Hull Report No 22904

Longitudinal members  
Hull

drop



© 2020

Lloyd's Register  
Foundation

00 9601 - 009609 - 0027