

30.4.10.

PLAN No 922
New Lloyd's Surveyors
Hull
DATE 26/4/10 RR



PROFILE & DECK PLAN N^o 470

DIM^{NS} 115'0" x 21'6" EX x 12'3" DEPTH M^{LD}

SCALE 1/4" = 1 FOOT

NOTE: PILLARS THROUGHOUT TO SURVEYORS SATISFACTION.

Handwritten notes in red ink:
26/4/10
26/4/10

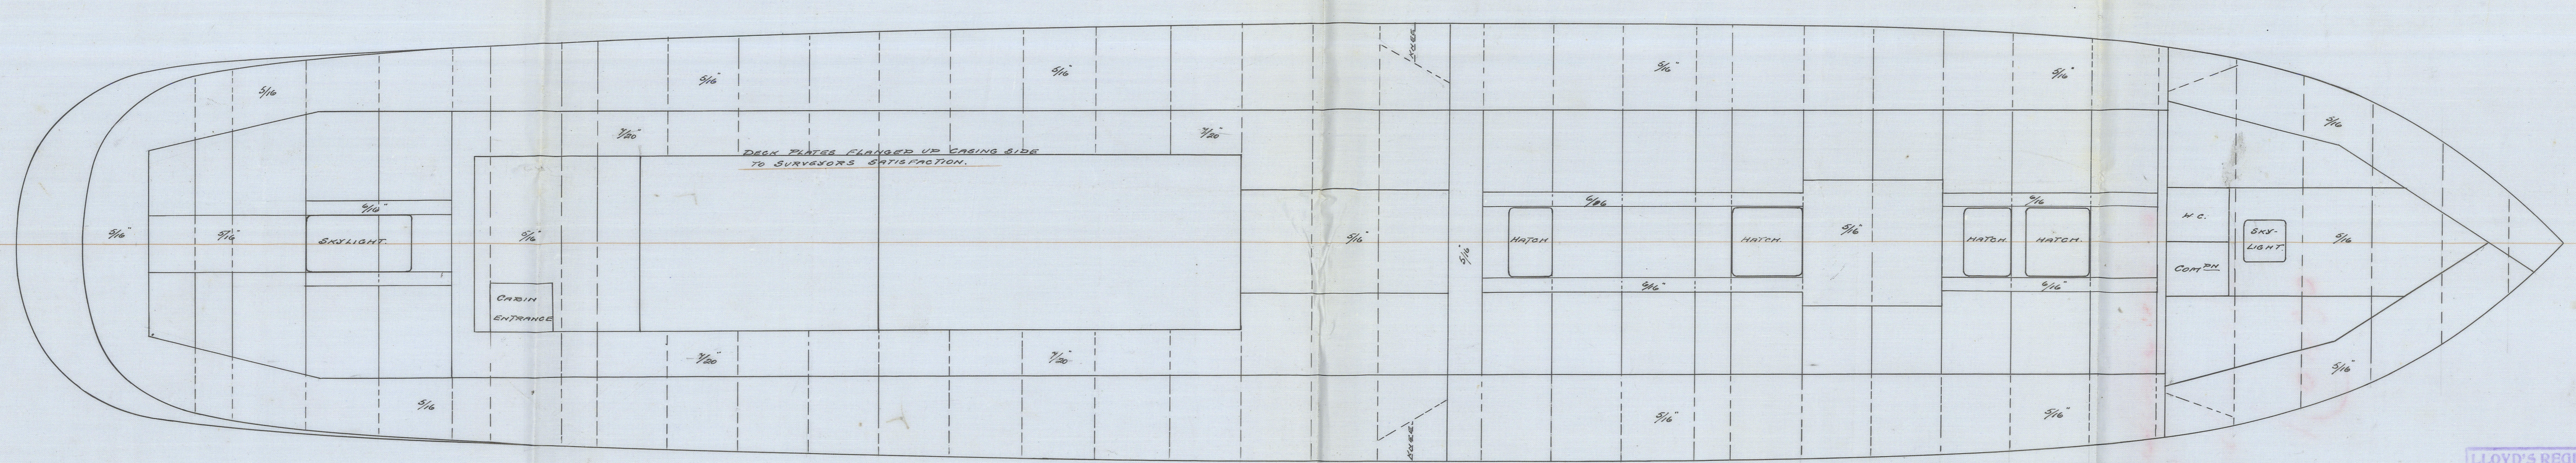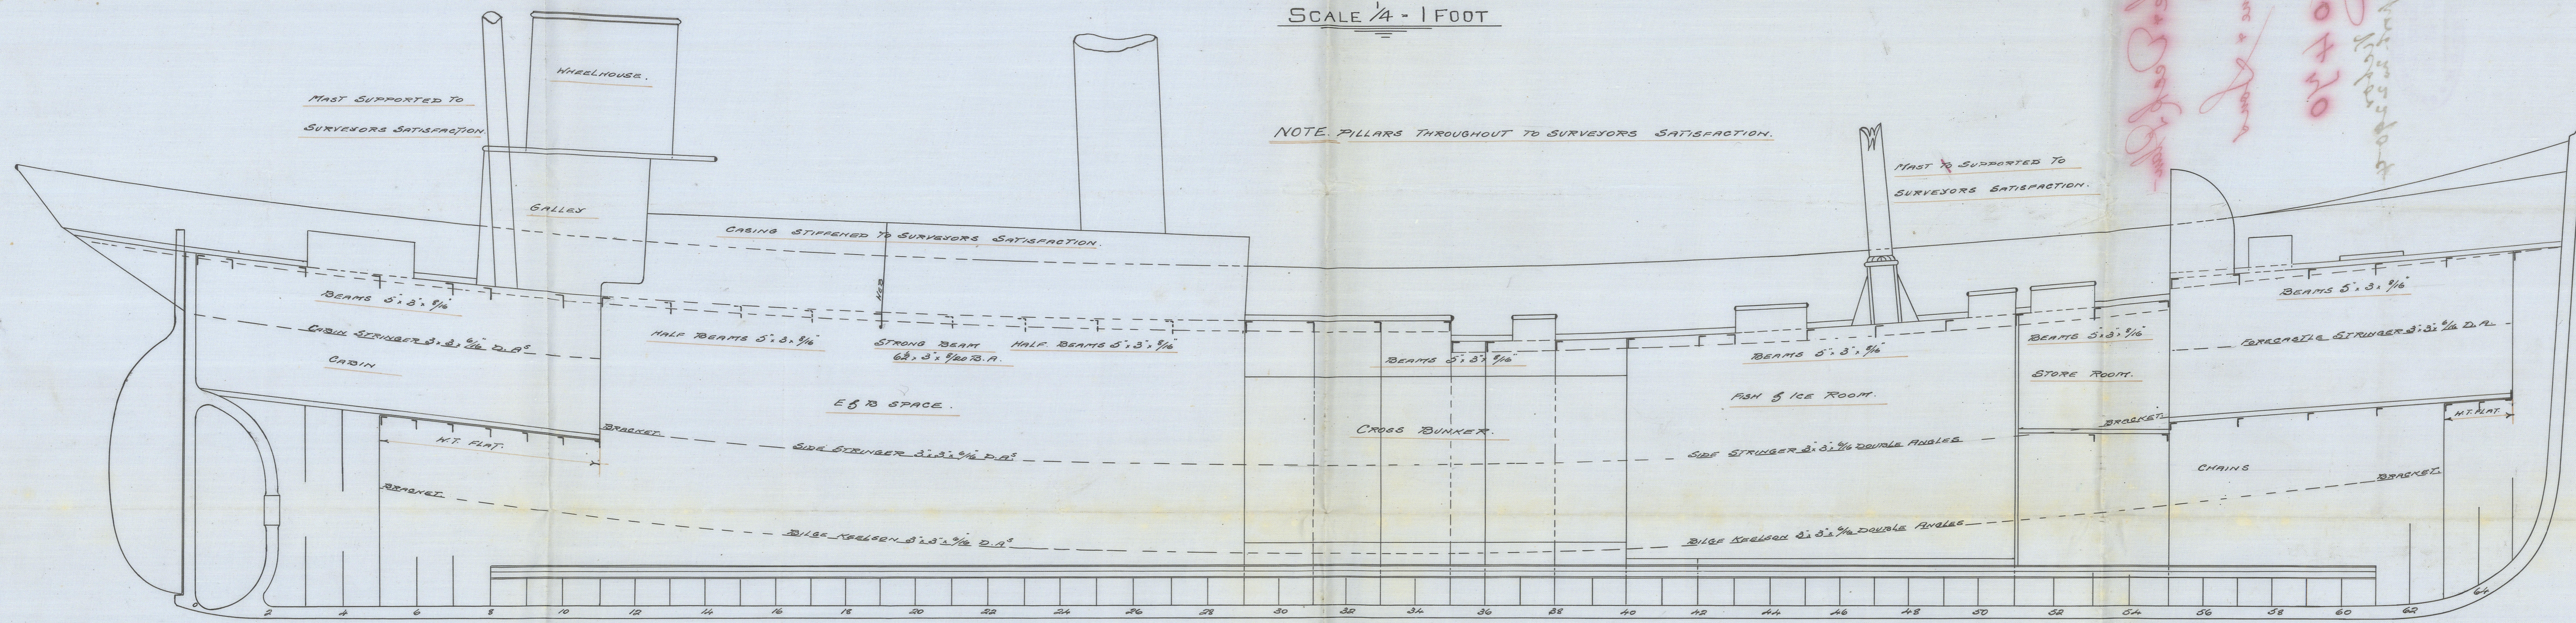

LLOYD'S REGISTER
OF SHIPPING
6 APR 1910
HULL

Handwritten notes:
C.T.
30/4/10

Cochrane & Sons

№ 0440

5/6 Prince Victor
Hull Report No 2290-4

© 2020

Lloyd's Register
Foundation