

11. 6. 03


8/4/03.

-To CLASS A.1. STEEL HOPPER DREDGER.

SCALE $\frac{1}{2}$ INCH = 1 FOOT

Length as per Rule	192.91
Breadth Moulded	34.00
Depth	15.25


Proportions
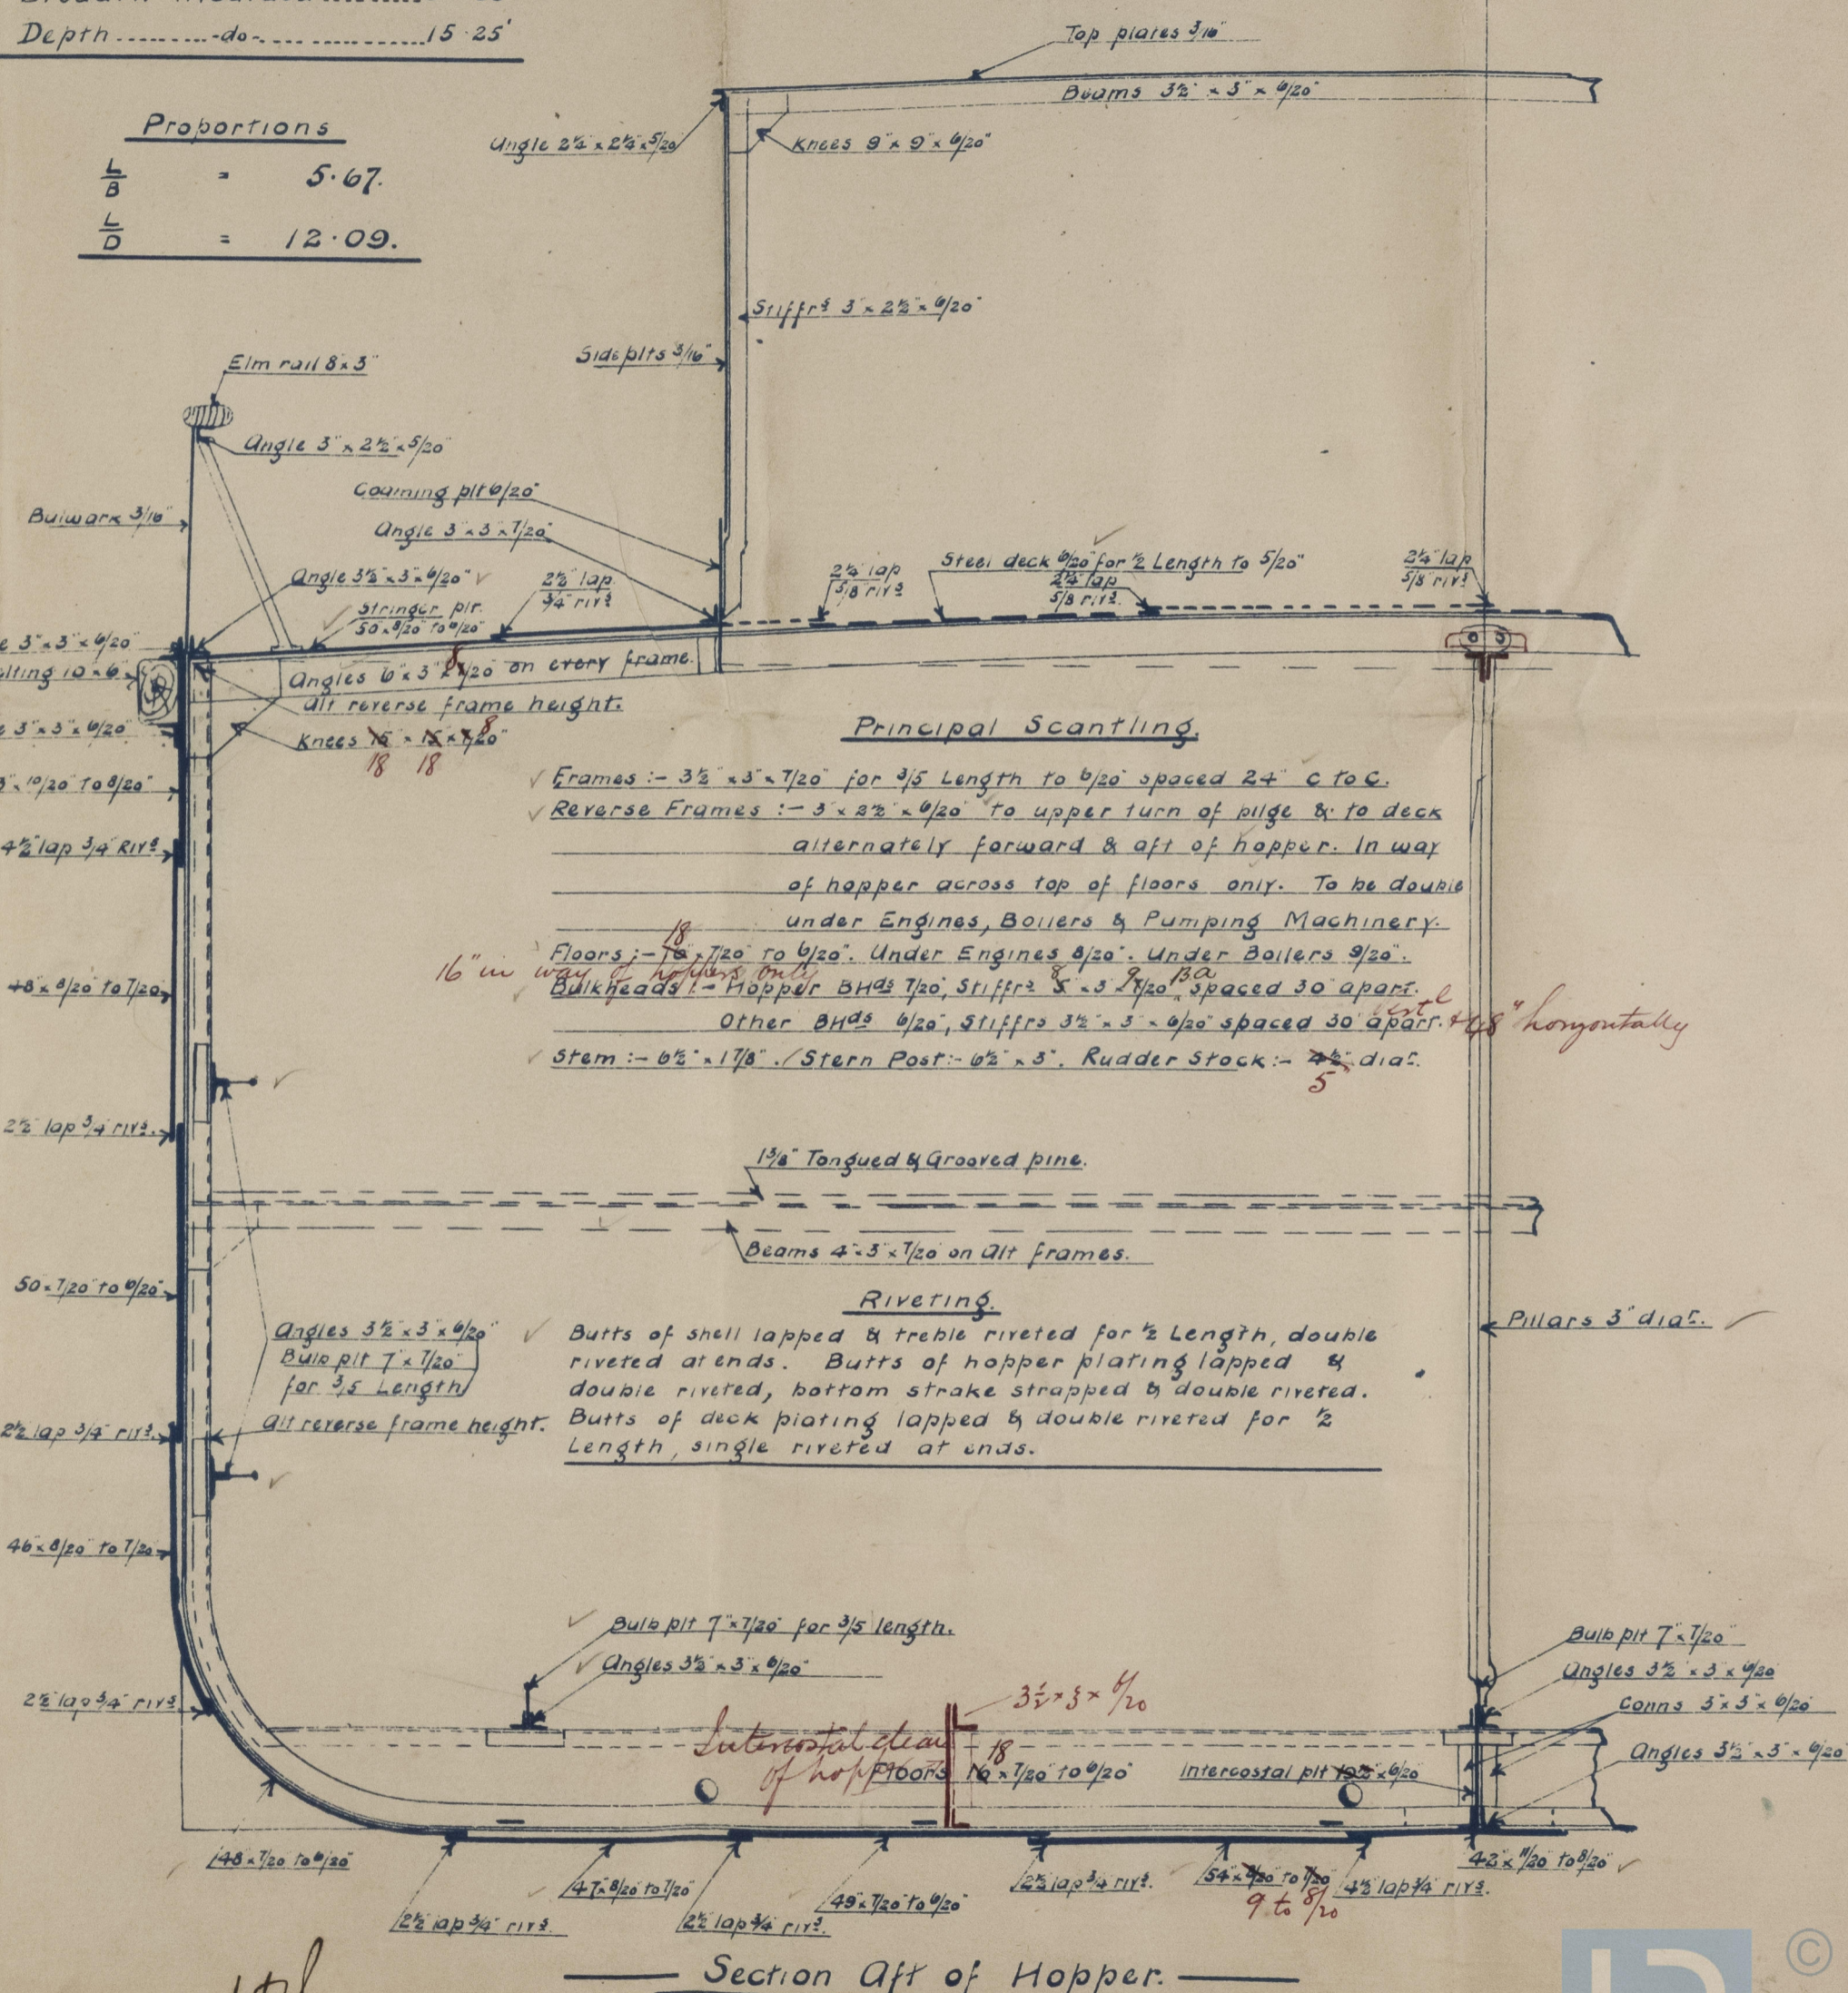
$$\frac{L}{B} = 5.67.$$
$$\frac{L}{D} = 12.09.$$


11/6/03

Messrs W. Simons & Co
Sand Pump Hopper dredger
No 408

Midship Section

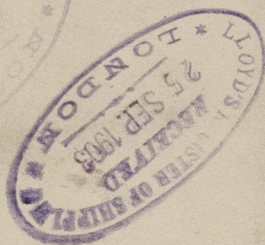

"Madras"

Glasgow No 21549



© 2020

Lloyd's Register
Foundation

009601 - 009609 - 0117