

Certificate of Freeboard:

Name of Classification Society: *Lloyd's Register of British and Foreign Shipping*
Name of ship: *S.E.S. "Selandia"* Gross Tonnage: *4964*
Port of registry: *Copenhagen* Year when built: *1912*
Owner: *Det Jøstaniatiske Komp.* Class: *100 A1 Awning deck with freeboard*
Type: *Awning Deck.*

- F. W. Summer freeboard in fresh water 5 ft. 10 in = 1778 mm below the upper edge of the statutory deck line
T. Summer freeboard in tropical seas 5 ft. 11 in = 1803 mm below the upper edge of the statutory deck line
S. Summer freeboard (centre of disc) 6 ft. 4 in = 1930 mm below the upper edge of the statutory deck line
V. Winter freeboard 6 ft. 9 in = 2057 mm below the upper edge of the statutory deck line
N. A. Winter freeboard in north Atlantic ft. in = mm below the upper edge of the statutory deck line


The statutory deck line is ~~to be~~ marked in accordance with *British*

Board of Trade's freeboard tables:- 2" =
51 mm above wood awning deck at side.

This is to certify that the freeboard of the D.E./S.

"S e l a n d i a" of Copenhagen, $\frac{4964}{3172}$ Tons, has been marked on the vessel's sides in accordance with the above.


Copenhagen, 17th February 1912.

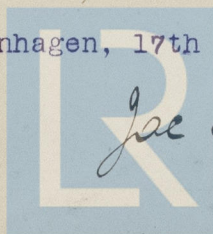

Joe. Romer
SURVEYOR TO LLOYD'S

REGISTER OF SHIPPING

009601-009609-0212

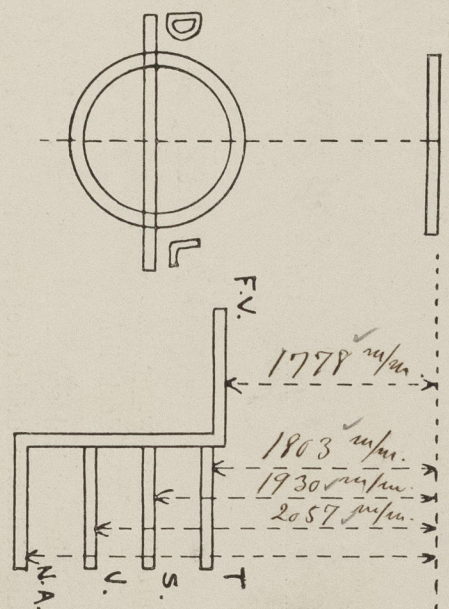

© 2020

Lloyd's Register
Foundation