

Certificate of Freeboard

Name of Classification Society: *Lloyd's Register of British and Foreign Shipping*
 Gross Tonnage: *4984*
 Port of registry: *Copenhagen*
 Year when built: *1912*
 Class: *1/2 ton A 1 Gunning deck with foreland*
 Type: *Gunning deck*

F.W.	Summer freeboard in fresh water	3 ft. 10 in = 1178 mm below the upper edge of the statutory deck line
T.	Summer freeboard in tropical seas	2 ft. 11 in = 1103 mm below the upper edge of the statutory deck line
S.	Summer freeboard (centre of disc)	6 ft. 4 in = 1930 mm below the upper edge of the statutory deck line
V.	Winter freeboard	6 ft. 9 in = 2057 mm below the upper edge of the statutory deck line
A.	Winter freeboard in north Atlantic	6 ft. 9 in = 2057 mm below the upper edge of the statutory deck line

The statutory deck line is ~~to be~~ marked in accordance with *British*
 Board of Trade's freeboard tables: - 2" = *21 mm above wood gunning deck at side.*


This is to certify that the freeboard of the D.E.S. "Selandia" of Copenhagen, $\frac{4984}{8172}$ Tons, has been marked on the vessel's sides in accordance with the above.

Copenhagen, 17th February 1912.

SURVEYOR TO LLOYD'S REGISTER OF SHIPPING
Jac. J. J. J.



© 2020
 Lloyd's Register Foundation

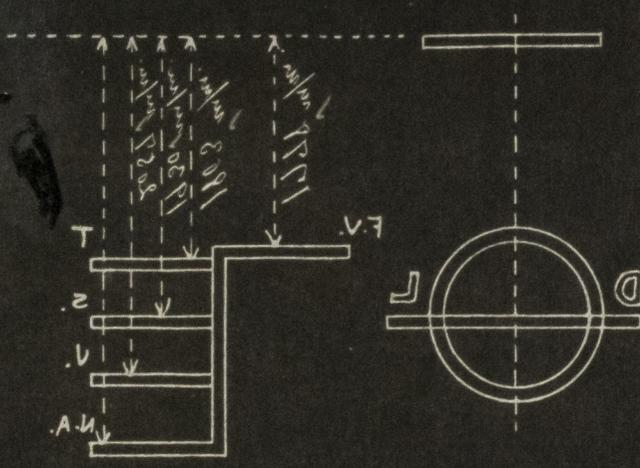

© 2020

Lloyd's Register
Foundation