

# Nº280. PROFILE & DECK PLAN.

## TWIN SCREW BOW-WELL BARGE LOADING\_BUCKET HOPPER DREDGER.

FERGUSON BROS.  
(PORT-GLASGOW) LTD  
SHIPBUILDERS & ENGINEERS

LLOYDS NUMERALS.

$$L=222. B=43. D=17.5.$$

$$\frac{L}{D} = \frac{222}{17.5} = 12.7 \quad d = 15.42$$















$$1^{ST} \text{ LONG}^L N^0 = L \times D = 222 \times 17.5 = 3885$$

$$2^{ND} \text{ LONG}^L N^0 = L \times (B+D) = 222 \times (43+17.5) = 13431.$$

TO LLOYDS LATEST REVISED RULES & REGULATIONS. CLASS LLOYDS 100A1 HOPPER DREDGER.

DIMENSIONS: 222-0' LLOYDS LENGTH BETWEEN PERPS  $\times$  43-0'  $\times$  17-6' MOULDED

SCALE  $\frac{1}{2}$ " = 1 FT. BULKHEADS  $\frac{1}{4}$ " = 1 FT.

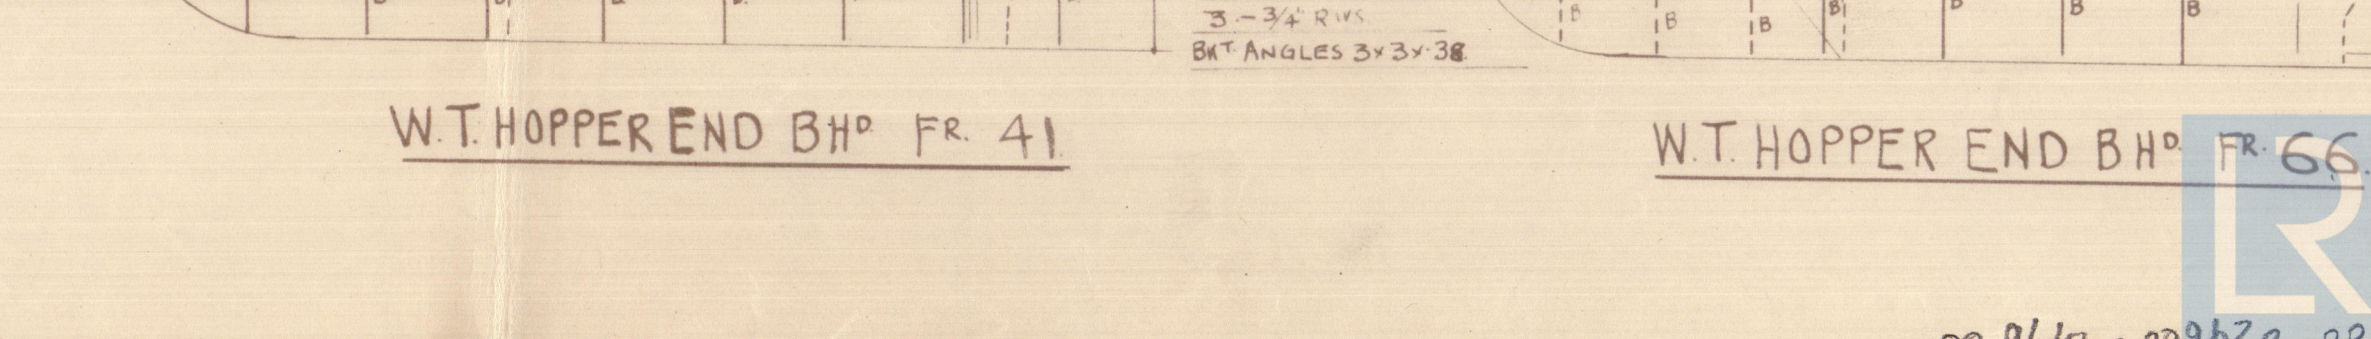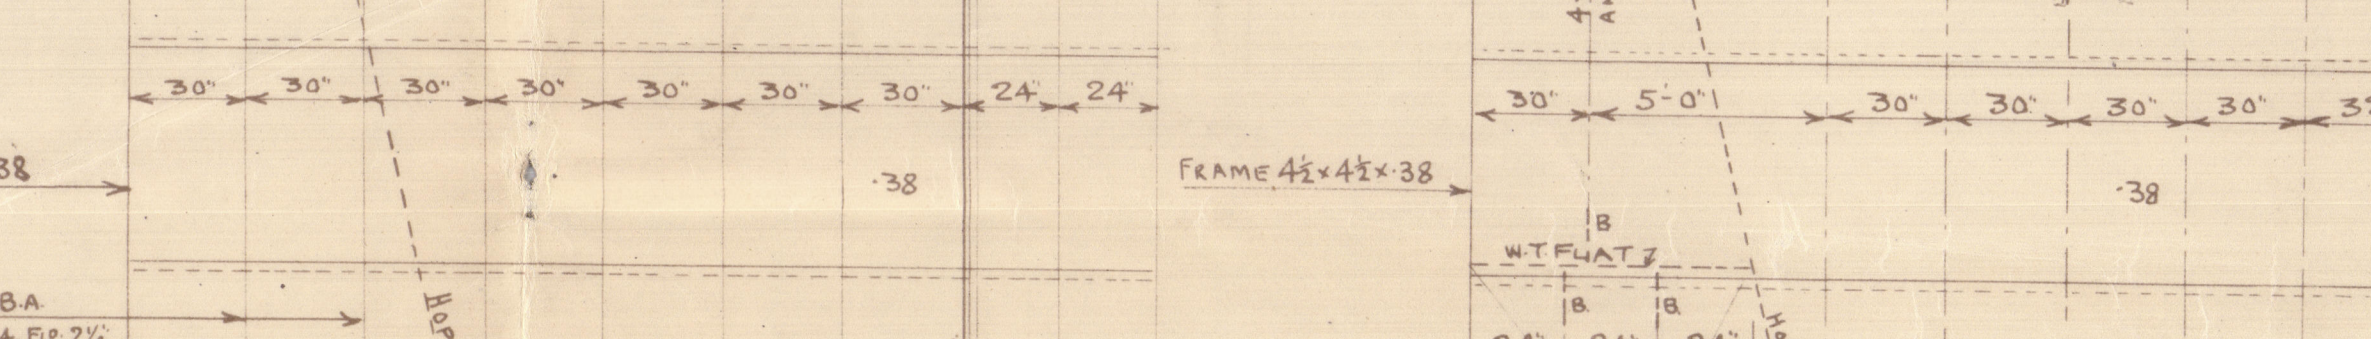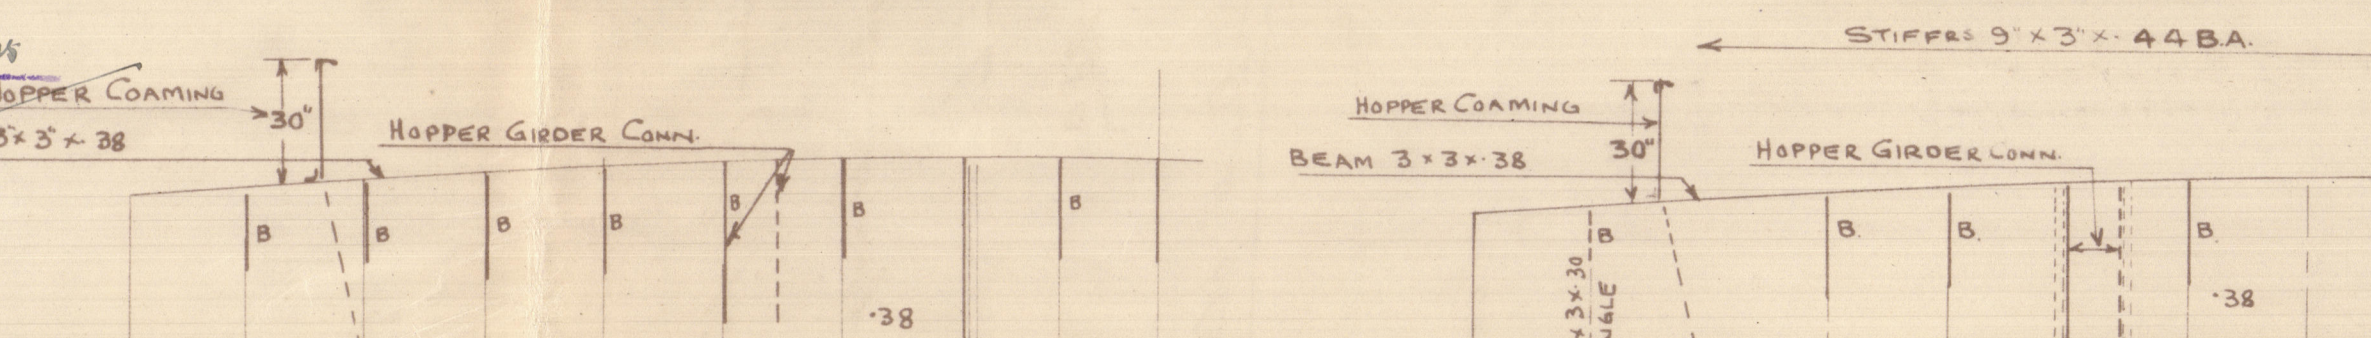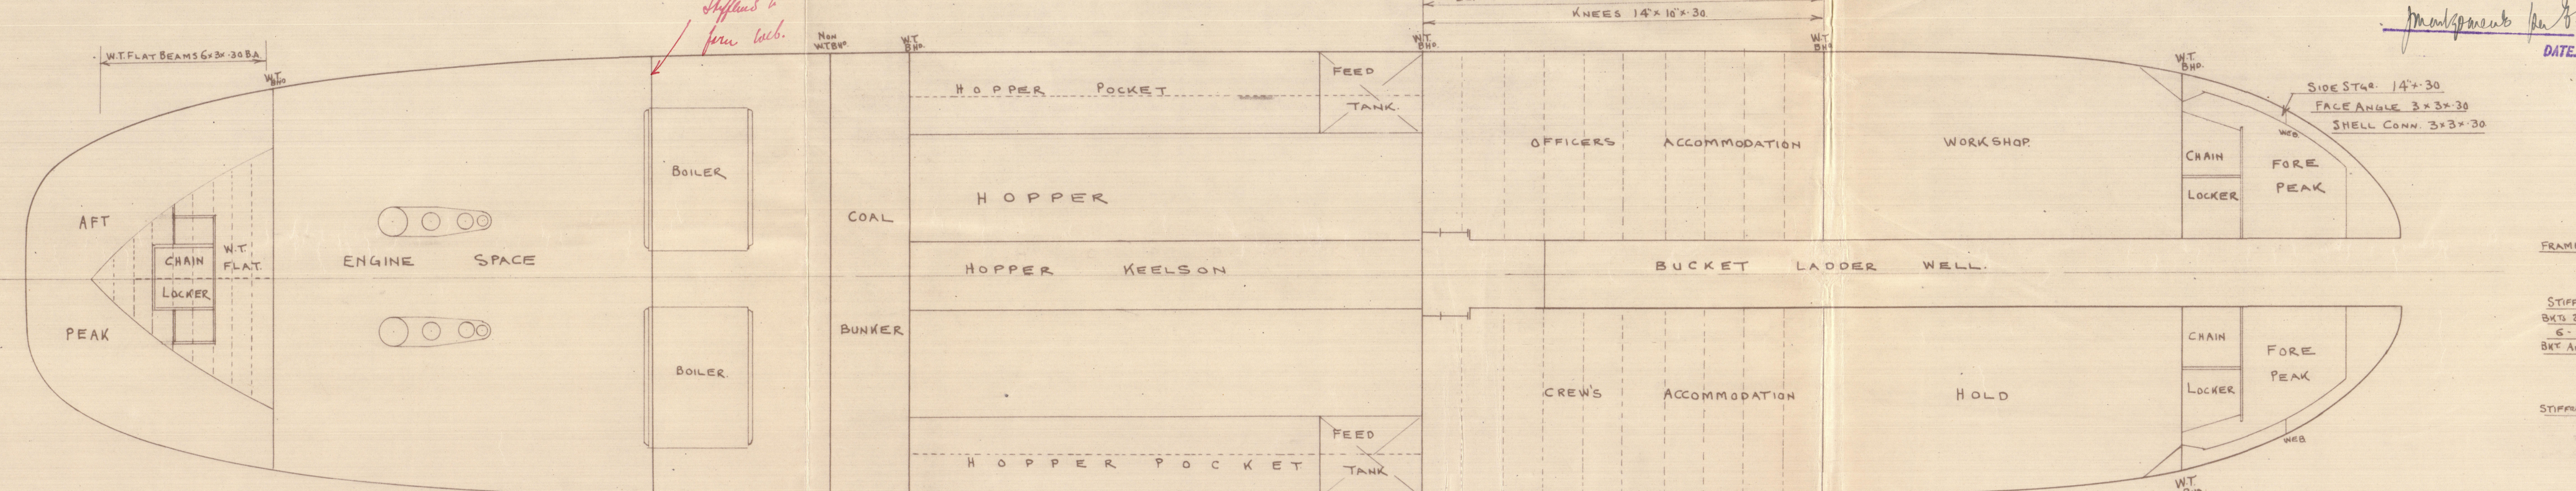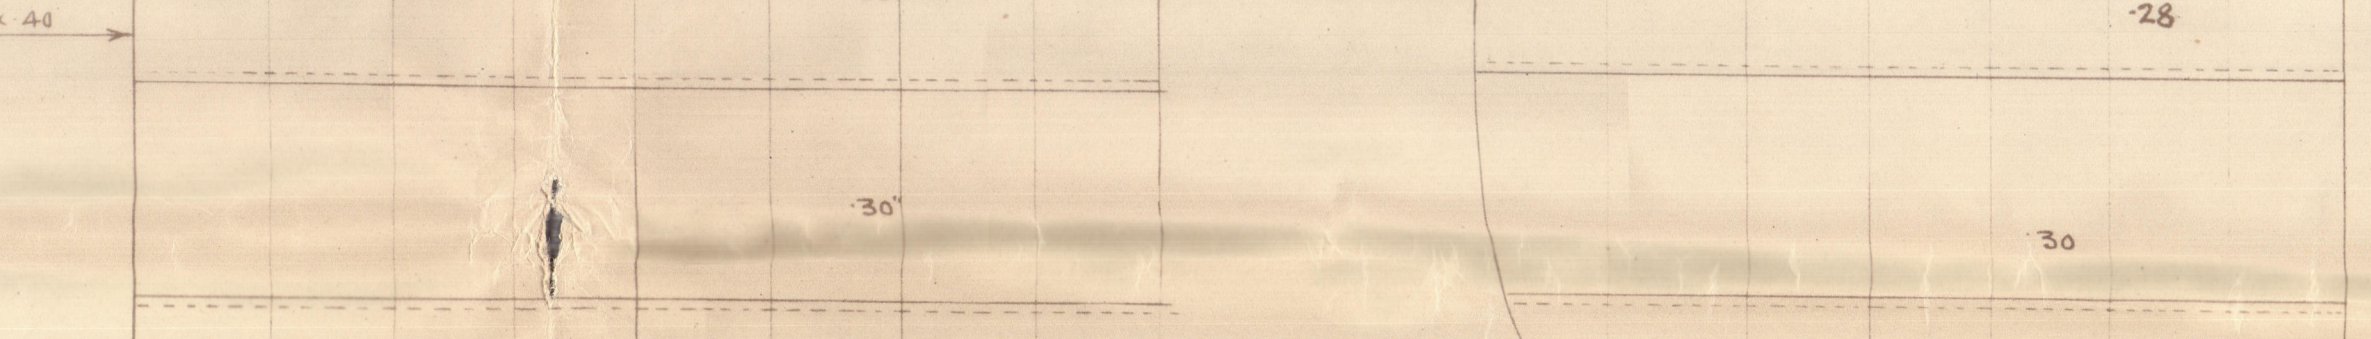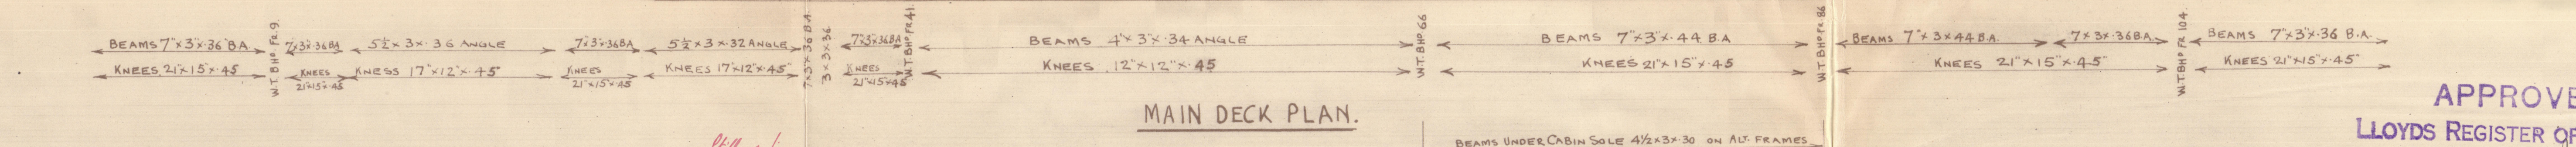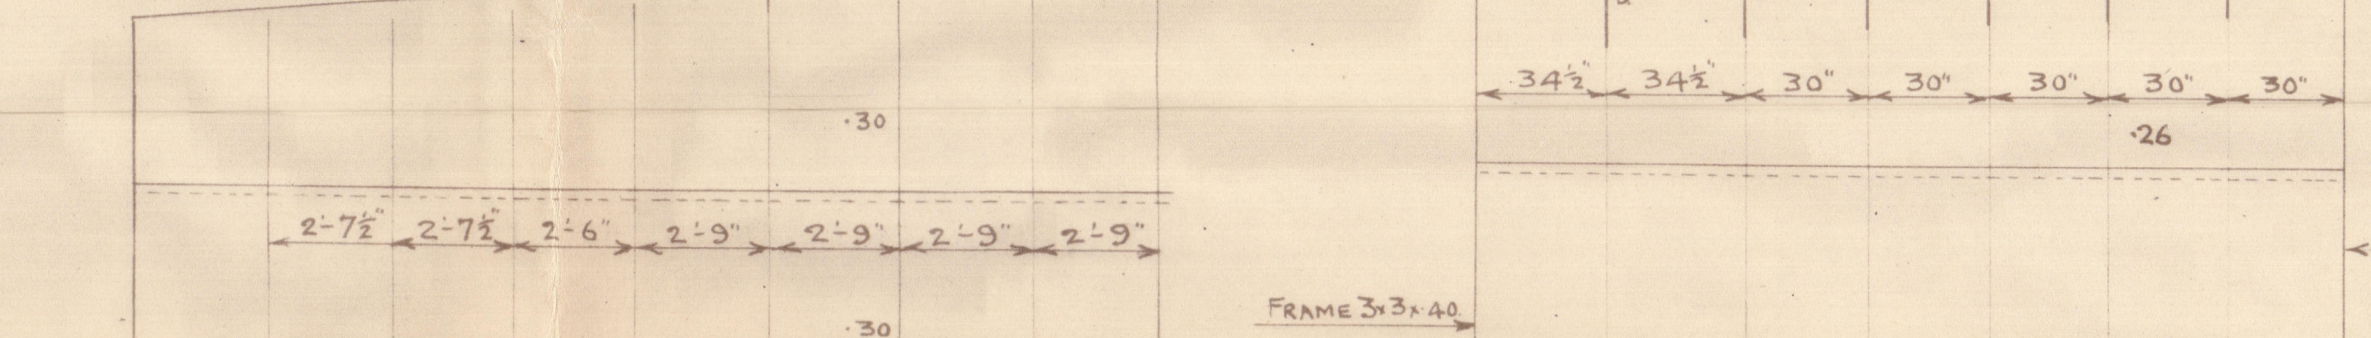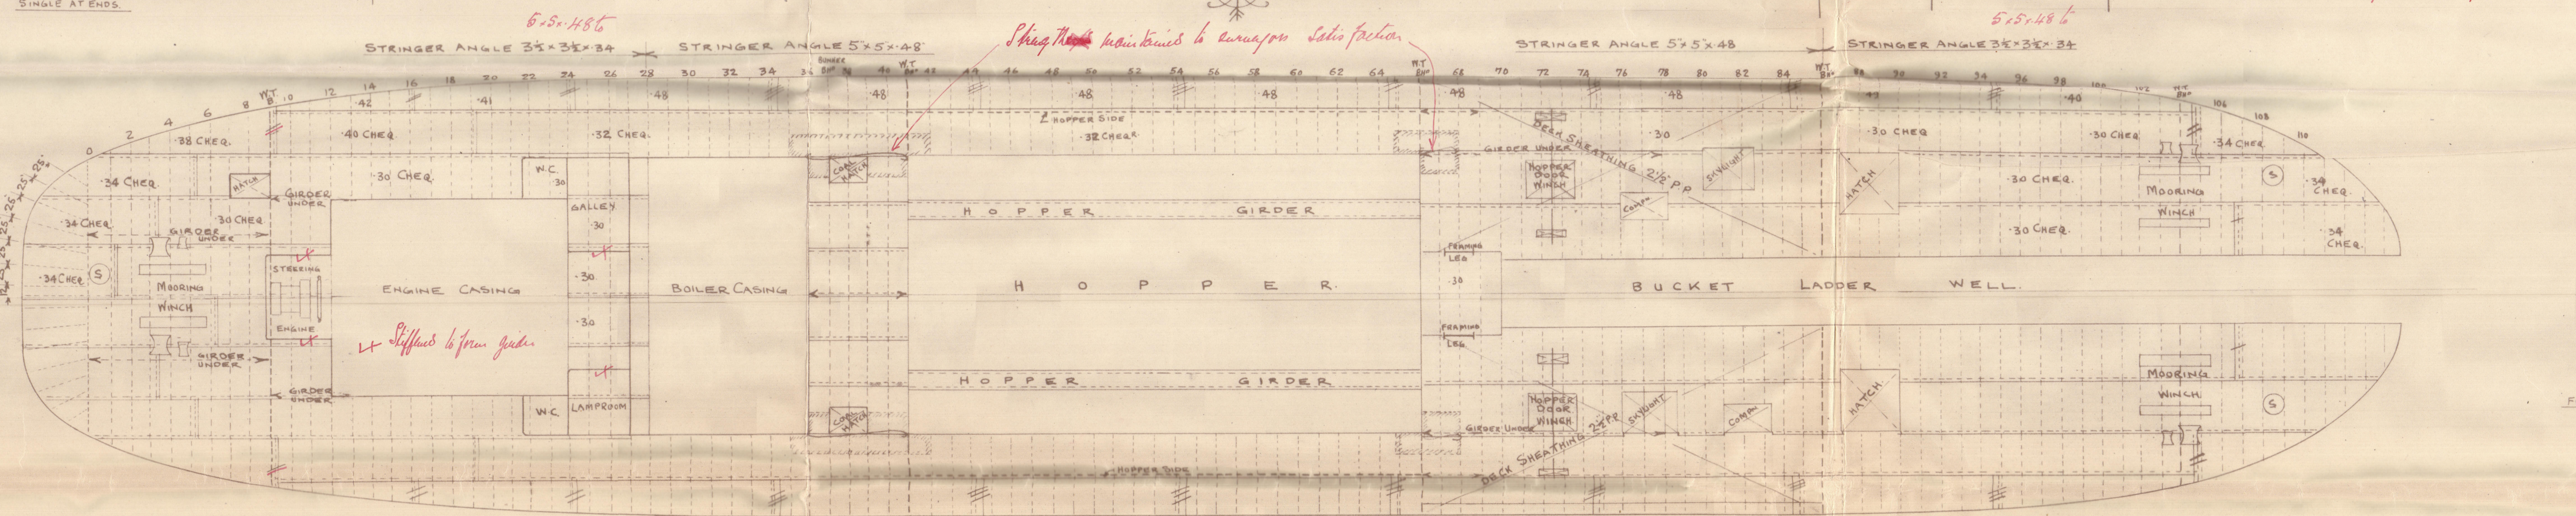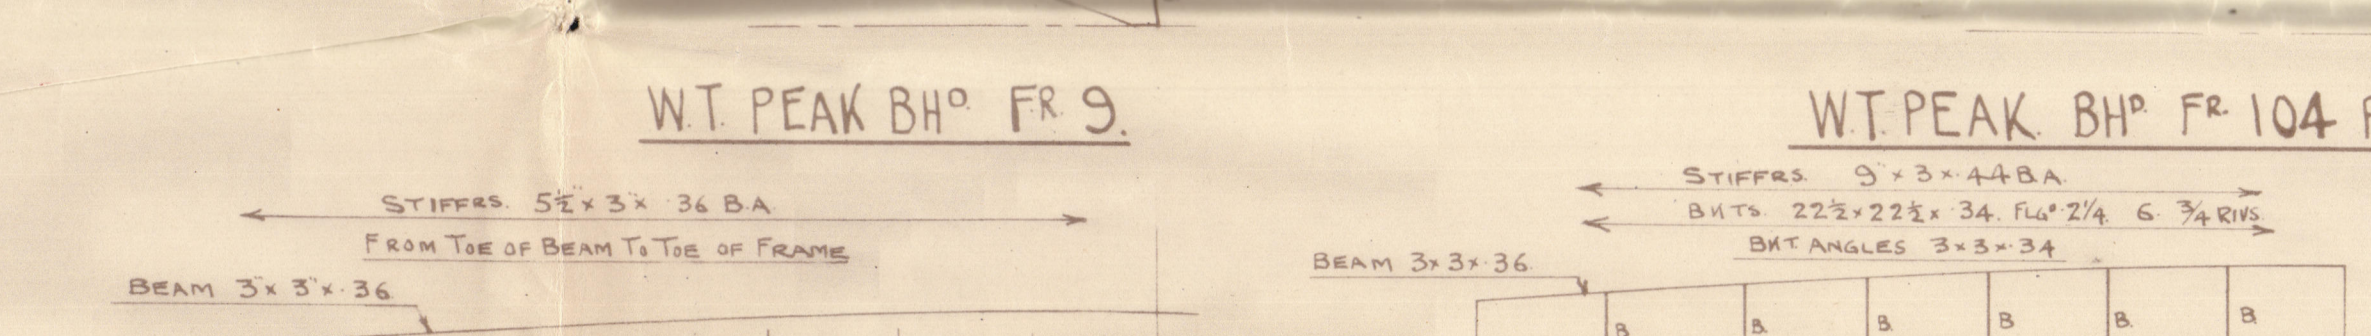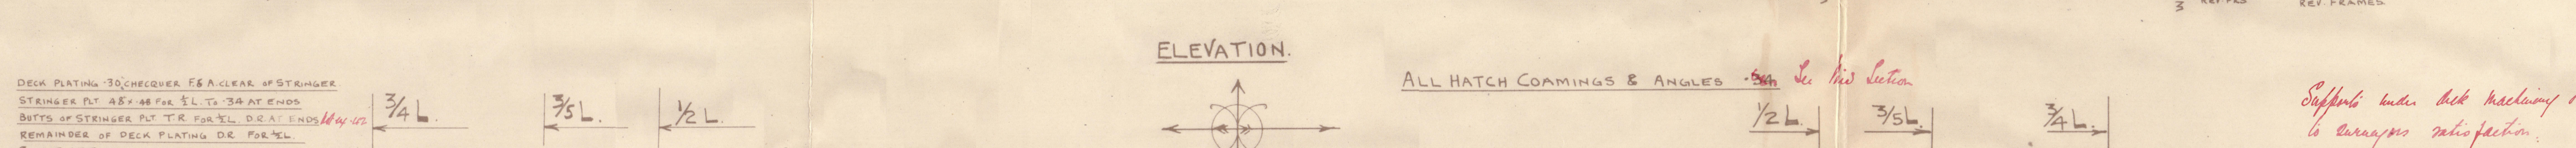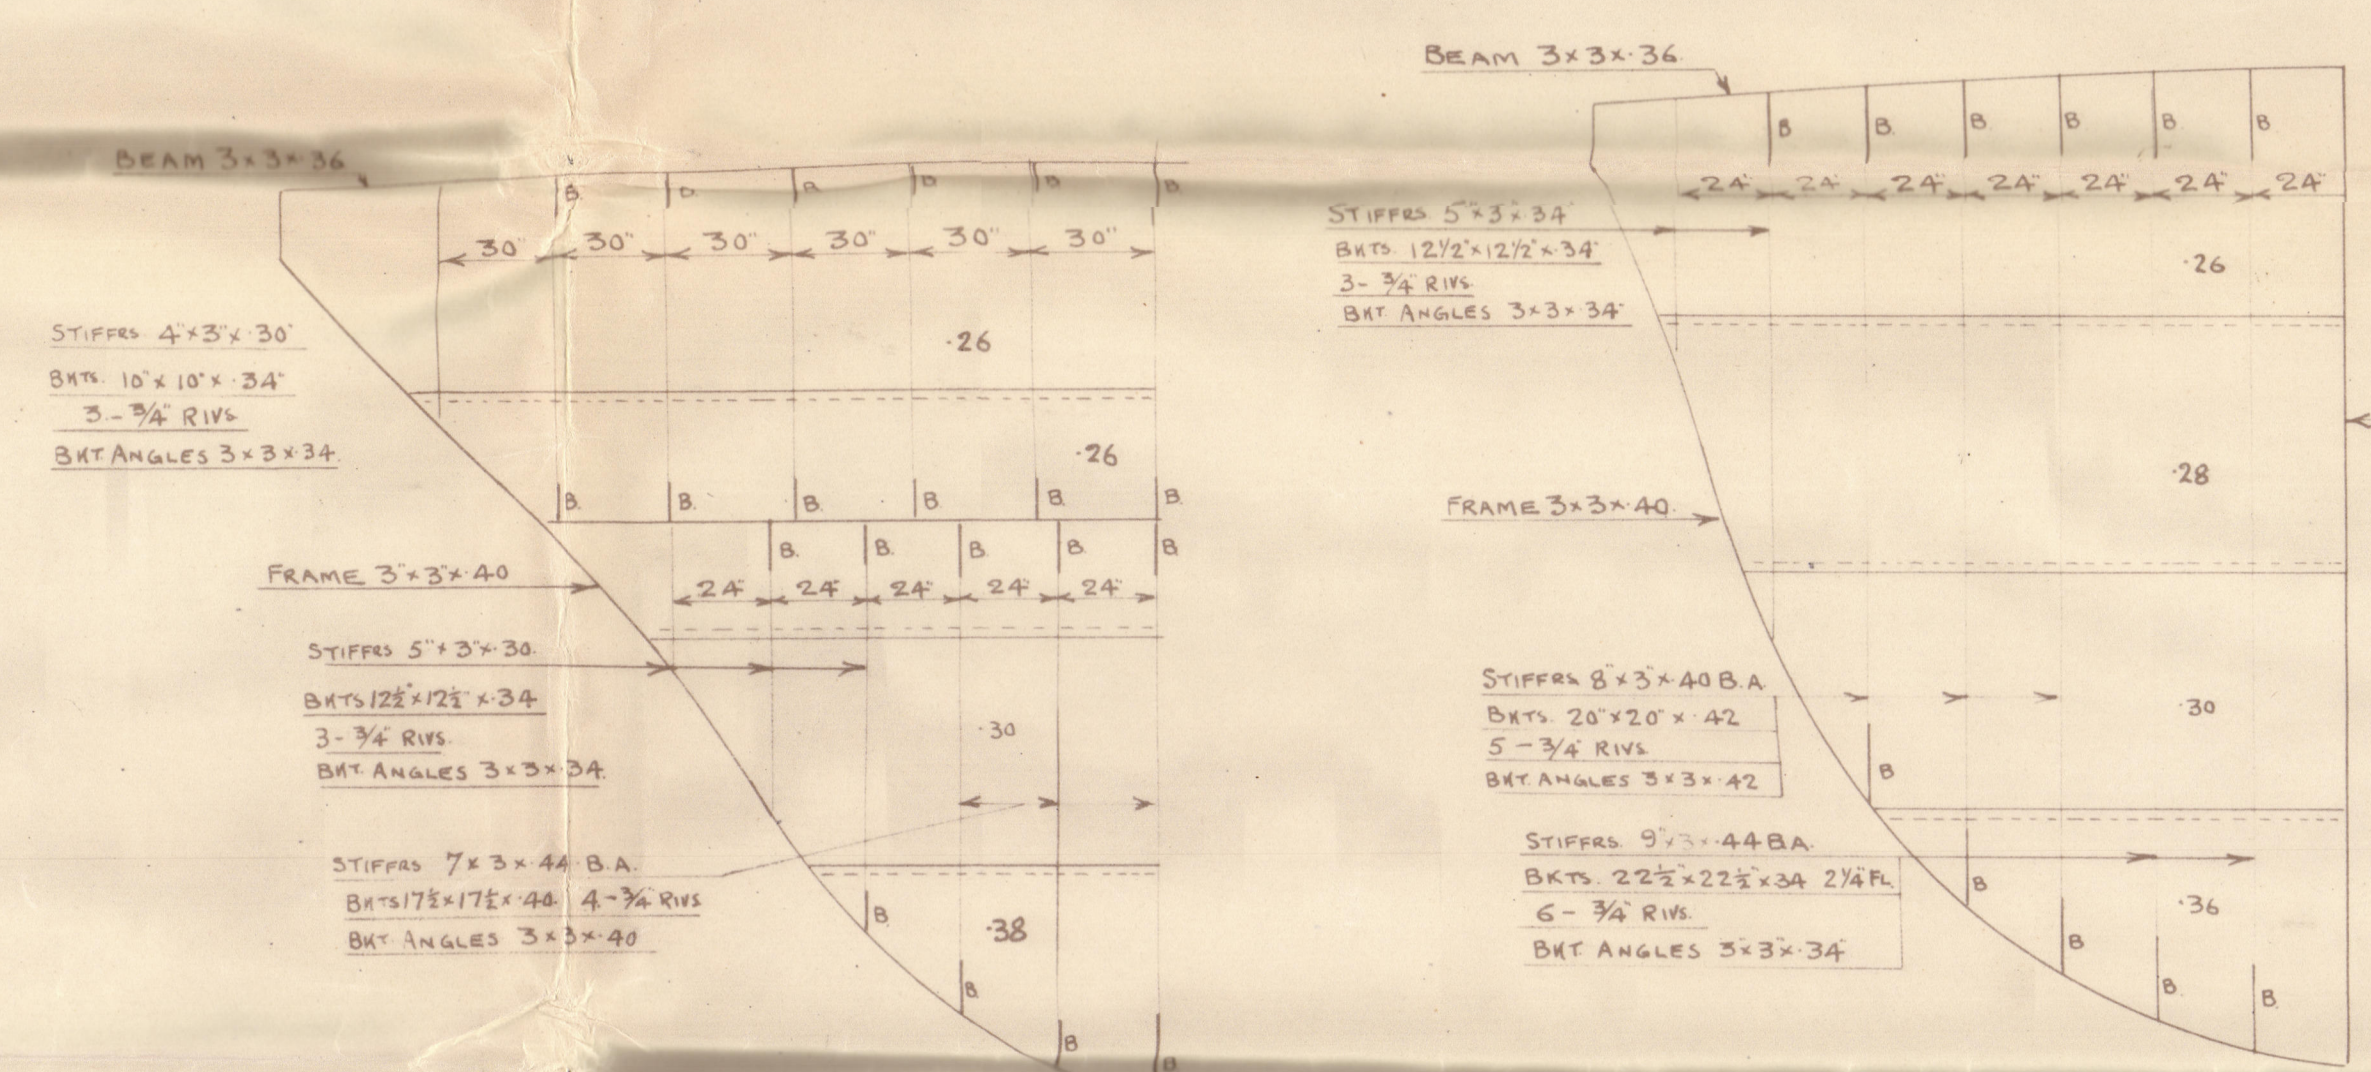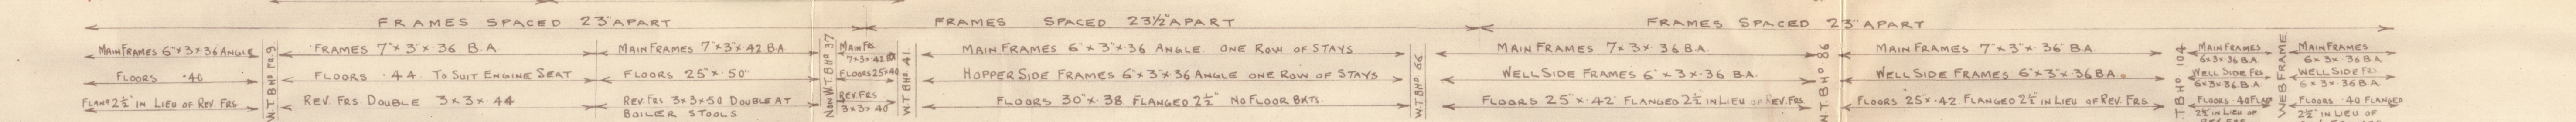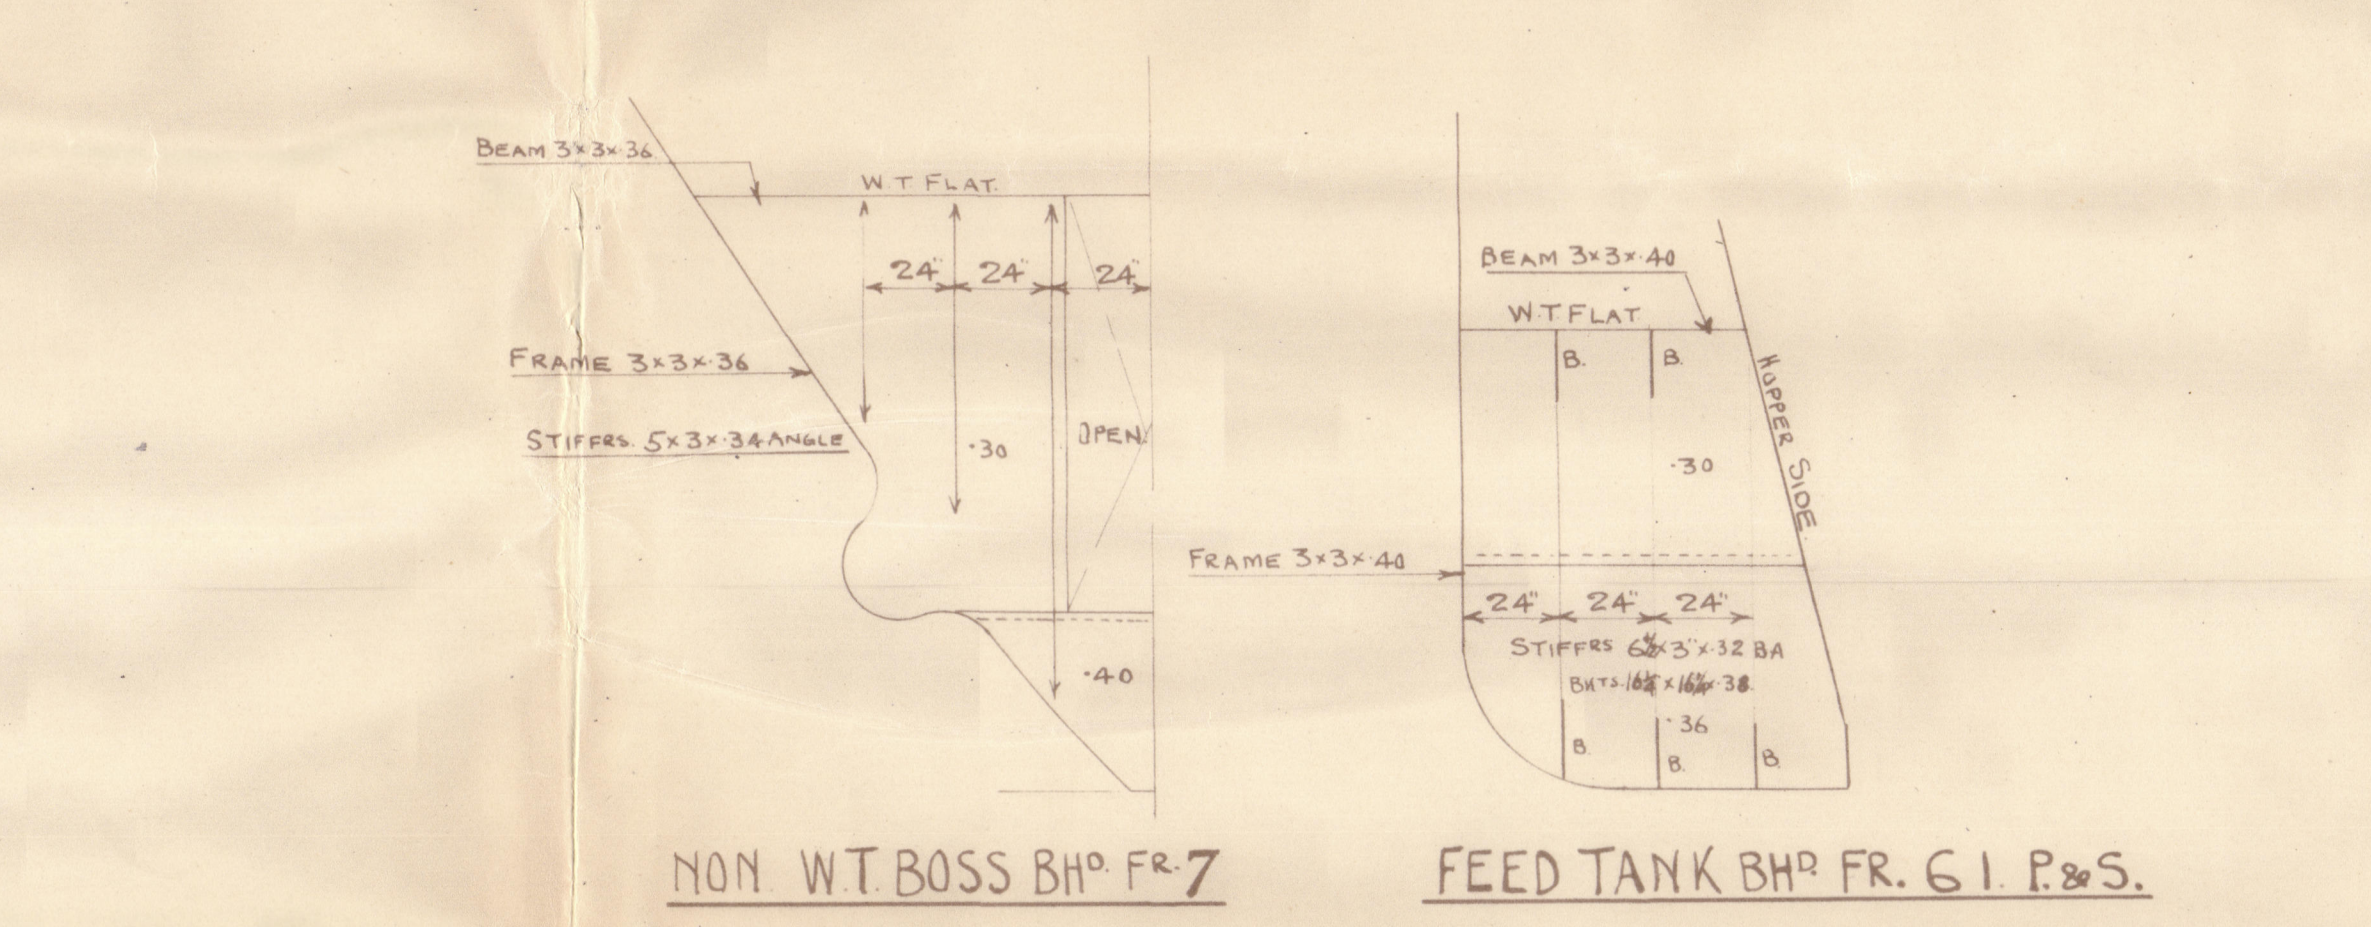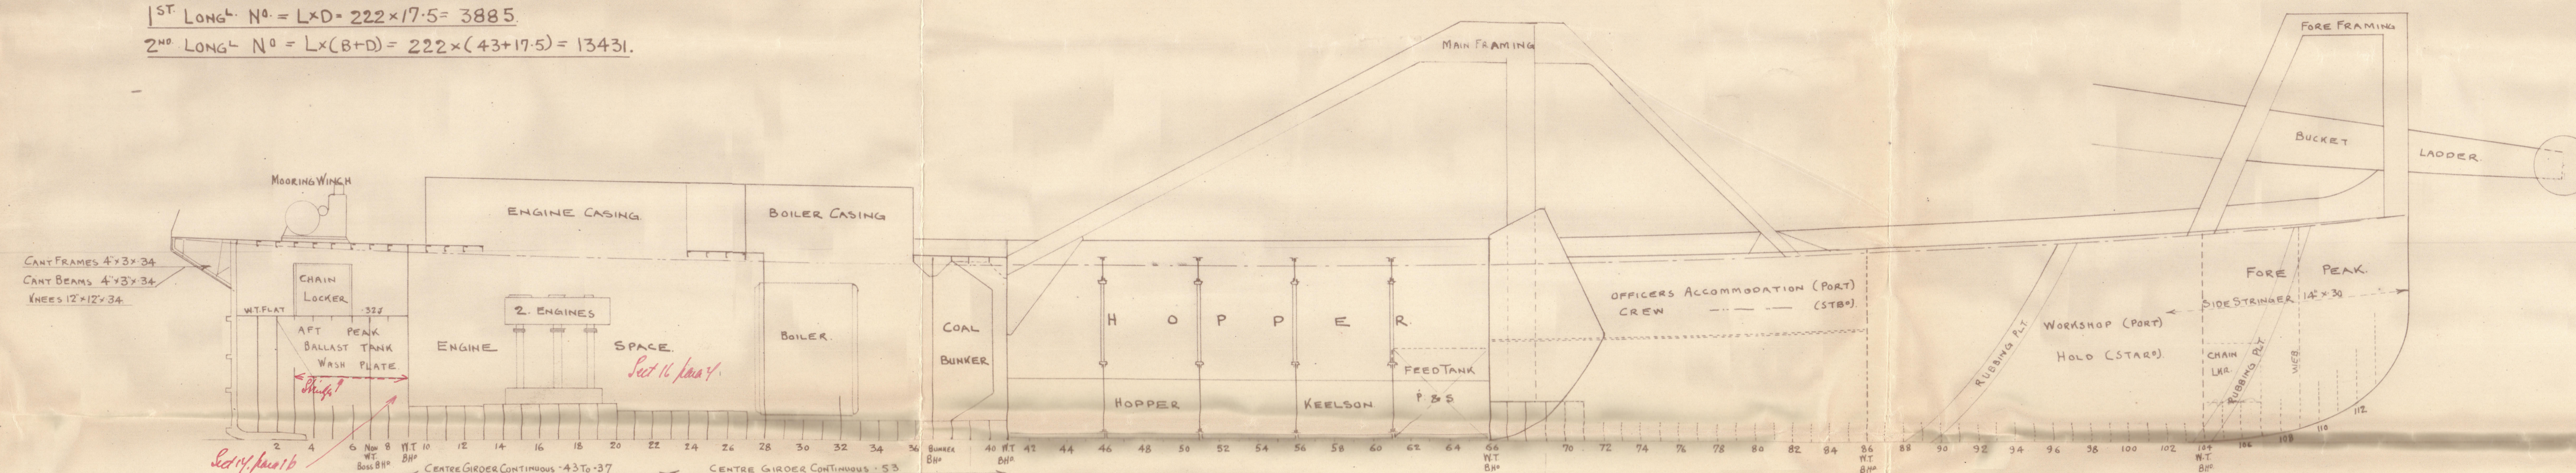

APPROVED  
LLOYDS REGISTER OF SHIPPING  
MANAGEMENT BY STELLI  
DATE 9.1.15

FERGUSON BROS.  
SHIPBUILDERS & ENGINEERS  
PORT-GLASGOW



Sirgusson Ben (Pist. flaryou)

Sw. A. Kupper Dredger.

"PIEL"

N. 280.

Profile & Deck plan.

Gen. Rep. N. 18664.

009610-009620-0017



© 2021

Lloyd's Register  
Foundation