

5-1-15.

MIDSHIP SECTION

STEEL SCREW TRAWLERS


N^{OS} 640-1-2

DIMS 140'0" B.P. x 24'0" MLD x 13'6" MLD

SCALE 1/2 INCH

TO CLASS 100 A.I. STEAM TRAWLER

DECK PLATED OVER IN WAY OF MACHINERY SPACE
E & B CASING AS PREVIOUSLY APPROVED

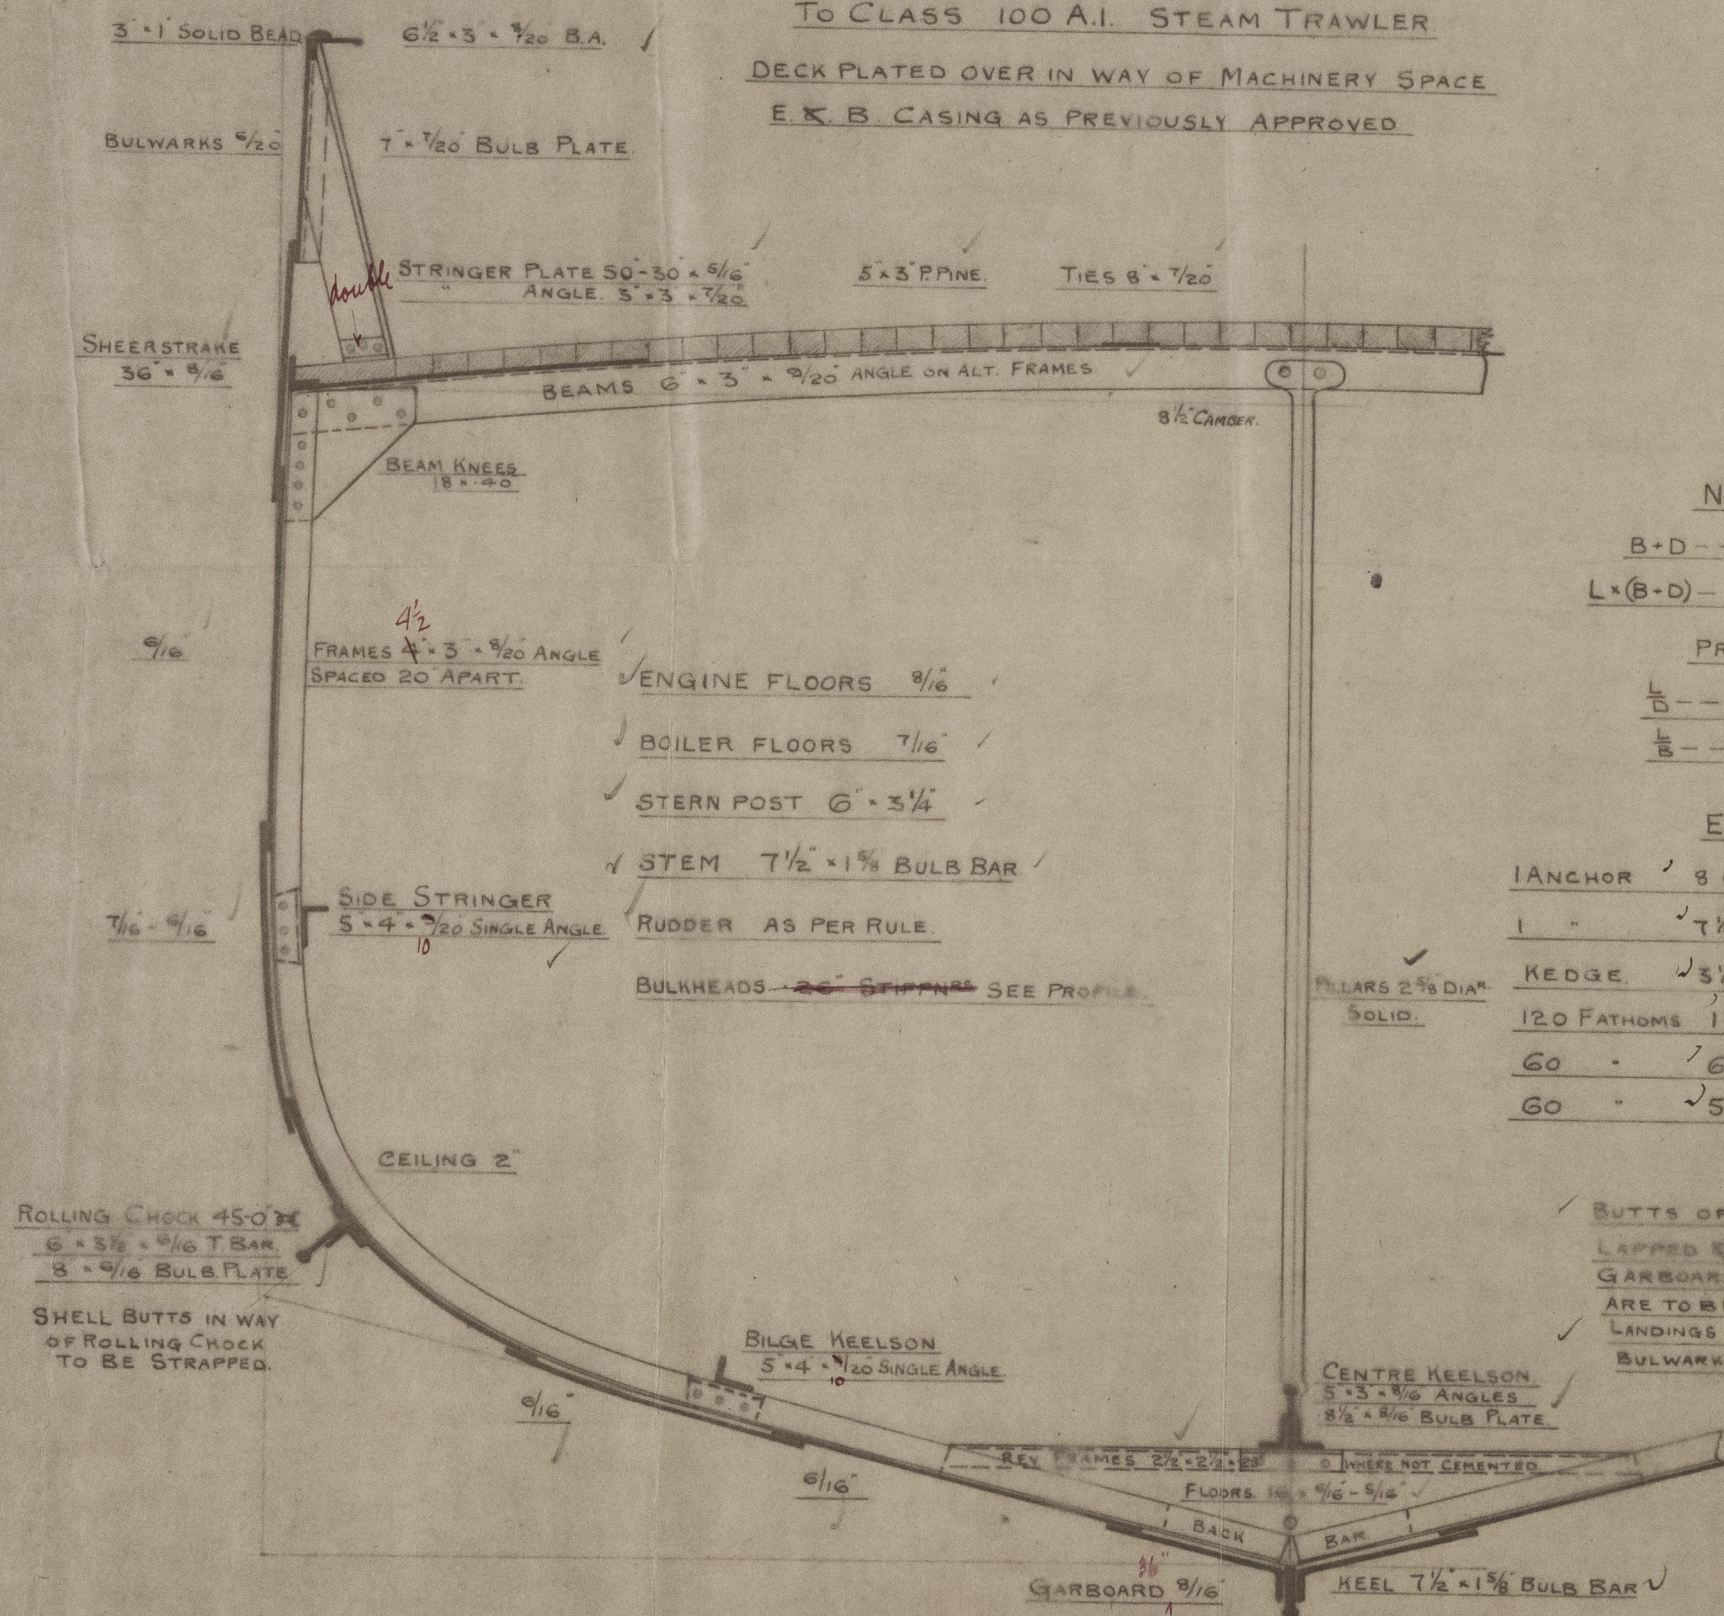

PLAN No. 5098

FOR ENCLOSURE TO

MESSRS. LLOYDS SURVEYOR.

HULL FROM

COCHRANE & SONS, LTD.

SHIPBUILDERS, SELBY

DATE 3/12/14

NUMERALS

B+D --- 37.5

L x (B+D) --- 5250.0

PROPORTIONS

L/D --- 10.37

L/B --- 5.83

EQUIPMENT

1 ANCHOR 8 CWTs STOCKLESS

1 " 7 1/4 " "

KEDGE 3 1/4 " EX STOCK

120 FATHOMS 1 1/8" STUD LINK CABLE

60 " 1 1/2" HAWSER

60 " 1 1/2" WARP

RIVETING

BUTTS OF SHELL PLATING TO BE

LAPPED & DOUBLE RIVETED EXCEPT

GARBOARD & SHEERSTRAKE WHICH

ARE TO BE STRAPPED.

LANDINGS DOUBLE RIVETED.

BULWARKS SINGLE RIVETED.


5-1-15




© 2021

Lloyd's Register Foundation


009621-009630-0173

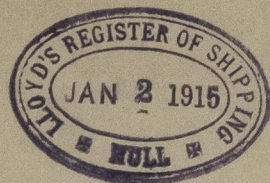

Cochrane, *See No 640-12642.*

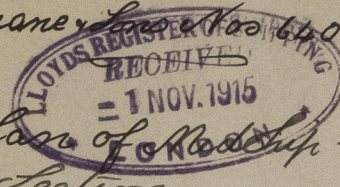

Plans of Red Ship - Section.

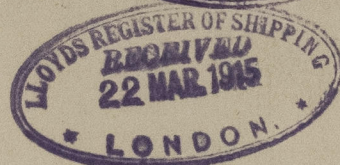


S. L. Willoughby Hull Rpt. No 28838

S. L. Corrie Roy Hull Rpt. No 28910

(S. L. Grand Duke) Hull Rpt. No 28911

NN KASOS

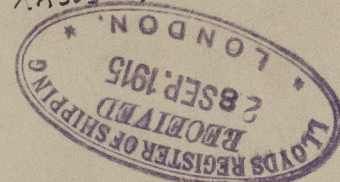

*Plans Transferred
To Kasos
Di. 333*

009621-009630-0173

S. S. No. _____
PLAN _____