

2.9.10

# MIDSHIP SECTION

Nº 475.


STEEL SCREW TRAWLER.

DIMS 130'-0" x 22'-6" x 12'-9" M.L.D

SCALE 1/2" = ONE FOOT.

TO CLASS 100. A1. AT LLOYDS FOR FISHING PURPOSES. DECK PLATED OVER IN  
WAY OF MACHINERY SPACE. ENGINE & BOILER CASING AS PREVIOUSLY APPROVED

9576  
Messrs Lloyd's Surveyors  
Suez  
20/8/10 RB

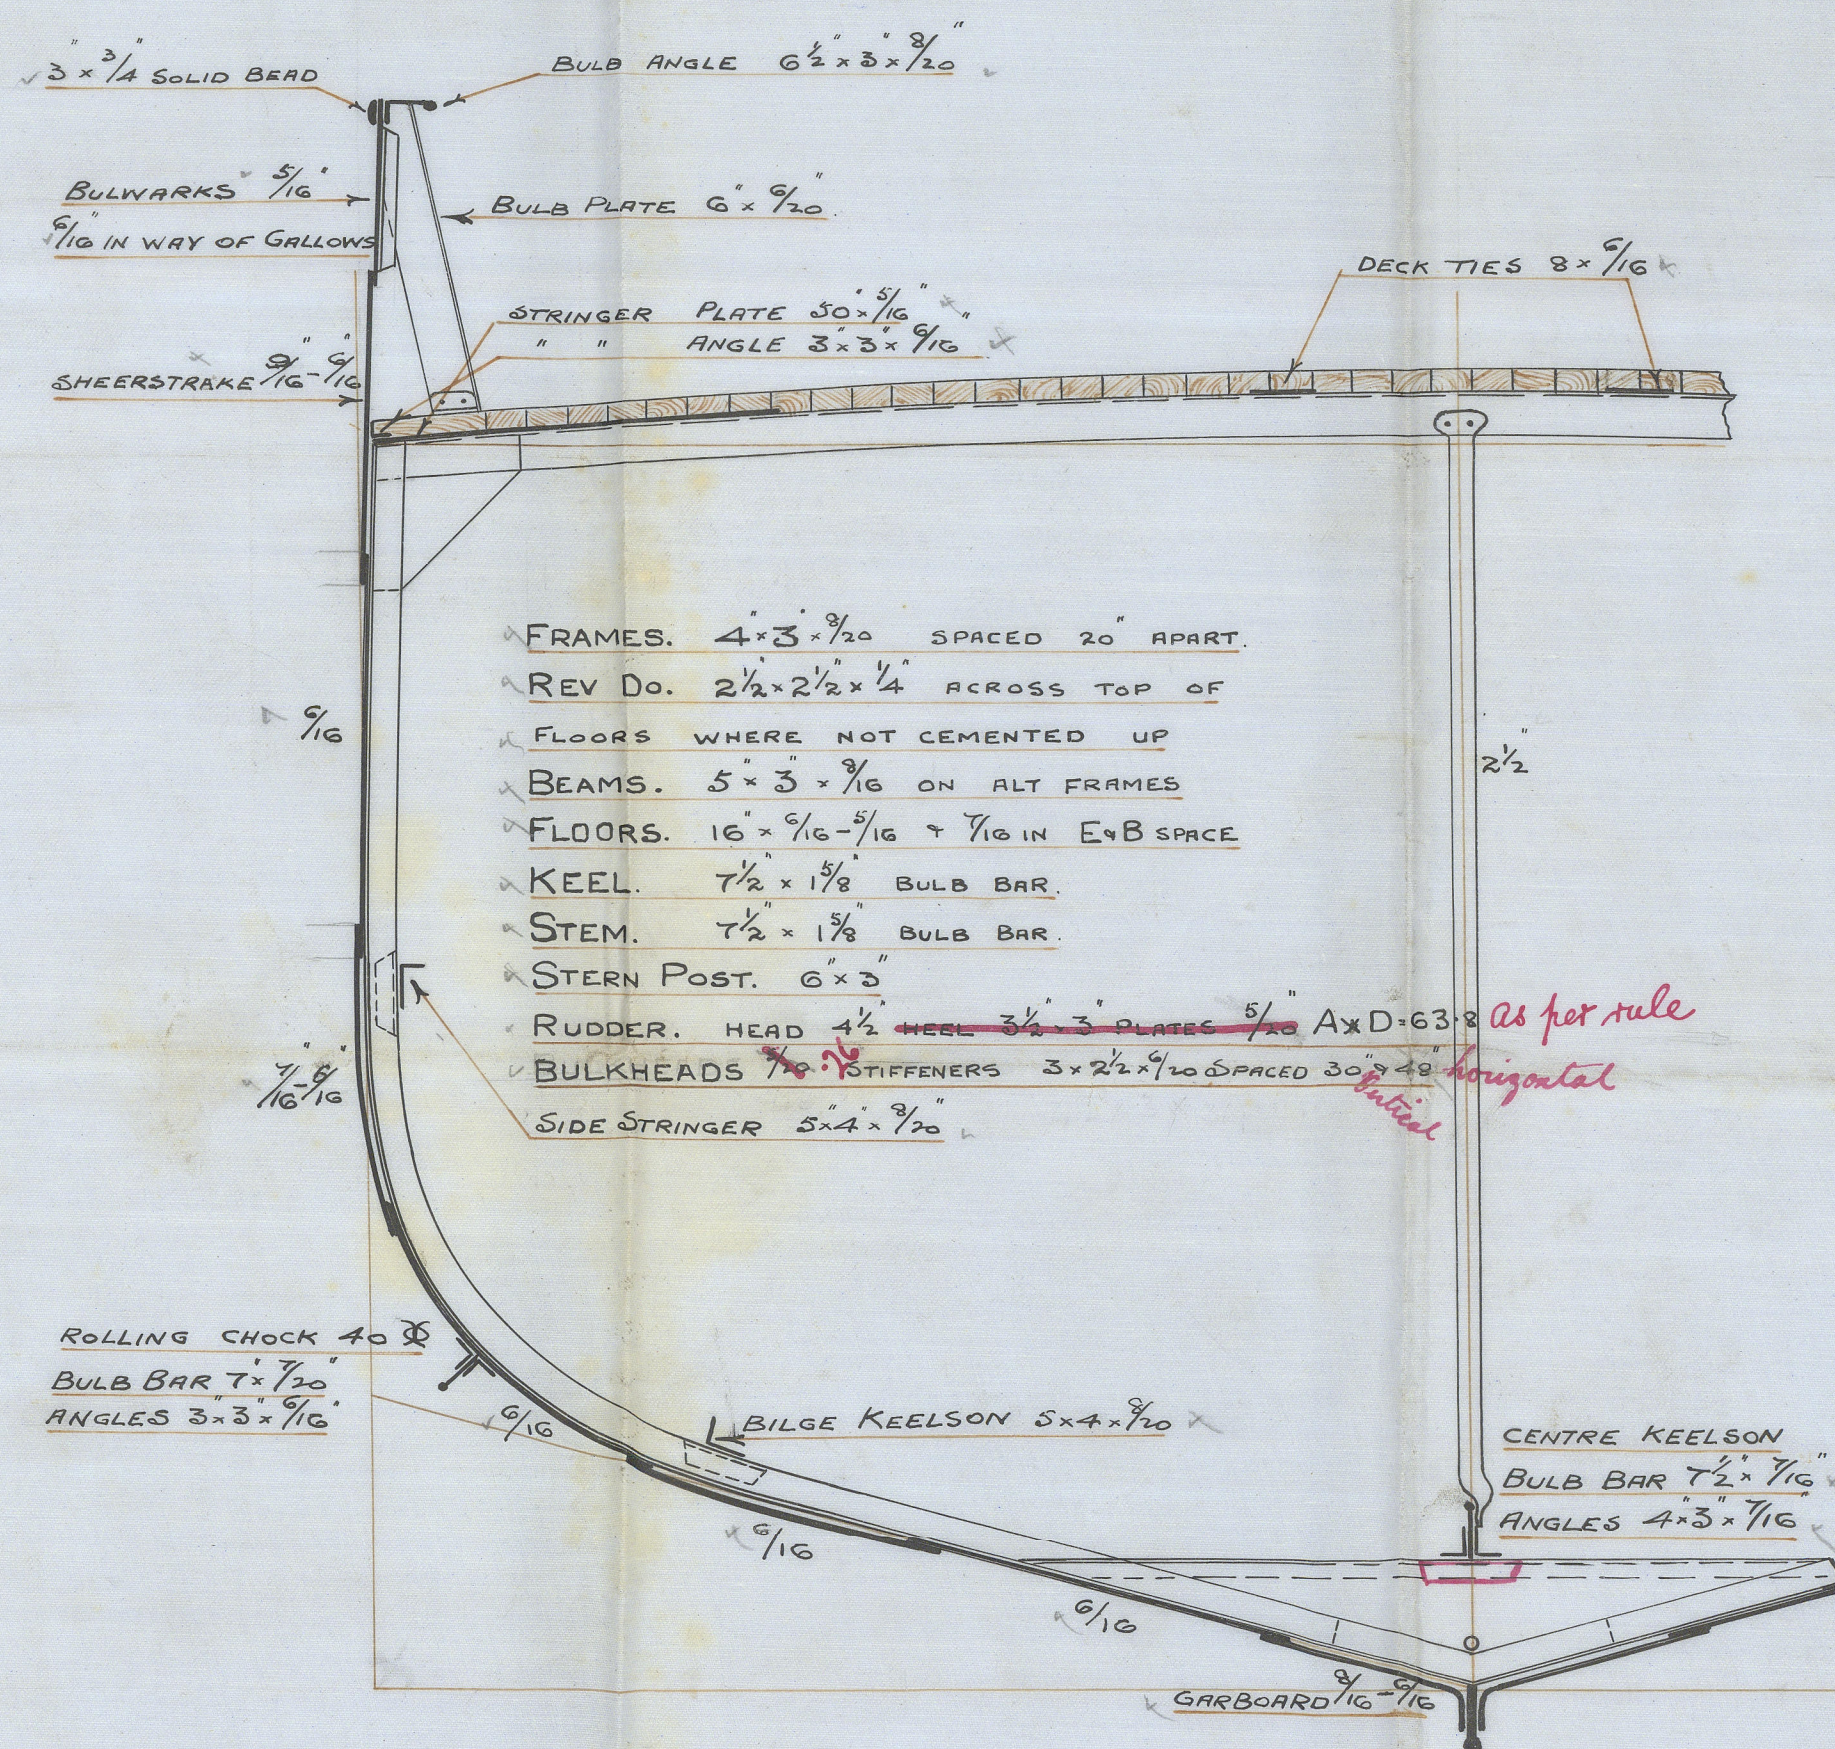

## NUMERALS.

$$B + D \times 35.12$$

$$L \times (B + D) = 4565.60$$

## PROPORTIONS.

$$\frac{L}{D} = 10.19$$

$$\frac{L}{B} = 5.81$$

## EQUIPMENT

1 <sup>ST</sup> BOWER ANCHOR	5 3/4 CWTs EX STOCK.
2 <sup>ND</sup> " "	5 1/4 " " "
KEDGE ANCHOR	3 " " "
105 FATHOMS	1 1/6 CABLE
60 " "	6 " HAWSER
60 " "	5 " WARP

## RIVETING.

- BUTTS OF SHELL PLATING LAPPED & DOUBLE RIVETED
- EXCEPT GARBOARD & SHEERSTRAKE WHICH ARE TO BE
- STRAPPED & DOUBLE RIVETED, LANDINGS DOUBLE RIVETED
- BULWARKS SINGLE RIVETED.

answ.  
31-8-10

C.F.  
2.9.10



MIDSHIP SECTION

COCHRANE & SONS

No 445

s/s Wallington

Still Rpt In 23432



© 2021

Lloyd's Register  
Foundation

009621-009630-0182