
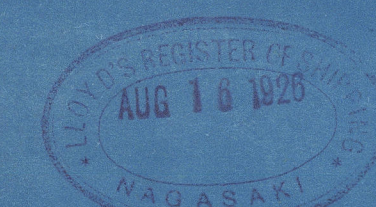


# M.S. "MONTEVIDEO-MARU".

## STERN FRAME & CUT UP.

SCALE  $\frac{1}{2}$  INCH TO ONE FOOT.  
SCALE 1 INCH TO ONE FOOT. (DETAIL)

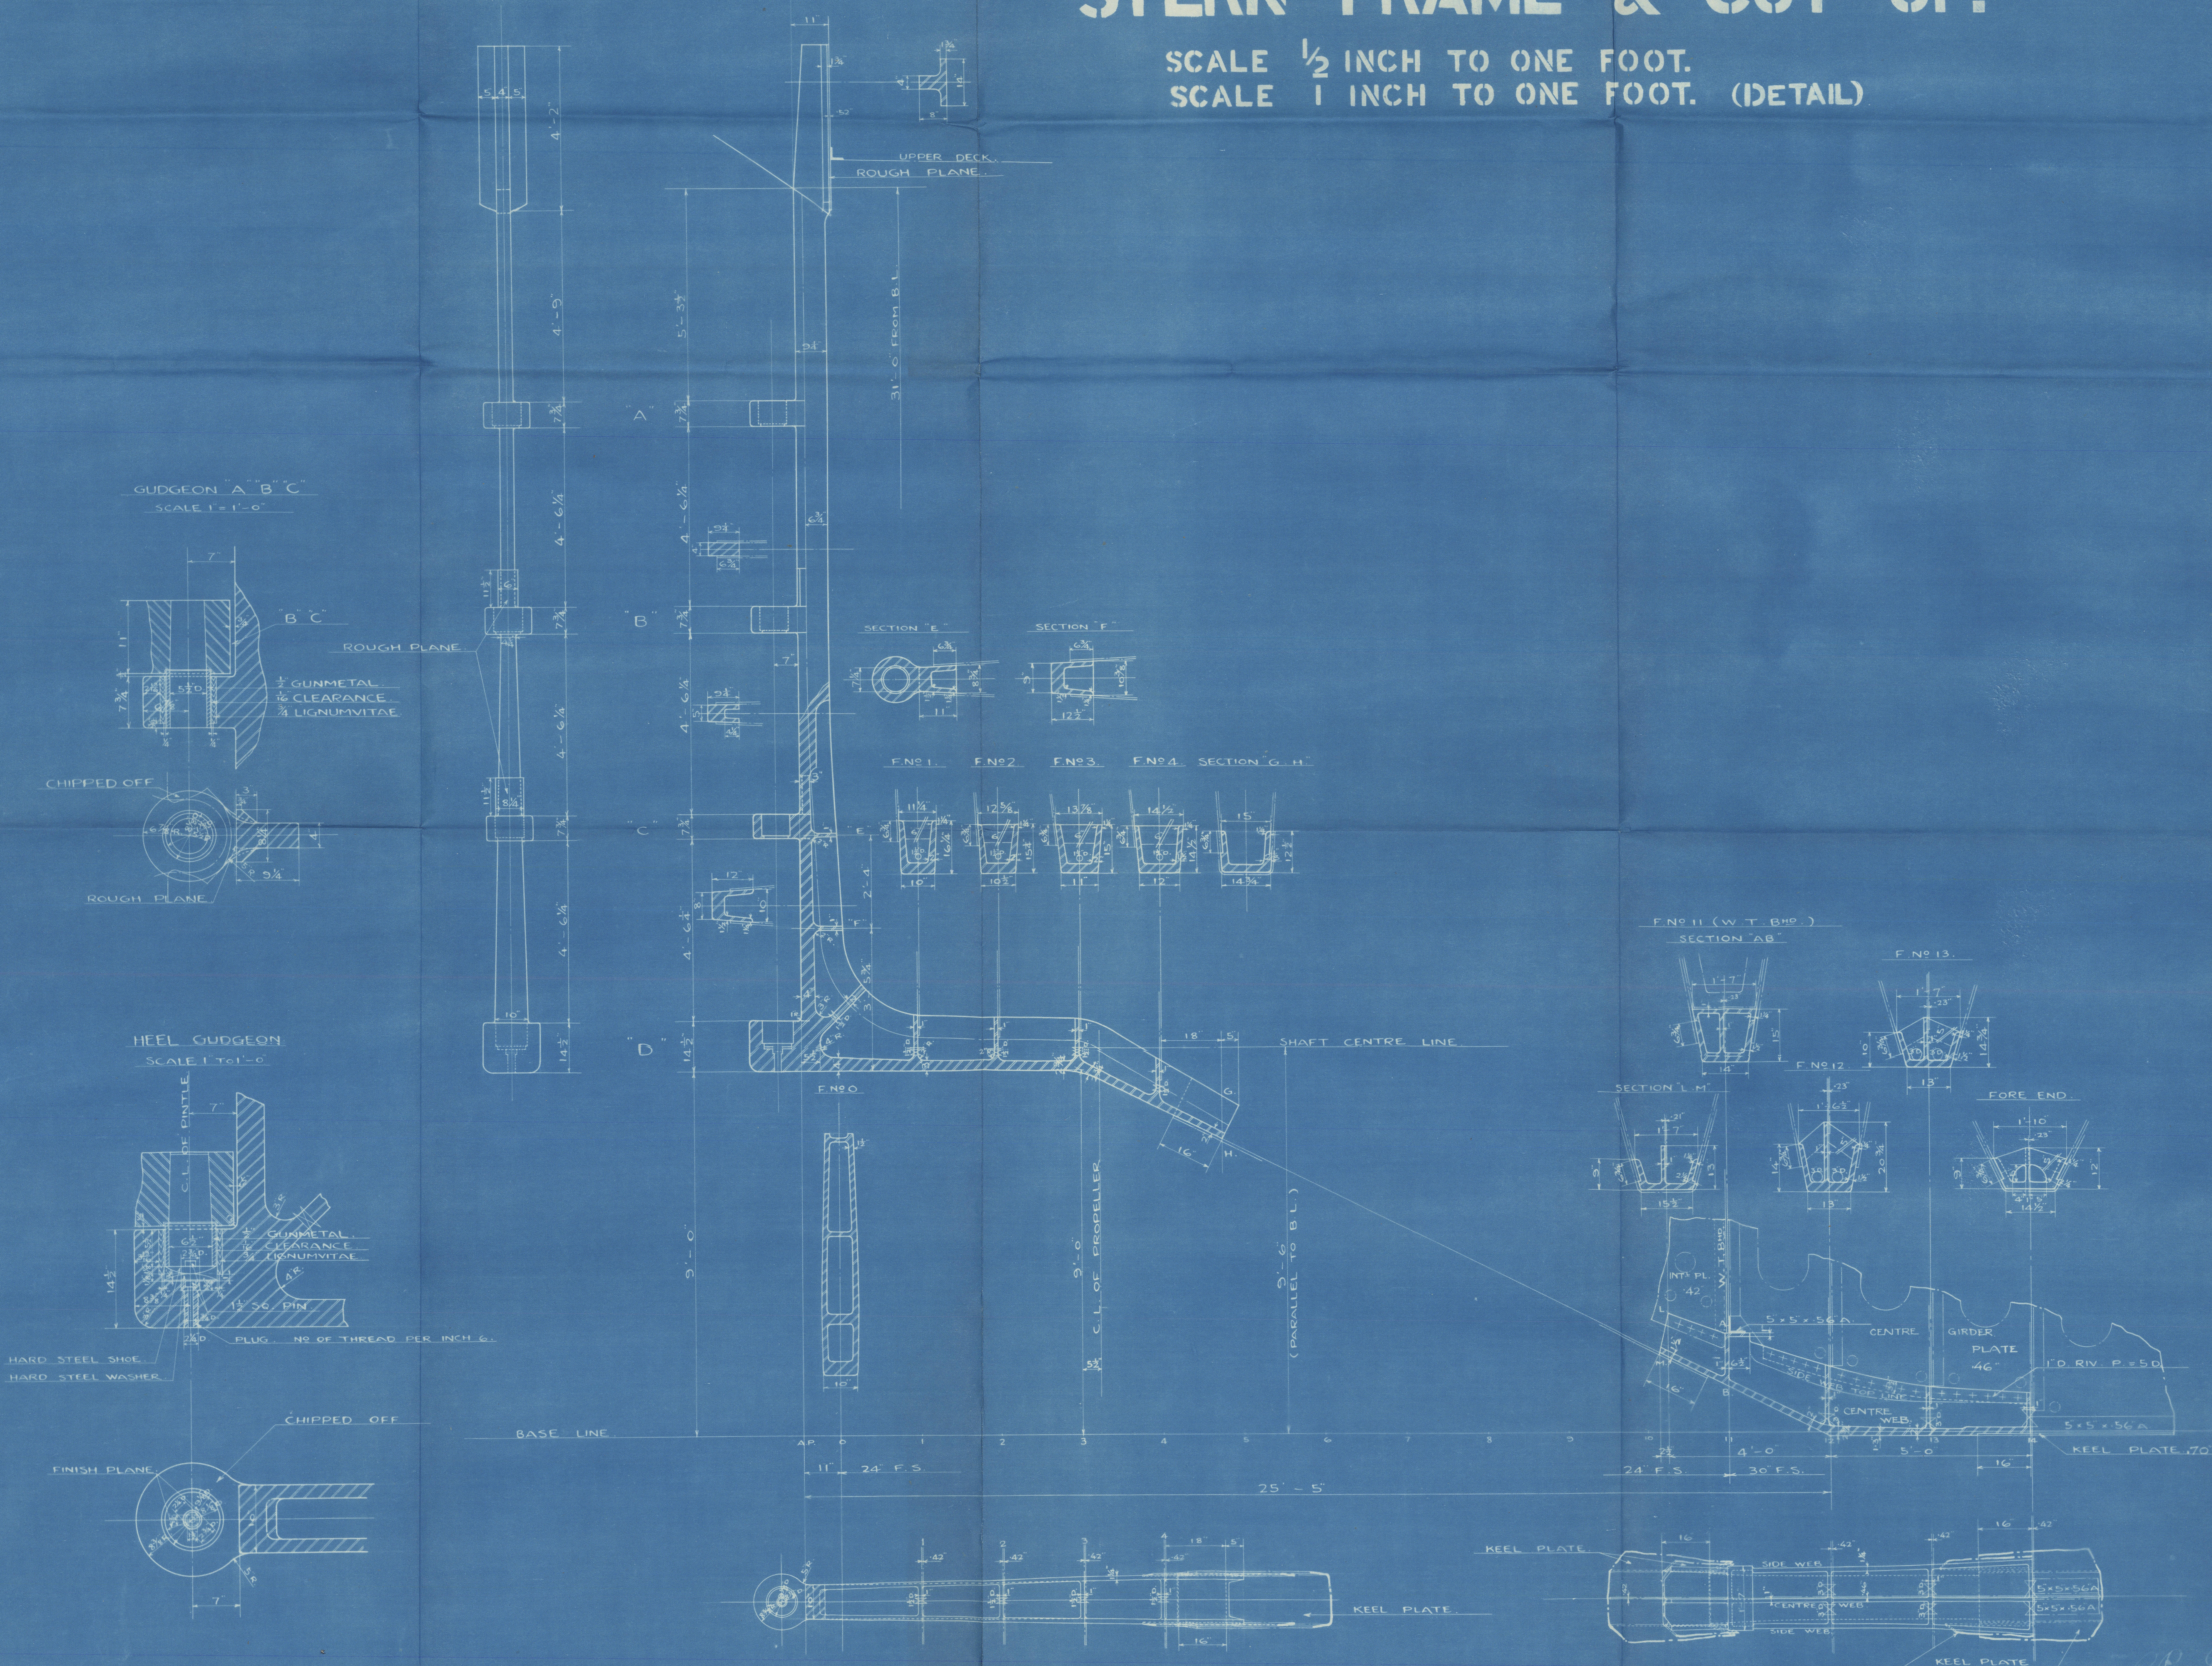

*Resawford*

M.S. "MONTEVIDEO-MARU".  
STERN FRAME & CUT UP.  
(FINISHED PLAN).  
SCALE  $\frac{1}{2}$  & 1 TO 1 FOOT.

